

OXNARD UNION HIGH SCHOOL DISTRICT ADOLFO CAMARILLO HIGH SCHOOL SITE SECURITY IMPROVEMENTS

4660 MISSION OAKS BLVD, CAMARILLO, CA 93012

GENERAL NOTES

1. ANY DIFFERENCE BETWEEN THE EXISTING CONSTRUCTION AS OBSERVED IN THE FIELD AND AS SHOWN ON THE DRAWINGS SHALL BE REPORTED TO THE ARCHITECT BEFORE PROCEEDING WITH THE WORK.
2. THE CONTRACTOR SHALL VERIFY ALL DIMENSIONS PRIOR TO STARTING WORK THE ARCHITECT SHALL BE NOTIFIED OF ANY DISCREPANCIES OR INCONSISTENCIES. THE CONTRACTOR IS RESPONSIBLE FOR CHECKING AND COORDINATING ALL DIMENSIONS. REVIEW BUILDING LAYOUT WITH ARCHITECT BEFORE STARTING ANY FOOTING EXCAVATION OR FOUNDATION WORK.
3. THE CONTRACTOR IS RESPONSIBLE FOR VERIFYING ACTUAL SITE CONDITIONS REGARDLESS OF INFORMATION SHOWN ON THE DRAWINGS. DISCREPANCIES BETWEEN CONDITIONS SHOWN OR NOT SHOWN ON DRAWINGS AND ACTUAL EXISTING VISIBLE, DISCERNABLE CONDITIONS AT THE JOB SITE, DO NOT RELIEVE THE CONTRACTOR FROM PERFORMING THE WORK OF THIS CONTRACT IN FULL CONFORMANCE WITH THE CONTRACT DOCUMENTS.
4. IT SHALL BE THE RESPONSIBILITY OF THE GENERAL CONTRACTOR TO INSURE THAT ALL APPLICABLE SAFETY LAWS ARE STRICTLY ENFORCED AND TO MAINTAIN A SAFE CONSTRUCTION PROJECT.
5. BIDDERS MUST VISIT THE BUILDING SITE AND FAMILIARIZE THEMSELVES WITH EXISTING CONDITIONS. THE INTENT OF THESE DRAWINGS AND SPECIFICATIONS IS TO PROVIDE A PROJECT COMPLETE IN EVERY DETAIL AND READY FOR OCCUPANCY. DISCREPANCIES OR DELETIONS MUST BE BROUGHT TO THE ATTENTION OF THE ARCHITECT BEFORE THE BID DATE FOR CORRECTION.
6. ANY DAMAGE DONE TO THE EXISTING SITE OR FACILITIES DURING THE COURSE OF THE WORK SHALL BE REPAIRED OR REPLACED BY THE CONTRACTOR AT HIS OWN EXPENSE WITH NO ADDITIONAL COST TO THE DISTRICT.
7. BIDDERS SHALL ASSUME THAT ALL ITEMS INDICATED ON THE DRAWINGS ARE NEW CONSTRUCTION IF NOT INDICATED WITH AN (N) OR "NEW", UNLESS INDICATED AS "(E)" OR "EXISTING".
8. ALL NEW WORK SHALL MATCH EXISTING IN KEEPING WITH GOOD CONSTRUCTION PRACTICE. IT IS THE INTENT OF THESE DOCUMENTS THAT THE PORTION OF THE SURFACE WHICH HAS BEEN INSTALLED, REPAIRED OR REPLACED, SHALL MATCH THE EXISTING ADJACENT SURFACES, AND THAT THE NEW WORK WILL NOT BE DISCERNABLE FROM THE EXISTING.
9. WHERE MINIMUM DIMENSIONS ARE INDICATED, EXISTING DIMENSIONS IN EXCESS OF THAT SHOWN MAY BE RETAINED UNLESS OTHERWISE NOTED.
10. CONTRACTOR SHALL NOTIFY THE ARCHITECT IMMEDIATELY OF ALL OMISSIONS AND CONFLICTS BETWEEN THE ELEMENTS OF THE CONTRACT DOCUMENTS BEFORE PROCEEDING WITH THE WORK INVOLVED.
11. CONTRACTOR SHALL PROTECT ALL EXISTING STRUCTURAL, MECHANICAL, PLUMBING, ELECTRICAL, LANDSCAPE SITE FEATURES TO REMAIN. ALL DAMAGED WORK SHALL BE REPLACED WITH THE SAME MATERIALS, INCLUDING MATCHING THE EXISTING COLORS AND TEXTURES BY THE CONTRACTOR AT HIS OWN EXPENSE WITH NO ADDITIONAL COST TO THE DISTRICT.
12. ALL WORK SHALL CONFORM TO TITLE 24, CALIFORNIA CODE OF REGULATIONS (CCR).

GENERAL REQUIREMENTS:

1. A 'DSA CERTIFIED' PROJECT INSPECTOR EMPLOYED BY THE DISTRICT (OWNER) AND APPROVED BY THE DIVISION OF THE STATE ARCHITECT SHALL PROVIDE CONTINUOUS INSPECTION OF THE WORK. THE DUTIES OF THE INSPECTOR ARE DEFINED IN SECTION 4-342, CALIFORNIA BUILDING STANDARDS ADMINISTRATIVE CODE (PART 1, TITLE 24, CCR).
2. A 'DSA CERTIFIED' INSPECTOR WITH CLASS 3 CERTIFICATION IS REQUIRED FOR THIS PROJECT.

APPLICABLE CODES

CONSTRUCTION SHALL COMPLY WITH THE FOLLOWING:

PART 1	2016 CALIFORNIA ADMINISTRATIVE CODE (CAC), TITLE 24 C.C.R.
PART 2	2016 CALIFORNIA BUILDING CODE (CBC), TITLE 24 C.C.R.
PART 3	2016 CALIFORNIA ELECTRICAL CODE (CEC), TITLE 24 C.C.R.
PART 4	2016 CALIFORNIA MECHANICAL CODE (CMC), TITLE 24 C.C.R.
PART 5	2016 CALIFORNIA PLUMBING CODE (CPC), TITLE 24 C.C.R.
PART 6	2016 CALIFORNIA ENERGY CODE, TITLE 24 C.C.R.
PART 8	2016 CALIFORNIA HISTORICAL BUILDING CODE, TITLE 24 C.C.R.
PART 9	2016 CALIFORNIA FIRE CODE (FC), TITLE 24, C.C.R.
PART 10	2016 CALIFORNIA EXISTING BUILDING CODE (CEBC), TITLE 24, C.C.R.
PART 11	2016 CALIFORNIA GREEN BUILDING STANDARDS CODE (CALGREEN), TITLE 24, C.C.R.
PART 12	2016 CALIFORNIA REFERENCED STANDARDS CODE, TITLE 24, C.C.R.

PARTIAL LIST OF APPLICABLE STANDARDS:

NFPA 13 AUTOMATIC SPRINKLER SYSTEMS (CALIFORNIA AMENDED)	2016 EDITION
NFPA 14 STANDPIPE SYSTEMS (CALIFORNIA AMENDED)	2013 EDITION
NFPA 17 DRY CHEMICAL EXTINGUISHING SYSTEMS	2013 EDITION
NFPA 17A WET CHEMICAL EXTINGUISHING SYSTEMS	2013 EDITION
NFPA 20 STATIONARY PUMPS	2016 EDITION
NFPA 24 PRIVATE FIRE SERVICE MAINS (CALIFORNIA AMENDED)	2016 EDITION
NFPA 72 NATIONAL FIRE ALARM & SIGNALING CODE (CA. AMENDED)	2016 EDITION
NFPA 80 FIRE DOOR AND OTHER OPENING PROTECTIVES	2016 EDITION
NFPA 253 CRITICAL RADIANT FLUX OF FLOOR COVERING SYSTEMS	2015 EDITION
NFPA 2001 CLEAN AGENT FIRE EXTINGUISHING SYSTEM (CA. AMENDED) 2015 EDITION	2015 EDITION

NATIONAL REFERENCE STANDARDS:


AISC SEISMIC PROVISIONS FOR STRUCTURAL STEEL BUILDINGS (ANSI/AISC 341-10)	
AISC SPECIFICATION FOR STRUCTURAL STEEL BUILDINGS (ANSI/AISC 360-10)	
NATIONAL DESIGN SPECIFICATION (NDS) FOR WOOD CONSTRUCTION (ANSI/AWS NDS 2015)	
ACI-318-14 BUILDING CODE REQUIREMENTS FOR STRUCTURAL CONCRETE	

STATE BUILDING CODE

(Part 1, Title 24, C.C.R.)

"The intent of these drawings and specification is that the work of the alteration, rehabilitation or reconstruction is to be in accordance with Title 24, California Code of Regulations. Should any existing conditions such as deterioration or noncomplying construction be discovered which is not covered by the contract documents wherein the finished work will not comply with Title 24, California Code of Regulations, a change order, or a separate set of plans and specifications, detailing and specifying the required work shall be submitted to and approved by the Division of the State Architect before proceeding with the work."

Changes to the approved drawings and specifications shall be made by an addenda or a construction change document (CCD) approved by the Division of the State Architect, as required by Section 4-338, Part 1, Title 24, CCR.

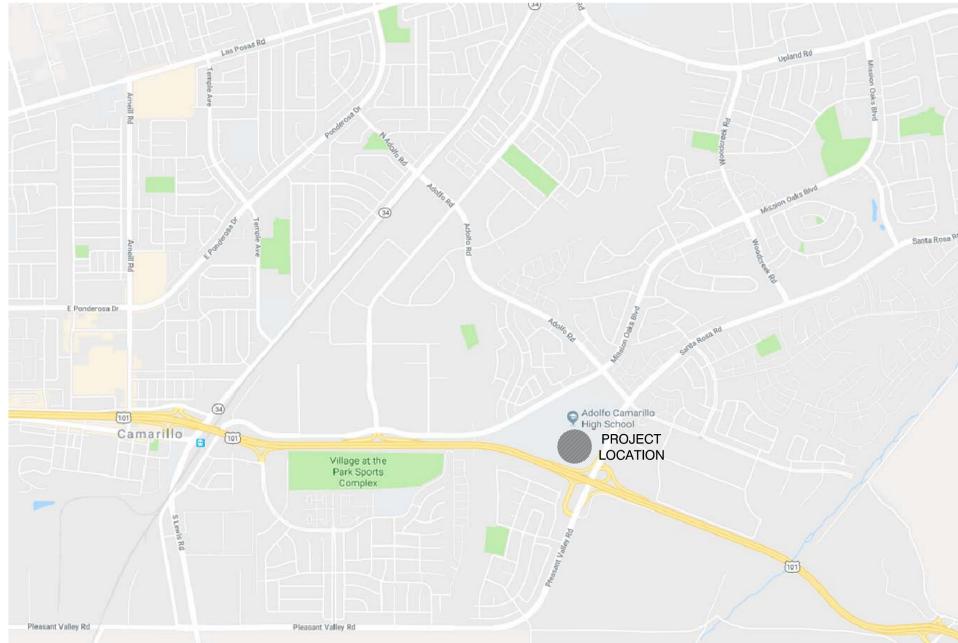

VICINITY MAP

SCALE: N.T.S.

ABBREVIATIONS

ABV	ABOVE	FG	FINISH GRADE	PLAS	PLASTIC
AFF	ABOVE FINISHED FLOOR	FIXT	FIXTURE	PLAM	PLASTIC LAMINATE
ADJ	ADJUSTABLE / ADJACENT	FLASH	FLASHING	PL	PLATE
A/C	AIR CONDITIONING	FHMS	FLATHEAD MACHINE SCREW	PLYWD	PLYWOOD
ALT	ALTERNATE	FHWS	FLATHEAD WOOD SCREW	POC	POINT OF CONNECTION
ALUM	ALUMINUM	FLR	FLOOR (ING)	PVC	POLYVINYL CHLORIDE
AB	ANCHOR BOLT	FLUOR	FLUORESCENT	PPC	POUNDS PER CUBIC FOOT
&	AND	FT	FOOT OR FEET	PSF	POUNDS PER SQUARE FOOT
<	ANGLE	FTG	FOOTING	PT	PRESSURE TREATED
&NOD	ANODIZED	FND	FOUNDATION	RAD	RADIUS
APPROX	APPROXIMATE	FURR	FURRING	REF	REFERENCE
ARCH	ARCHITECT (URAL)	GA	GAGE / GAUGE	REFR	REFRIGERATOR
ASPH	ASPHALT	GALV	GALVANIZED	REG	REGISTER
AT	ASPHALT CONCRETE	GND	GROUND	REINF	REINFORCED
⊕	AUTOMATIC	GYP	GYP-SUM	REQ'D	REQUIRED
BK	BEAM	HDW	HARDWARE	RESIL	RESILIENT
BLKG	BLOCKING	HDR	HEADER	RET	RETAINING
BD	BOARD	HVAC	HEATING VENTILATING & AIR CONDITIONING	R/A	RETURN AIR
BDT	BOTTOM	HT	HEIGHT	REV	REVISION(S) / REVISED
BN	BOUNDARY NAILING	HC	HOLLOW CORE	RH	RIGHT HAND
BLDG	BUILDING	HM	HOLLOW METAL	RD	ROOF DRAIN
BUR	BUILT UP ROOFING	ICV	IRRIGATION CONTROL VALVE	RFG	ROOFING
CAB	CABINET	ID	INSIDE DIAMETER	RM	ROOM
CPT	CARPET (ED)	INSUL	INSULATION	RO	ROUGH OPENING
CLG	CEILING	INT	INTERIOR	RHMS	ROUND HEAD MACHINE SCREW
CEM	CEMENT	JAN	JANITOR	RHWS	ROUND HEAD WOOD SCREW
⊙	CENTERLINE	JAN	JANITOR	SHT	SHEET
CER	CERAMIC	LAB	LABORATORY	SHTG	SHEET METAL SCREW
CIR	CIRCLE	L	LENGTH / LONG	SHWR	SHOWER
COL	COLUMN	LAM	LAMINATE (D)	SIM	SIMILAR
CONC	CONCRETE	LAV	LAVATORY	SC	SOLID CORE
CMU	CONCRETE MASONRY UNIT	LF	LINEAR FEET	S	SOUTH
CONN	CONNECTION	LF	LINEAR FEET	SPK	SPEAKER
CONST	CONSTRUCTION	LT	LIGHT	SPEC	SPECIFICATION (S)
CJ	CONSTRUCTION JOINT	LTV	LOUVER	SQ	SQUARE
CONT	CONTINUOUS/CONTINUE	M	MACHINE BOLT	SS	STAINLESS STEEL
CTS	COUNTER SINK	MB	MACHINE BOLT	STD	STANDARD
DEM	DEMOLISH / DEMOLITION	MH	MANHOLE	STL	STEEL
DET	DETAIL	MFR	MANUFACTURE (R)	STOR	STORAGE
DIAG	DIAGONAL	MAT	MATERIAL (S)	STRUC	STRUCTURE / STRUCTURAL
DIA	DIAMETER	MAX	MAXIMUM	SUSP	SUSPENDED
DIM	DIMENSION	MECH	MECHANIC (AL)	SYS	SYSTEM
DIV	DIVISION	MBR	MEMBER	TEL	TELEPHONE
DR	DOOR	MTL	METAL	TV	TELEVISION
DBL	DOUBLE	MIN	MINIMUM	THK	THICK (NESS)
DN	DOWN	MTG	MOUNT (ED)	TP	TOP OF PAVEMENT
DN	DOWN	MTG	MOUNTING	TS	TOP OF STEEL
DWG	DRAWING	NAT	NATURAL	TW	TOP OF WALL
DF	DRINKING FOUNTAIN/ DOUGLAS FIR	N	NORTH	T	TOP OF...
EA	EACH	N	NORTH	TR	TREAT
E	EAST	N	NORTH	TS	TUBULAR STEEL
ELEC	ELECTRIC (AL)	N	NORTH	TYP	TYPICAL
ELEV	ELEVATOR / ELEVATION	N	NOT IN CONTRACT	UON	UNLESS OTHERWISE NOTED
ENCL	ENCLOSE (URE)	NOM	NOMINAL	VERT	VERTICAL
EQ	EQUAL	N	NOT TO SCALE	VG	VERTICAL GRAIN
EQUIP	EQUIPMENT	N	NOT TO SCALE	VCT	VINYL COMPOSITION TILE
EXCA	EXCAVATE	N	NOT TO SCALE	WCST	WAINSCOT
EXH	EXHAUST	N	NOT TO SCALE	WC	WATER CLOSET
(E)	EXISTING	N	NOT TO SCALE	WH	WATER HEATER
EXP	EXPANSION	N	NOT TO SCALE	WR	WATERPROOF (ING)
EJ	EXPANSION JOINT	N	NOT TO SCALE	WR	WATER RESISTANT
FOC	FACE OF CONCRETE	N	NOT TO SCALE	W	WEIGHT
FOF	FACE OF FINISH	N	NOT TO SCALE	W	WEST / WOMEN / WIDE
FOM	FACE OF MASONRY	N	NOT TO SCALE	W	WATER RESISTANT
FOS	FACE OF STUD	N	NOT TO SCALE	WDW	WINDOW
FN	FIELD NAILING	N	NOT TO SCALE	W	WITH
FIN	FINISH (ED)	N	NOT TO SCALE	W/O	WITHOUT
FIN FLR	FINISH FLOOR	N	NOT TO SCALE	WD	WOOD

SYMBOLS LEGEND

KEY NOTE SYMBOLS	1 (NEW)	1 (DEMO)
ROOM NUMBER (SEE ROOM LEGEND)	101	
DOOR NUMBER-SEE DOOR AND FRAME SCHEDULE	1	
WINDOW NUMBER-SEE WINDOW SCHEDULE	X	
WALL TYPE	X	
WALL TYPE NOTE (MODIFIES WALL TYPE)	X	
DETAIL SYMBOL	7	AS.1
DETAIL CUT SYMBOL	7	AS.1
ELEVATIONS	A	2
SECTION/ELEVATION KEY	1	A1.0
DIMENSION LINES	8'-0"	
ACCESSIBLE WHEELCHAIR SPACE, 30"W x 48"D CLEAR FLOOR SPACE, 27"H CLEAR KNEE SPACE MIN. 34"H MAX. TO TOP OF TABLE/COUNTER.		
60" DIAMETER CLEAR WHEELCHAIR TURNING CIRCLE		
INDICATES REQUIRED CLR. FLR SPACE AT DOOR OPENINGS.		
WORK CONTROL/DATUM		
BREAK LINE		
CENTER LINE		
GRID LINE SYMBOL	1	
MATCHLINE SYMBOL		
REVISION MARK		
REVISION NO. AREA OF REVISION		
PROJECT REFERENCE NORTH		

SHEET INDEX

GENERAL

G-001 TITLE SHEET

ARCHITECTURAL

- A-100 SITE PLAN
- A-101 EXISTING RESTROOM PLANS
- A-200 BUILDING 'O' OVERALL FLOOR PLAN
- A-201 ENLARGED DEMO PLAN
- A-401 DOOR SCHEDULE
- A-402 ROOM FINISH SCHEDULE
- A-600 REFLECTED CEILING PLAN
- A-800 DETAILS

ELECTRICAL

- FA-100 FIRE ALARM CALCULATIONS SHEET
- FA-200 FIRE ALARM DEMO PLAN
- FA-300 FIRE ALARM DATA SHEETS

TOTAL SHEET COUNT: 12

PROJECT TEAM

ARCHITECT
KRUGER BENSEN ZIEMER ARCHITECTS, INC.
199 FIGUEROA STREET, SUITE 100A, VENTURA, CA 93001
OFFICE: (805) 650-1033

PRINCIPAL-IN-CHARGE: TODD A. JESPERSEN, AIA
EMAIL ADDRESS: toddj@kbzarch.com

PROJECT TEAM:

JONATHAN D. LEE
EMAIL ADDRESS: jonathand@kbzarch.com

PATRICK PANLAQUI
EMAIL ADDRESS: patrickp@kbzarch.com

ELECTRICAL ENGINEER
C. HOOD & ASSOCIATES, INC.
858 EAST FRONT STREET, VENTURA, CA 93001
OFFICE: (805) 641-4012

ENGINEER: CRAIG HOOD
EMAIL ADDRESS: craig@choodassociates.com

PROJECT DATA

PROJECT LOCATION : 4660 MISSION OAKS BLVD, CAMARILLO, CA 93012

FIRE DISTRICT : COUNTY OF VENTURA

BUILDING OCCUPANCY : B

BUILDING CONSTRUCTION TYPE : V-B (NON SPRINKLERED)

ACTUAL LOBBY AREA : 200 SQ. FT.

NO NEW SQUARE FOOTAGE

PROJECT SCOPE

THE PROJECT IS TO PROVIDE A SECURED ADMINISTRATION RECEPTION AREA BY INSTALLING A PERMANENT WALL WITH A SECURITY WINDOW BETWEEN THE LOBBY AND THE RECEPTION AREA. SCOPE OF WORK INCLUDES DEMOLITION, FRAMING, FINISHING, AND ASSOCIATED ELECTRICAL WORK.

△	-	-/-	XX
△	-	-/-	XX
DRAWN JL
CHECKED TJ
DATE 1/18/2018
JOB NO. 18014

SHEET TITLE SHEET

SHEET

G-001

IDENTIFICATION STAMP
 DIV. OF THE STATE ARCHITECT
 APP. 03-119338 INC.
 REVIEWED FOR
 SS FLS ACS
 DATE: 4/2/19
 OXNARD UNION HIGH SCHOOL DISTRICT
 ADOLFO CAMARILLO HIGH SCHOOL
 4660 MISSION OAKS BLVD, CAMARILLO, CA 93012
 SITE SECURITY IMPROVEMENTS



KRUGER BENSEN ZIEMER ARCHITECTS, INC. AIA
199 FIGUEROA ST. SUITE 100A VENTURA, CA 93001
TELEPHONE (805) 650-1033

TODD A. JESPERSEN, AIA
PRINCIPAL-IN-CHARGE
JONATHAN D. LEE
ARCHITECTURAL ASSISTANT

ELECTRICAL ENGINEER
C. HOOD & ASSOCIATES, INC.
858 EAST FRONT STREET, VENTURA, CA 93001
OFFICE: (805) 641-4012

ENGINEER: CRAIG HOOD
EMAIL ADDRESS: craig@choodassociates.com



ARCHITECTS
STAMP & SIGNATURE
TODD A. JESPERSEN
AIA
No. 86305919
STATE OF CALIFORNIA

All ideas, design arrangements and plans indicated or represented by the drawing are owned by and are the property of KrugerBensenZiemer, AIA, architects, and were created, worked and developed for use on, and in connection with, the specified projects. None of such ideas, designs, arrangements or plans shall be used by or disclosed to any person, firm or corporation for any purpose whatsoever without the written permission of KrugerBensenZiemer.

SITE PLAN KEYNOTES

- 1 REPLACE (E) PARKING LOT ENTRANCE SIGN WITH (N) IN COMPLIANCE WITH THE CURRENT ACCESSIBILITY CODE REQUIREMENTS
- 2 (E) ACCESSIBLE PARKING SPACE IN COMPLIANCE WITH THE CURRENT ACCESSIBILITY CODE REQUIREMENTS
- 3 (E) VAN ACCESSIBLE PARKING SPACE IN COMPLIANCE WITH THE CURRENT ACCESSIBILITY CODE REQUIREMENTS
- 4 (E) ACCESSIBLE GIRLS RESTROOM (03-103015 CERTIFIED)
- 5 (E) ACCESSIBLE BOYS RESTROOM (03-103015 CERTIFIED)
- 6 (E) ACCESSIBLE STAFF RESTROOM (03-103015 CERTIFIED)
- 7 (E) H-L-O DRINKING FOUNTAIN (03-103015 CERTIFIED)
- 8 (E) FIRE HYDRANT
- 9 (E) CURB CUT
- 10 ADD NOTE "MINIMUM FINE \$250 UNDER (E) VAN-ACCESSIBLE PARKING SIGNAGE IN COMPLIANCE WITH THE CURRENT ACCESSIBILITY CODE REQUIREMENTS"

GENERAL NOTES

- 1. PROTECT ALL EXISTING STRUCTURES, UTILITIES & LANDSCAPING DURING CONSTRUCTION.
- 2. PLANS WERE PREPARED USING AS-BUILT DRAWINGS RECEIVED FROM THE SCHOOL DISTRICT. THE CONTRACTOR SHALL FIELD VERIFY EXISTING ACTUAL CONDITIONS PRIOR TO START OF WORK AND NOTIFY THE ARCHITECT OF ANY DISCREPANCIES.
- 3. CAMPUS-WIDE MODERNIZATION UNDER A-03-103015 (CERTIFIED).

PATH OF TRAVEL

----- "ACCESSIBLE" PATH OF TRAVEL (P.O.T.) PER 03-103015 (CERTIFIED)

PATH OF TRAVEL (P.O.T.) AS INDICATED IS A BARRIER FREE ACCESS IS AT LEAST 48" WIDE WITHOUT ANY ABRUPT VERTICAL CHANGES EXCEEDING 1/2" BEVELLED AT 1:2 MAX. SLOPE. EXCEPT THAT LEVEL CHANGES DO NOT EXCEED 1/4" VERTICAL AND IS AT LEAST 48" WIDE. SURFACE IS SLIP RESISTANT, STABLE, FIRM AND SMOOTH. CROSS SLOPE DOES NOT EXCEED 2% AND SLOPE IN THE DIRECTION OF TRAVEL IS LESS THAN 1%. UNLESS OTHERWISE NOTED, P.O.T. SHALL BE MAINTAINED FREE OF OVERHANGING OBSTRUCTIONS TO 8" MINIMUM AND PROTRUDING OBJECTS GREATER THAN 4" PROTRUSION FROM WALL AND ABOVE 27" AND LESS THAN 80" ARCHITECT TO VERIFY THAT ALL BARRIERS IN THE PATH OF TRAVEL HAVE BEEN REMOVED OR WILL BE REMOVED UNDER THIS PROJECT.

PATH OF TRAVEL (P.O.T.) AS VERIFIED BY ARCHITECT IS:

- A COMMON BARRIER FREE ACCESSIBLE ROUTE AT LEAST 48" WIDE WITHOUT ANY ABRUPT VERTICAL CHANGES EXCEEDING 1/2" BEVELLED AT 1:2 MAXIMUM SLOPE. EXCEPT THAT LEVEL CHANGES DO NOT EXCEED 1/4" VERTICAL.
- THE PATH SURFACE IS SLIP RESISTANT, STABLE, FIRM AND SMOOTH.
- PARKING SPACES AT LEAST 6'0" X 6'0" ARE LOCATED NOT MORE THAN 200' APART.
- CONTINUOUS GRADIENTS HAVE 6" LEVEL AREAS NOT MORE THAN 400' APART.
- CROSS-SLOPE DOES NOT EXCEED 2%.
- SLOPE IN THE DIRECTION OF TRAVEL IS LESS THAN 2% UNLESS OTHERWISE INDICATED AS A RAMP.
- MAINTAIN POT FREE OF OVERHANGING OBSTRUCTIONS TO 8" MINIMUM. PROTRUDING OBJECTS GREATER THAN 4" PROTRUSION FROM WALL OR EDGE AND 27" ABOVE FINISH GRADE.

FOR GRATEINGS LOCATED IN THE SURFACE OF ANY PEDESTRIAN WAYS AT PATH OF TRAVEL, GRID OPENINGS IN GRATEINGS SHALL BE LIMITED TO 1/2" MAX. IN THE DIRECTION OF TRAFFIC FLOW. IF SUCH CONDITION OCCURS, PROVIDE MANUFACTURER CUTSHEETS OF GRATE PROVIDED.

GATES SERVING THE MEANS OF EGRESS SYSTEM SHALL COMPLY WITH THE REQUIREMENTS OF SECTION 1008. GATES USED AS A COMPONENT IN A MEANS OF EGRESS SHALL CONFORM TO THE APPLICABLE REQUIREMENTS FOR DOORS. PROVIDE LOWER HARDWARE AND KICKPLATE. FIRE AND LIFE SAFETY MAY REQUIRE PANIC HARDWARE FOR EMERGENCY EXITING EVEN WITH THE SIGN. COORDINATE WITH FIRE AND LIFE SAFETY REQUIREMENTS.

DESIGN PROFESSIONAL IN GENERAL RESPONSIBLE CHARGE STATEMENT THE POT IDENTIFIED IN THESE CONSTRUCTION DOCUMENTS IS COMPLIANT WITH THE CURRENT APPLICABLE CALIFORNIA BUILDING CODE ACCESSIBILITY PROVISIONS FOR PATH OF TRAVEL REQUIREMENTS FOR ALTERATIONS, ADDITIONS AND STRUCTURAL REPAIRS AS PART OF THE DESIGN OF THIS PROJECT. THE POT WAS EXAMINED AND ANY ELEMENTS, COMPONENTS OR PORTIONS OF THE POT THAT WERE DETERMINED TO BE NON-COMPLIANT:



- 1. HAVE BEEN IDENTIFIED.
- 2. THE CORRECTIVE WORK NECESSARY TO BRING THEM INTO COMPLIANCE HAS BEEN INCLUDED WITHIN THE SCOPE OF THIS PROJECTS WORK THROUGH DETAILS DRAWINGS AND SPECIFICATIONS INCORPORATED INTO THESE CONSTRUCTION DOCUMENTS. DURING CONSTRUCTION, IF POT ITEMS WITHIN THE SCOPE OF THE PROJECT REPRESENTED AS CODE COMPLIANT ARE FOUND TO BE NON-COMPLYING BEYOND REASONABLE CONSTRUCTION TOLERANCES, THEY SHALL BE BROUGHT INTO COMPLIANCE WITH THE CBC AS PART OF THIS PROJECT BY MEANS OF A CONSTRUCTION CHANGE DOCUMENT.




KRUGER BENSON ZIEMER ARCHITECTS, INC. AIA
 1899 REDWOOD ST., SUITE 100A VENTURA, CA 93001
 TELEPHONE (805) 655-1033

TODD A. JESPERSEN, AIA
 ARCHITECT/PRINCIPAL


JONATHAN D. LEE
 ARCHITECTURAL ASSISTANT

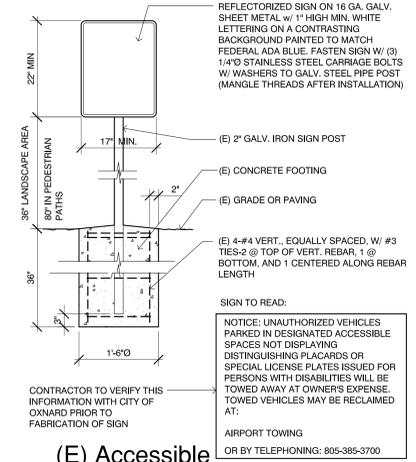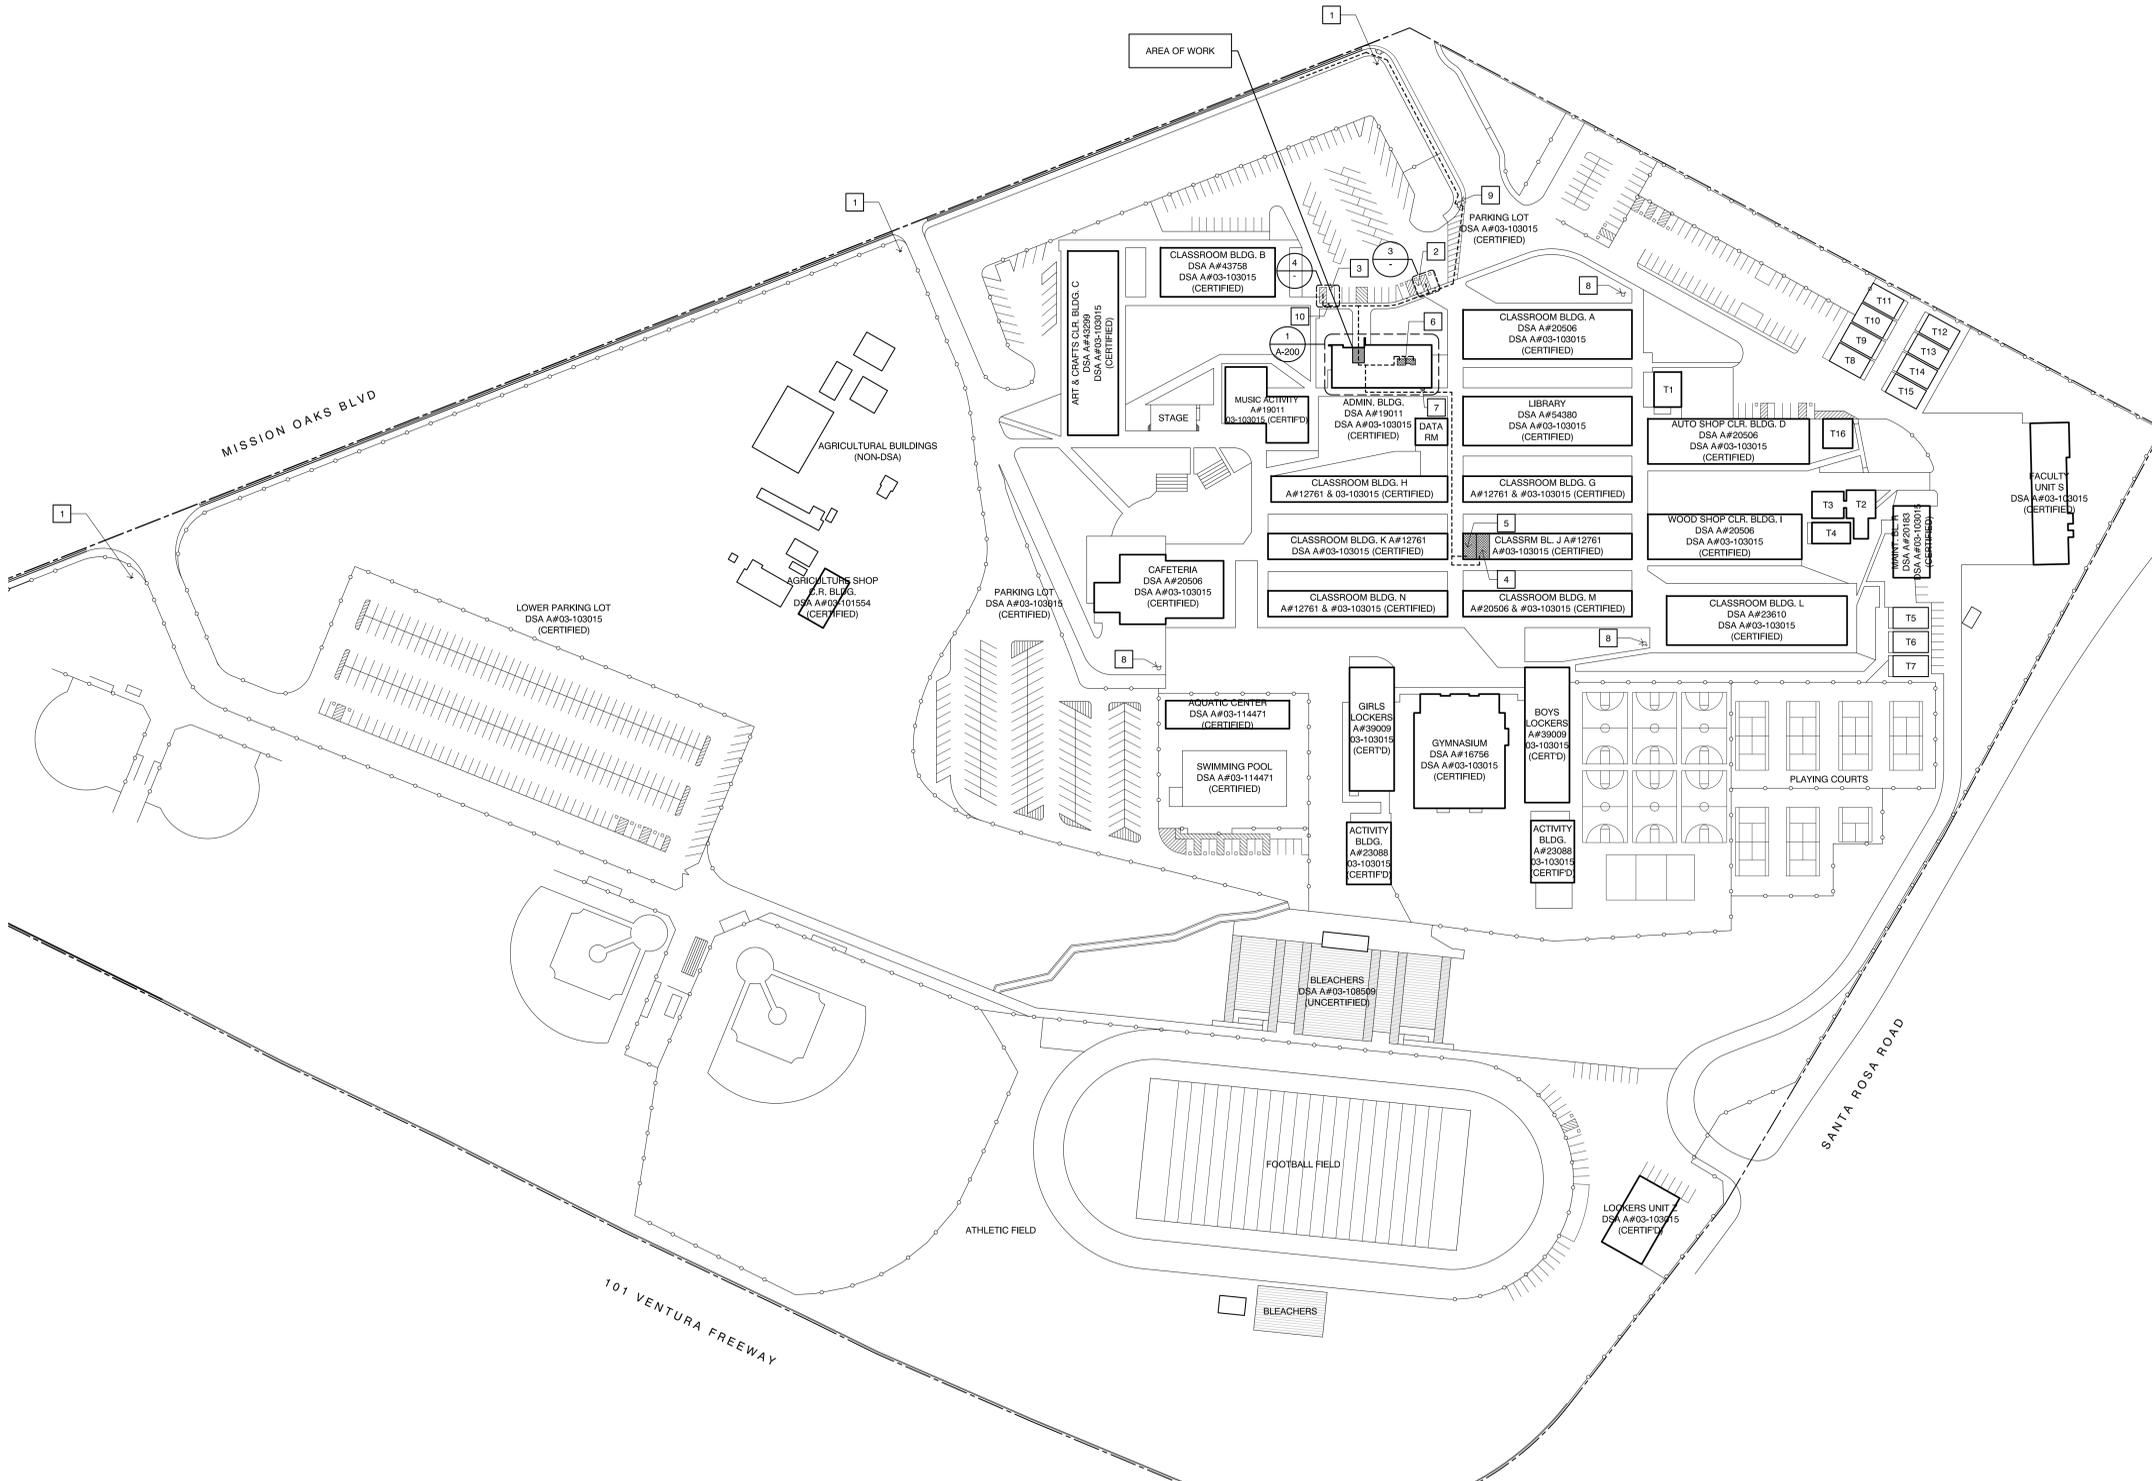


2 (E) Accessible Parking Lot Entrance Sign
 SCALE: 3/4" = 1'-0"

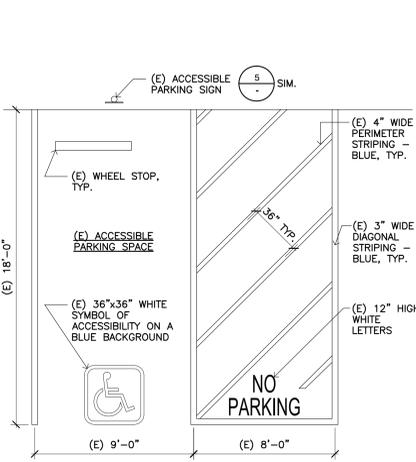


3 (E) Accessible Parking Space
 SCALE: 1/4" = 1'-0"

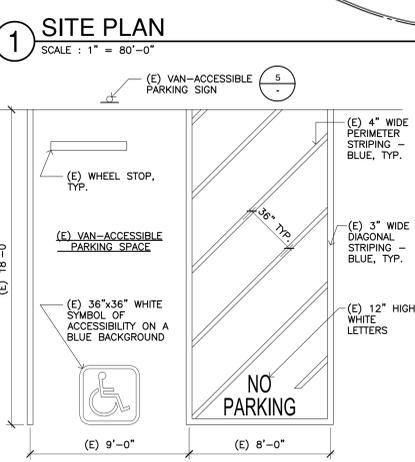


4 (E) Van-Accessible Parking Space
 SCALE: 1/4" = 1'-0"

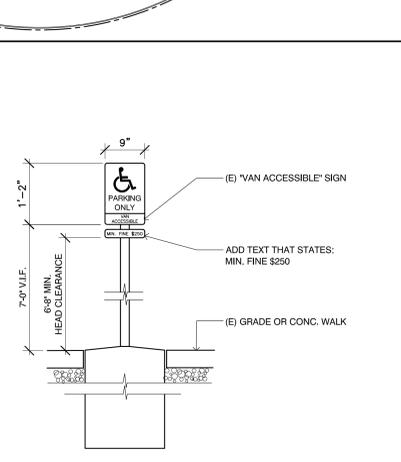

5 Existing Accessible Parking Sign
 SCALE: 3/4" = 1'-0"

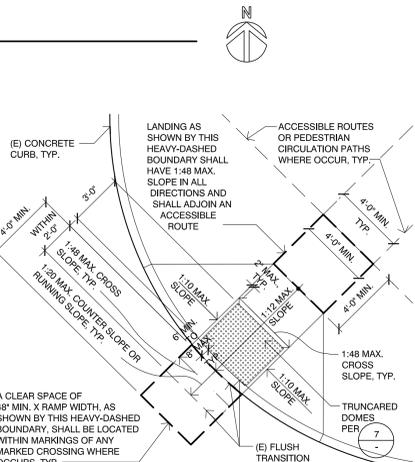

6 Existing Curb Cut, Typical
 SCALE: 1/4" = 1'-0"

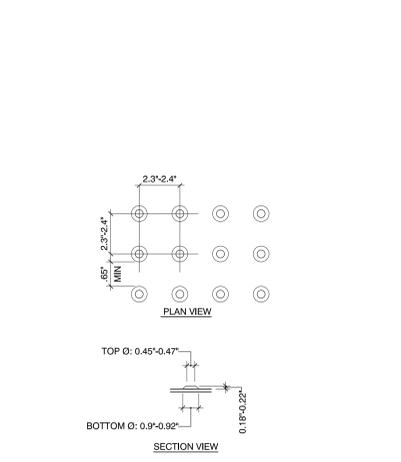

7 Truncated Domes
 SCALE: 3" = 1'-0"


REVISION	DESCRIPTION	DATE	BY
1	PP/JL	1/18/2018	TJ
2	TJ	1/18/2018	TJ
3	18014		
4	SITE PLAN		
5	SITE DETAILS		

IDENTIFICATION STAMP
 DIV. OF THE STATE ARCHITECT
 APP. 03-119338 INC.
 REVIEWED FOR
 SS [] FLS [] ACS []
 DATE: 4/2/19


OXNARD UNION HIGH SCHOOL
 ADOLFO CAMARILLO HIGH
 4660 MISSION OAKS BLVD., CAMARILLO, CA 93018
 SITE SECURITY IMPROVEMENT

EXISTING RESTROOM KEYNOTES

- 1 UPDATE (E) MENS RESTROOM SIGNAGE IF NON-COMPLIANT S5
A-800
- 2 UPDATE (E) WOMENS RESTROOM SIGNAGE IF NON-COMPLIANT S4
A-800
- 3 UPDATE (E) BOYS RESTROOM SIGNAGE IF NON-COMPLIANT S3
A-800
- 4 UPDATE (E) GIRLS RESTROOM SIGNAGE IF NON-COMPLIANT S2
A-800
- 5 (E) WATER CLOSET TO REMAIN
- 6 (E) SINK TO REMAIN
- 7 (E) 36" S.S. GRAB BAR TO REMAIN
- 8 (E) 48" S.S. GRAB BAR TO REMAIN
- 9 (E) PARTITION TO REMAIN
- 10 (E) URINAL TO REMAIN
- 11 (E) PAPER TOWEL DISPENSER TO REMAIN
- 12 (E) DOOR TO REMAIN
- 13 (E) WINDOW TO REMAIN
- 14 (E) WALL TO REMAIN
- 15 (E) TILE FLOOR TO REMAIN
- 16 (E) HAND DRYER TO REMAIN

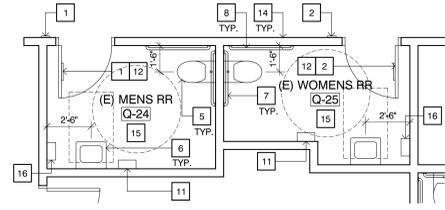

1 EXISTING STAFF RESTROOMS
 SCALE: 1/4" = 1' - 0"

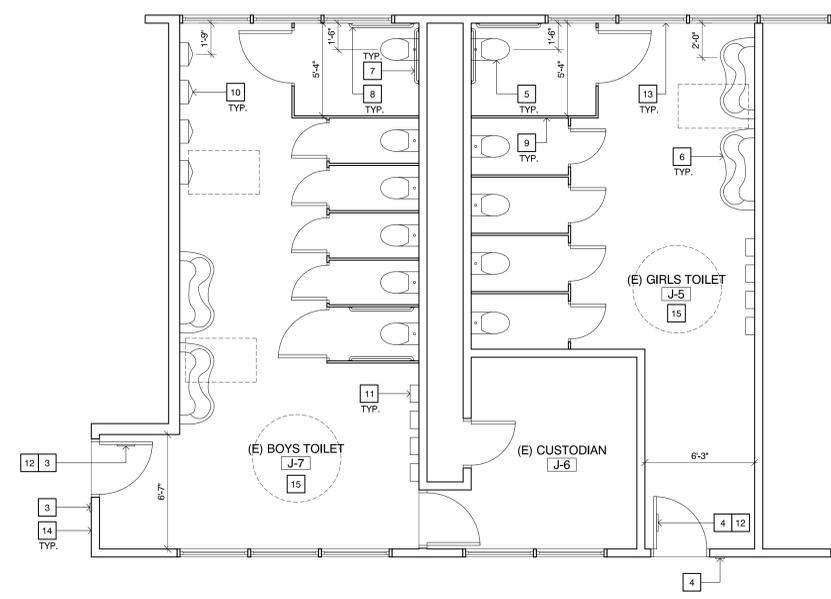

2 EXISTING BOYS & GIRLS RESTROOMS
 SCALE: 1/4" = 1' - 0"



KRUGER BENSEN ZIEMER ARCHITECTS, INC. AIA
 188 FULFORDA ST., SUITE 100A VENTURA, CA 93001
 TELEPHONE (805) 850-1033

TODD A. JESPERSEN, AIA
 PRINCIPAL/ARCHITECT

JONATHAN D. LEE
 ARCHITECTURAL ASSISTANT

All ideas, design arrangements and plans indicated or represented by this drawing are owned by and are the property of Kruger-Bensen-Ziemer, AIA, architects, and were created, issued and developed for use on, and in connection with, the specified projects. None of such ideas, designs, arrangements or plans shall be used by or disclosed to any person, firm or corporation for any purpose whatsoever without the written permission of Kruger-Bensen-Ziemer.




△	-	-/-	XX
△	-	-/-	XX
REVISION	DESCRIPTION	DATE	BY
DRAWN	JL		
CHECKED	TJ		
DATE		1/18/2018	
JOB. NO.		18014	


SHEET EXISTING RESTROOM PLANS
 TITLE

IDENTIFICATION STAMP
 DIV. OF THE STATE ARCHITECT
 APP. 03-119338 INC.
 REVIEWED FOR
 SS FLS ACS
 DATE: 4/2/19

OXNARD UNION HIGH SCHOOL DISTRICT
 ADOLFO CAMARILLO HIGH SCHOOL
 4660 MISSION OAKS BLVD., CAMARILLO, CA 93013
 SITE SECURITY IMPROVEMENTS

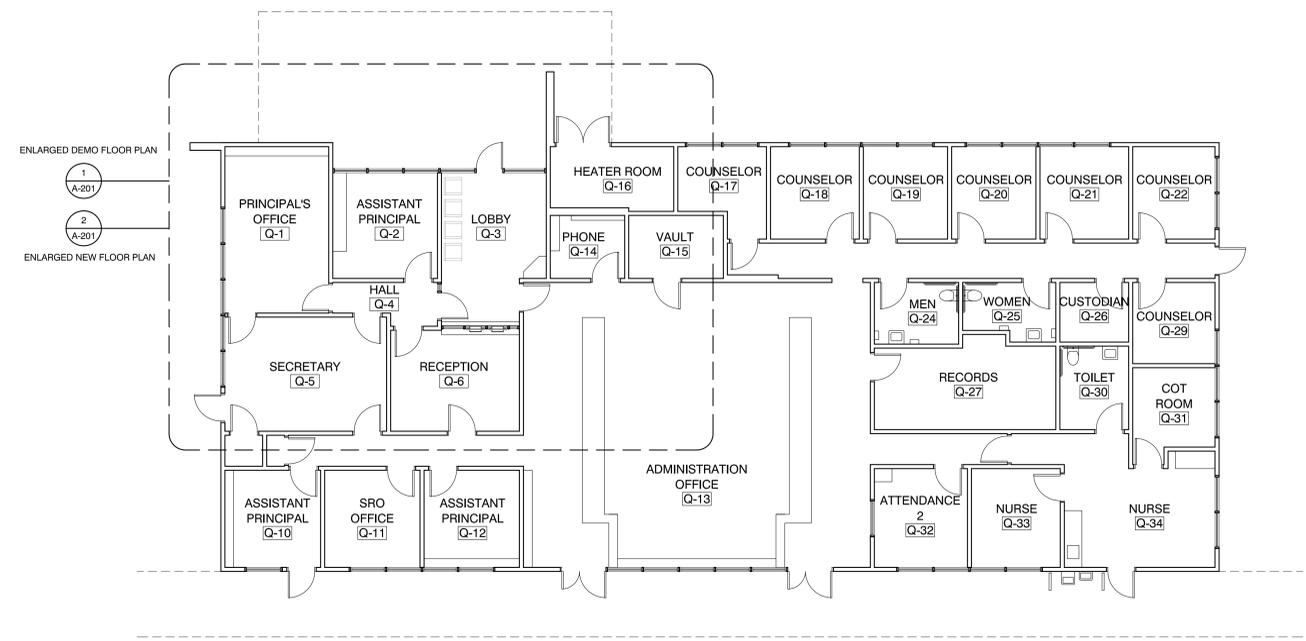

1 BUILDING 'Q' OVERALL FLOOR PLAN
 SCALE : 1/8" = 1'-0"

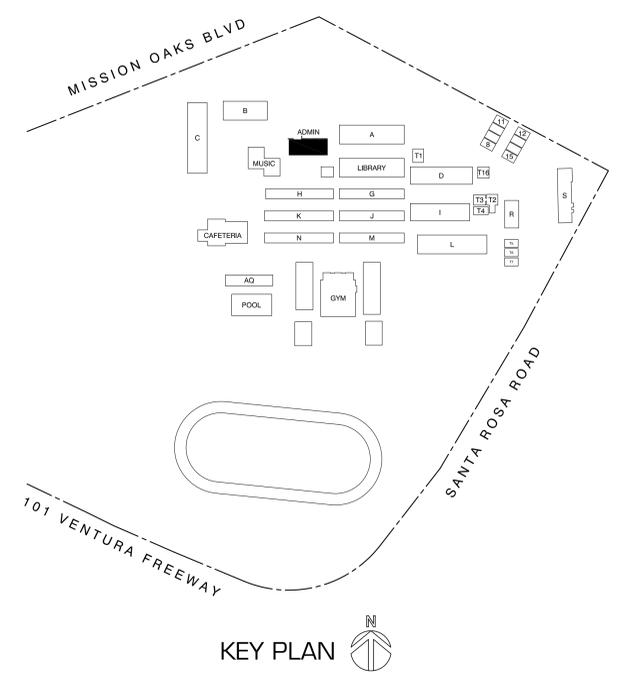

KEY PLAN



KRUGER BENSEN ZIEMER ARCHITECTS, INC. AIA
 189 FIDELITY ST. SUITE 100A VENTURA CA 93001
 TELEPHONE (805) 656-1033

TODD A. JESPERSEN, AIA
 PRINCIPAL/ARCHITECT
JONATHAN D. LEE
 ARCHITECTURAL ASSISTANT

All ideas, design arrangements and plans indicated or represented by this drawing are owned by and are the property of Kruger-Bensen-Ziemer, AIA, architect, and were created, issued and developed for use only and in connection with the specified project. None of such ideas, designs, arrangements or plans shall be used by or disclosed to any person, firm or corporation for any purpose whatsoever without the written permission of Kruger-Bensen-Ziemer.




REVISION	DESCRIPTION	DATE	BY
△	-	-/-	XX
△	-	-/-	XX
DRAWN JL
 CHECKED TJ
 DATE 1/18/2018
 JOB. NO. 18014

SHEET BUILDING 'Q' OVERALL FLOOR PLAN
 TITLE

SHEET
A-200

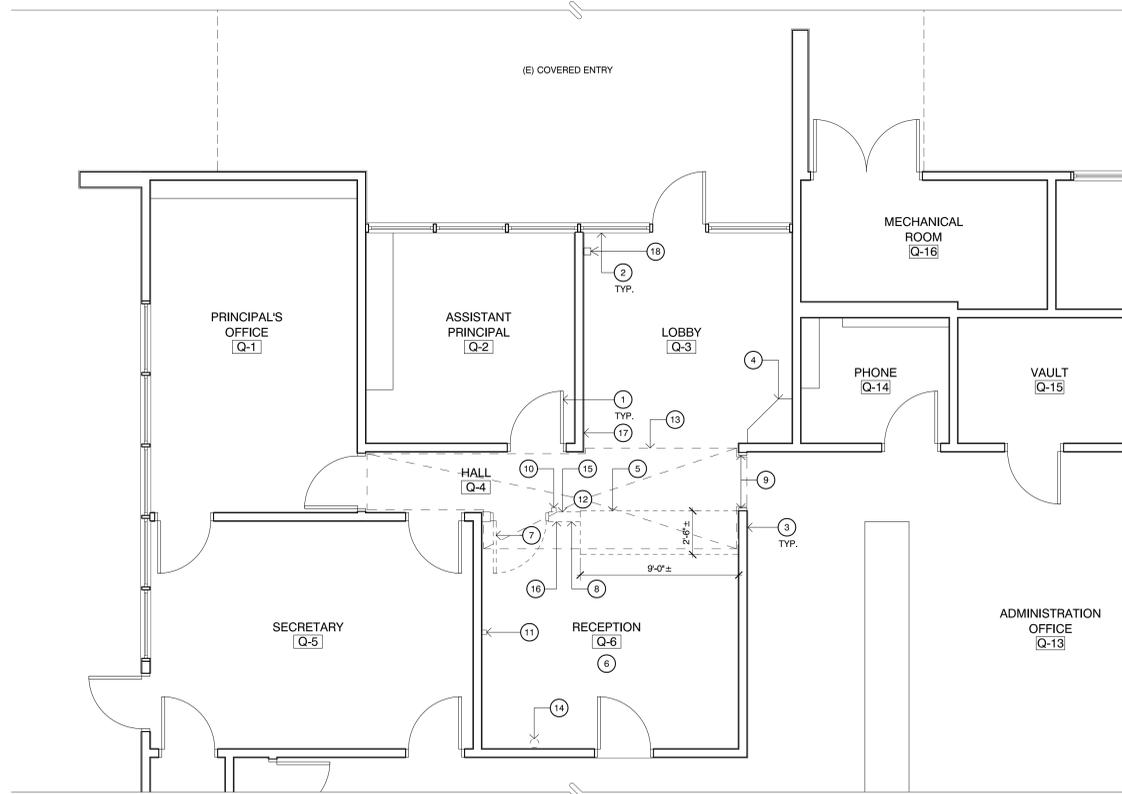

1 ENLARGED DEMO FLOOR PLAN
SCALE: 1/4" = 1'-0"

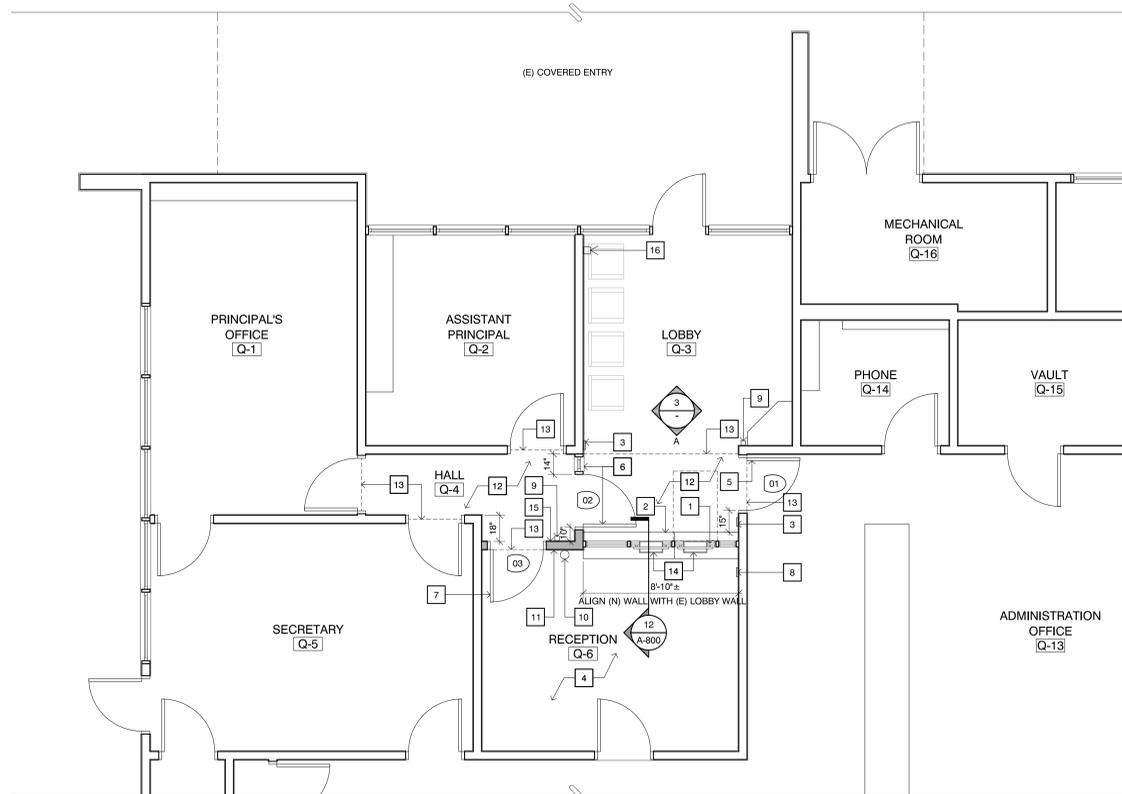

2 ENLARGED NEW FLOOR PLAN
SCALE: 1/4" = 1'-0"

DEMO PLAN KEYNOTES


- 1 (E) DOOR TO REMAIN
- 2 (E) WINDOW TO REMAIN
- 3 (E) WALL TO REMAIN
- 4 (E) CABINET TO REMAIN
- 5 DEMO (E) COUNTER & BASE CABINETS
- 6 REMOVE (E) CARPET & RUBBER BASE
- 7 DEMO (E) DOOR
- 8 DEMO (E) WALL
- 9 DEMO (E) DOOR FRAME/CASING
- 10 UPDATE (E) FIRE ALARM STROBE TO HORN/STROBE AND RELOCATE
- 11 (E) FIRE ALARM DEVICE TO REMAIN
- 12 REMOVE (E) VCT, CARPET & BASE FOR (N) WORK
- 13 REMOVE (E) VCT TO NEAREST FULL TILE NORTH OF THIS LINE
- 14 RELOCATE (E) FIRE EXTINGUISHER
- 15 RELOCATE (E) WALL OUTLET
- 16 RELOCATE (E) LIGHT SWITCH
- 17 (E) LIGHT SWITCH TO REMAIN
- 18 (E) PULL STATION TO REMAIN

NEW PLAN & INTERIOR ELEVATION KEYNOTES


- 1 (N) SECURITY STOREFRONT ASSEMBLY
- 2 (N) H-I/O COUNTER
- 3 (N) ACCESS CARD READER
- 4 (N) CARPET & RUBBER BASE
- 5 (N) DOOR & FRAME IN (E) OPENING
- 6 (N) INTEG. H.M. SIDE LIGHT + DOOR & FRAME w/ BULLET-RESISTANT 1-1/4" LP 125 LAMINATED GLASS
- 7 (N) DOOR & FRAME
- 8 (N) DOOR ACCESS CONTROLS @ +36" AFF
- 9 (N) LOCATION FOR (N) FIRE ALARM HORN/STROBE
- 10 (N) LOCATION FOR (E) FIRE EXTINGUISHER
- 11 (N) LOCATION FOR LIGHT SWITCH
- 12 (N) VCT TO MATCH (E)
- 13 (N) ALUMINUM TRANSITION STRIP
- 14 (N) BULLET-TRAP RECESSED CURRENCY TRAY
- 15 (N) LOCATION FOR WALL OUTLET
- 16 (E) PULL STATION TO REMAIN

LEGEND

- (N) WALL, MATCH (E) ADJACENT FINISHES
- (N) H-I/O SOLID SURFACE CASEWORK TRANSACTION COUNTER
- (N) GYPSUM BOARD
- (N) 6" RUBBER BASE TO MATCH (E)

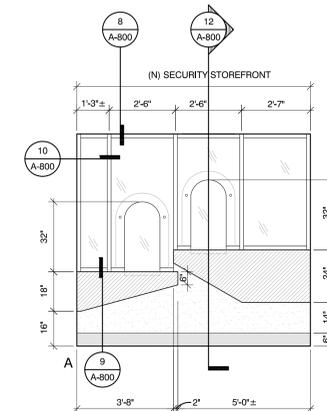

3 INTERIOR ELEVATION - LOBBY
SCALE: 3/8" = 1'-0"

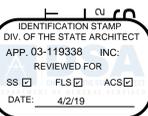

OXNARD UNION HIGH SCHOOL DISTRICT
ADOLFO CAMARILLO HIGH SCHOOL
 4860 MISSION DALES BLVD., CAMARILLO, CA 93013
SITE SECURITY IMPROVEMENT



KRUGER BENSEN ZIEMER ARCHITECTS, INC. AIA
 188 FULFORDA ST., SUITE 1000 VENTURA, CA 93001
 TELEPHONE (805) 850-1033

TODD A. JESPERSEN, AIA
 PRINCIPAL/ARCHITECT
JONATHAN D. LEE
 ARCHITECTURAL ASSISTANT

All ideas, design arrangements and plans indicated or represented by this drawing are owned by and are the property of Kruger-Bensen-Ziemer, Inc. All architectural and work created, issued and developed for use on, and in connection with, the specified projects. None of such ideas, designs, arrangements or plans shall be used by or disclosed to any person, firm or corporation for any purpose whatsoever without the written permission of Kruger-Bensen-Ziemer.




ARCHITECTS
 STAMP & SIGNATURE
 T. A. JESPERSEN
 No. 25839
 State of California

	-	-/-	XX
	-	-/-	XX
REVISION	DESCRIPTION	DATE	BY
9			

DRAWN: JL
 CHECKED: TJ
 DATE: 1/18/2018
 JOB NO.: 18014

SHEET: ENLARGED DEMO FLOOR PLAN
 TITLE: ENLARGED NEW FLOOR PLAN
 INTERIOR ELEVATION
 SHEET: A-201

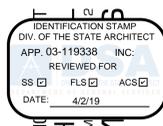

OXNARD UNION HIGH SCHOOL DISTRICT
 ADOLFO CAMARILLO HIGH SCHOOL
 4660 MISSION OAKS BLVD., CAMARILLO, CA 94001
 SITE SECURITY IMPROVEMENT

DOOR, FRAME AND SIGNAGE MESSAGE SCHEDULE																													
DOOR	DOOR INFO																	SIGNAGE INFO											
	DOOR OPENING		DOOR					CUTOUTS		HDWR GROUP	ASSY FIRE RATING	FRAME				DETAILS				DOOR REMARKS	SIGN TYPE/ SEE DETAIL SIDE OF DOOR		DESCRIPTION		MESSAGE		SIGNAGE REMARKS		
	WIDTH	HEIGHT	TYPE	MAT'L	THICK	FIN	COLOR	LITE	LVR			TYPE	MAT'L	FIN	COLOR	HEAD	JAMB	SILL	SIGNAGE		PULL SIDE	PUSH SIDE	PULL SIDE	PUSH SIDE	PULL SIDE	PUSH SIDE			
1	3'-0"	7'-0"	A	HM	1 3/4"	PT	TBD	1	-	01	-	1	HM	PT	TBD	4 A-800	4 A-800	4 A-800	7 A-800	G1 A-800	S1 A-800	CARD READER & ACCESS CONTROL	S1	S1	◇	◇	EXIT	OFFICE	◇
2	3'-0"	7'-0"	A	HM	1 3/4"	PT	TBD	1	-	02	-	1	HM	PT	TBD	4 A-800	4 A-800	4 A-800	7 A-800	G1 A-800	S1 A-800	CARD READER & ACCESS CONTROL	S1	S1	◇	◇	PRINCIPAL/ ASSISTANT PRINCIPAL EXIT	RECEPTION	◇
3	3'-0"	7'-0"	A	HM	1 3/4"	PT	TBD	1	-	03	-	1	HM	PT	TBD	4 A-800	4 A-800	4 A-800	7 A-800	G1 A-800	S1 A-800		S1	S1	◇	◇			◇

DOOR SCHEDULE KEYNOTES

- 1 DOOR HARDWARE PROVIDED BY MODULAR PARTITION MANUFACTURER

SIGNAGE KEYNOTES

- 1 EXTERIOR PANEL SIGN
- 2 INTERIOR PANEL SIGN

GLAZING TYPES

- GL1 LAMINATED SAFETY GLASS (CLEAR) - 1/2" THICK
- GL2 BULLET-RESISTANT 1-1/4" LP 125 - LAMINATED (CLEAR)

ABBREVIATIONS

- ALUM ALUMINUM
- FF FACTORY FINISH
- HM HOLLOW METAL
- MFR PER MANUFACTURER
- PT PAINTED
- SC WD SOLID CORE WOOD
- SS STAINLESS STEEL

GENERAL NOTES

- SEE S1/A-800 FOR INTERIOR PANEL SIGNAGE MOUNTING HEIGHTS.
- SEE DOOR & FRAME SCHEDULE FOR PANEL SIGNAGE ASSOCIATED w/ A DOOR.
- SEE SHEET A-800 FOR SIGN DETAILS.

SIGNAGE NOTES

- SK1 PANEL WALL MOUNT

DOORS NOTES

- VERIFY ALL ROUGH OPENINGS DIMENSIONS PRIOR TO FABRICATION.
- ALL DOORS SHALL HAVE LEVER HARDWARE U.O.N. DOOR HANDLES, PULLS, LATCHES, LOCKS, AND OTHER OPERATING DEVICES SHALL BE INSTALLED MINIMUM 34" AND MAXIMUM 48" ABOVE FINISH FLOOR. (CBC 1008.1.9.2).
- ALL EXIT DOORS SHALL BE OPENABLE FROM INSIDE WITHOUT THE USE OF A KEY OR SPECIAL KNOWLEDGE (CBC 1008.1.9) AND THE FORCE REQUIRED TO PUSH OR PULL AN EGRESS DOOR TO THE OPEN POSITION SHALL NOT EXCEED 5 POUND (CBC 1008.1.3).
- CONTRACTOR SHALL PROVIDE POWER AS NECESSARY FOR FULL OPERATION OF KEYPAD ACCESS.
- PANIC HARDWARE SHALL CONTAIN A MINIMUM OF TWO LOCKING POINTS ON EACH DOOR.
- GLAZING IN DOORS OR WITHIN 40" OF ANY DOOR LOCKING MECHANISM SHALL BE FULLY TEMPERED SAFETY GLASS.
- ALL PEDESTRIAN DOORS AND GATES (EXCEPT SLIDING DOORS) SHALL BE PROVIDED WITH A KICKPLATE AT THE BOTTOM 10 INCHES OF THE PUSH SIDE OF THE DOOR.
- PROVIDE STEEL INSERTS AT STOREFRONTS AS REQUIRED.



DOOR TYPES
SCALE: 1/4" = 1'-0"



DOOR FRAME TYPES
SCALE: 1/4" = 1'-0"



KRUGER BENSEN ZIEMER ARCHITECTS, INC. AIA
 1199 HELIXSON ST., SUITE 100A VENTURA, CA 93001
 TELEPHONE (805) 650-1033


TODD A. JESPERSEN, AIA
 PRINCIPAL/ARCHITECT
JONATHAN D. LEE
 ARCHITECTURAL ASSOCIATE

All lines, design arrangements and plans indicated or represented by this drawing are owned by and are the property of Kruger-Bensen-Ziemer, AIA, architects, and were created, edited and developed for use on, and in connection with, the specific project. None of such lines, design, arrangements or plans shall be used by or disclosed to any person, firm or corporation for any purpose whatsoever without the written permission of Kruger-Bensen-Ziemer.



△	-	-/-	XX
△	-	-/-	XX
REVISION DESCRIPTION DATE BY
 DRAWN: JL
 CHECKED: TJ
 DATE: 1/18/2018
 JOB. NO. 18014
 SHEET DOOR SCHEDULE
 TITLE

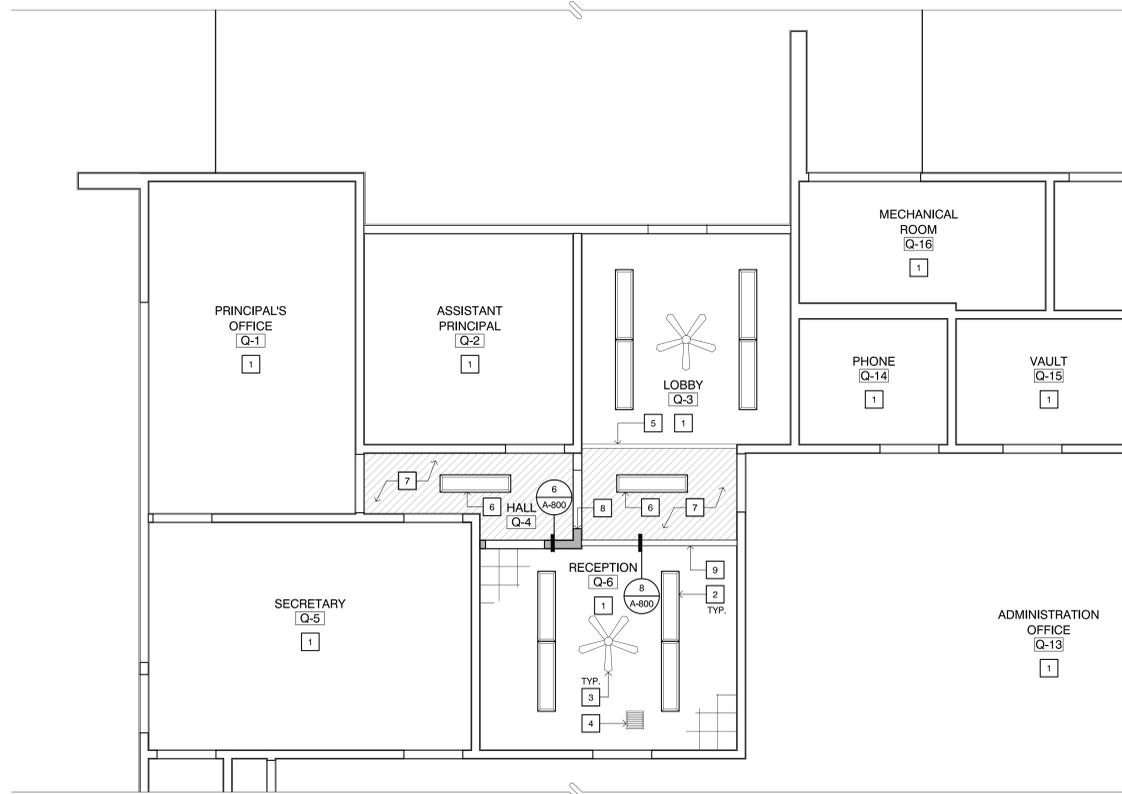

1 REFLECTED CEILING PLAN
SCALE: 1/4" = 1'-0"



CEILING PLAN KEYNOTES

- 1 (E) CEILING TO REMAIN
- 2 (E) LIGHT FIXTURE TO REMAIN
- 3 (E) FAN TO REMAIN
- 4 (E) GRILLE TO REMAIN
- 5 (E) GYPSUM BOARD SOFFIT EDGE TO REMAIN
- 6 REMOVE & RE-INSTALL (E) LIGHT FIXTURE AS REOD, FOR CEILING TILE REPLACEMENT
- 7 REMOVE (E) 12x12 GLUED ON CEILING TILE & REPLACE WITH (N) USE Henry 237 AcoustiGum CEILING TILE ADHESIVE (SOLVENT-FREE, NONFLAMMABLE) TO INSTALL
- 8 (N) WALL - FROM FLOOR TO CEILING
- 9 (N) SECURITY STOREFRONT

LEGEND

- (N) WALL MATCH (E) ADJACENT FINISHES
- (N) 12x12 GLUED ON CEILING TILE

IDENTIFICATION STAMP
DIV. OF THE STATE ARCHITECT
APP. 03-119338 INC.
REVIEWED FOR
SS FLS ACS
DATE: 4/2/19

OXNARD UNION HIGH SCHOOL DISTRICT
 ADOLFO CAMARILLO HIGH SCHOOL
 4660 MISSION OAKS BLVD., CAMARILLO, CA 93018
 SITE SECURITY IMPROVEMENT



KRUGER BENSEN ZIEMER ARCHITECTS, INC. AIA
199 FIGUEROA ST., SUITE 1000 VENTURA, CA 93001
TELEPHONE (805) 850-1033

TODD A. JESPERSEN, AIA
REGISTERED ARCHITECT
JONATHAN D. LEE
ARCHITECTURAL ASSISTANT

All these design arrangements and plans indicated or represented by this drawing are owned by and are the property of Kruger-Bensen-Ziemer, AIA, architects, and were created, issued and developed for use on, and in connection with, the specified projects. None of such these design, arrangements or plans shall be used by or disclosed to any person, firm or corporation for any purpose whatsoever without the written permission of Kruger-Bensen-Ziemer.




△	-	--/--	XX
△	-	--/--	XX
REVISION	DESCRIPTION	DATE	BY
DRAWN	JL		
CHECKED	TJ		
DATE		1/18/2018	
JOB. NO.		18014	

SHEET REFLECTED CEILING PLAN
TITLE


SHEET
TITLE
A-600

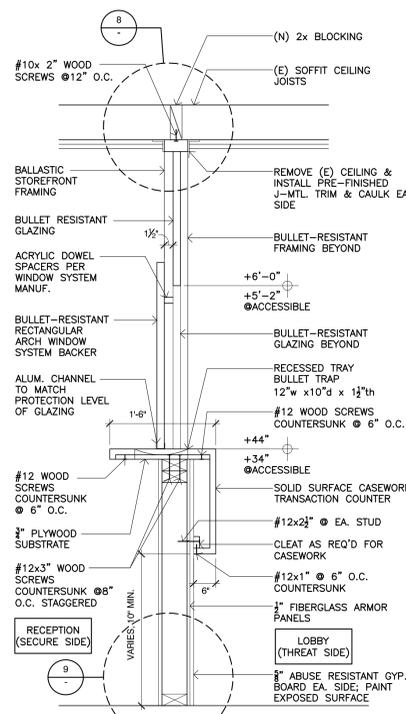


12 Storefront Wall Section
SCALE: 1" = 1'-0"

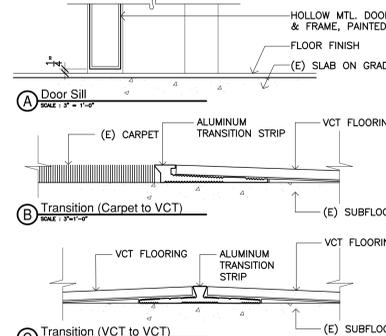


7 Door Sill & Transition Strip
SCALE: 3" = 1'-0"

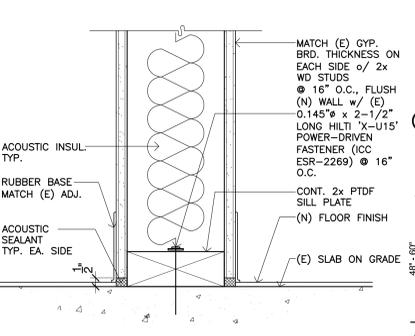


2 Non-bearing Interior Wall to Conc.
SCALE: 3" = 1'-0"

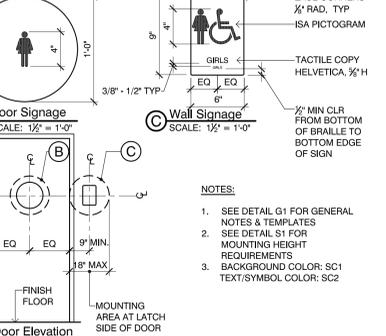


S2 Girls Restroom Signage
SCALE: AS NOTED

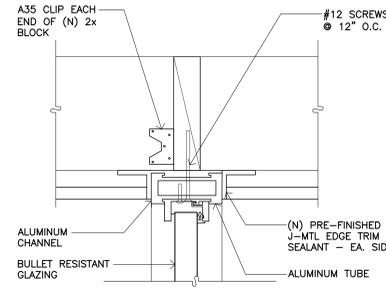


8 Storefront Head (Jamb Sim.)
SCALE: 3" = 1'-0"

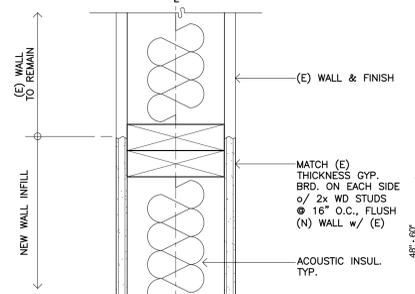


3 Typ. Wall Infill
SCALE: 3" = 1'-0"

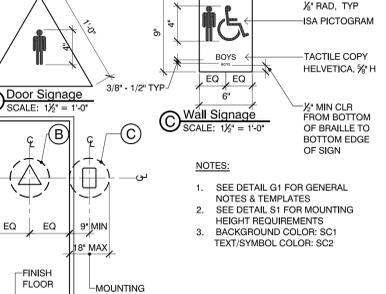


S3 Boys Restroom Signage
SCALE: AS NOTED

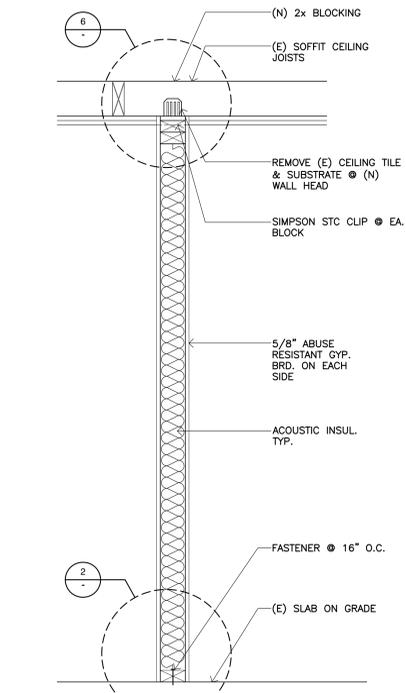


13 Wall Section
SCALE: 1" = 1'-0"

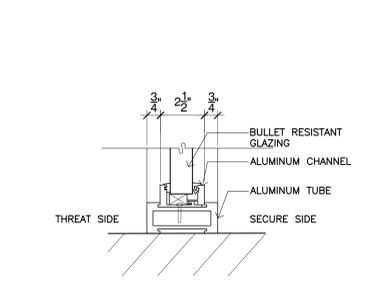


9 Storefront Sill
SCALE: 3" = 1'-0"

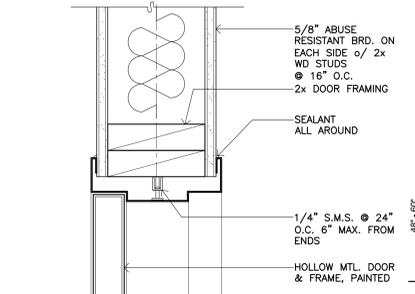


4 Head at Interior Door (Jamb Sim.)
SCALE: 3" = 1'-0"

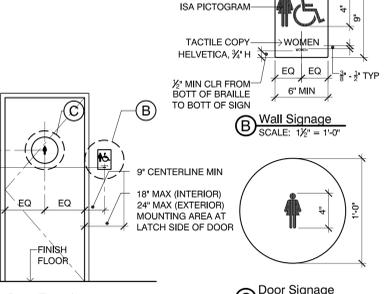


S4 Womens Restroom Signage
SCALE: AS NOTED

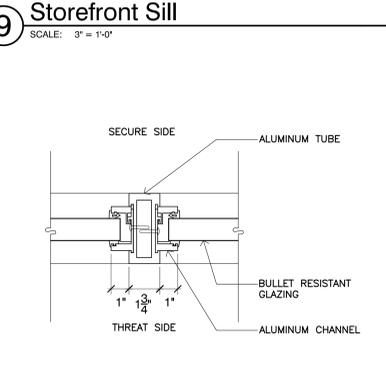


10 Storefront Mullion
SCALE: 3" = 1'-0"

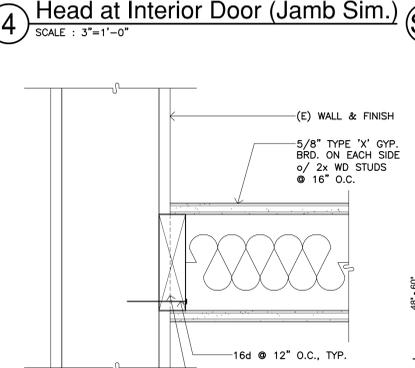


5 Wall Detail
SCALE: 3" = 1'-0"

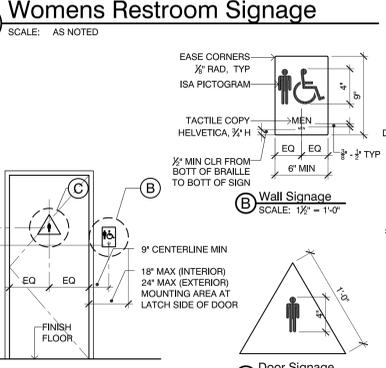


S5 Mens Restroom Signage
SCALE: AS NOTED

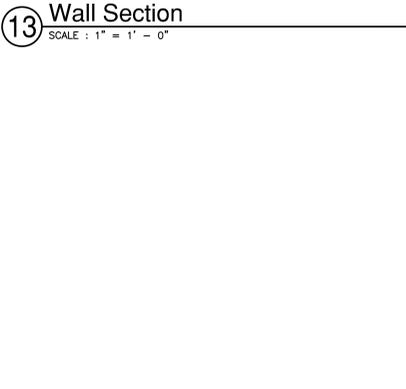


11 Not Used
SCALE: NO SCALE

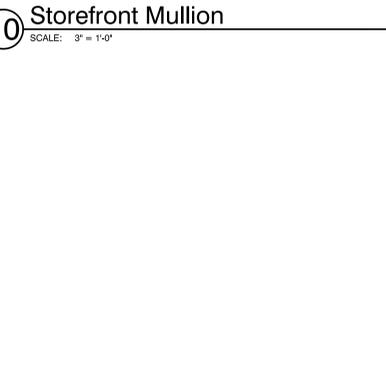

6 Wall Detail
SCALE: 3" = 1'-0"

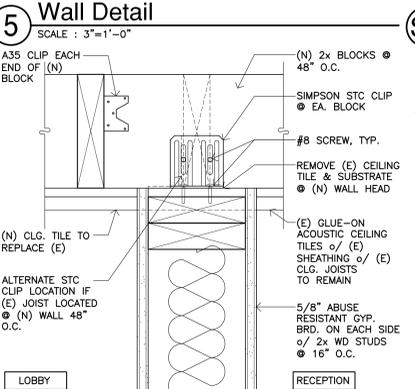

1 (N) Door Framing Detail
SCALE: N.T.S.

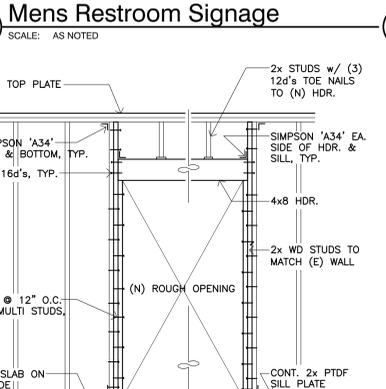

S1 Typ Mounting Hgt. Requirements
SCALE: AS NOTED

- A. RAISED CHARACTERS PER CBC 11B-703.2**
- DEPTH: RAISED CHARACTERS SHALL BE 1/8" MINIMUM ABOVE THEIR BACKGROUND.
 - CASE: CHARACTERS SHALL BE UPPERCASE.
 - STYLE: CHARACTERS SHALL BE SANS SERIF. CHARACTERS SHALL NOT BE ITALIC, OBLIQUE, SCRIPT, HIGHLY DECORATIVE, OR OF OTHER UNUSUAL FORMS.
 - CHARACTER PROPORTIONS: CHARACTERS SHALL BE SELECTED FROM FONTS WHERE THE WIDTH OF THE UPPERCASE LETTER 'O' IS 60% MINIMUM AND 110% MAXIMUM OF THE HEIGHT OF THE UPPERCASE LETTER 'T'.
 - CHARACTER HEIGHT: CHARACTER HEIGHT MEASURED VERTICALLY FROM THE BASELINE OF THE CHARACTER SHALL BE 1/2" MINIMUM AND 2" MAXIMUM BASED ON THE HEIGHT OF THE UPPERCASE LETTER 'T'.
 - STROKE THICKNESS: STROKE THICKNESS OF THE UPPERCASE LETTER 'I' SHALL BE 15% MAXIMUM OF THE HEIGHT OF THE CHARACTER.
 - CHARACTER SPACING: CHARACTER SPACING SHALL BE MEASURED BETWEEN THE TWO CLOSEST POINTS OF ADJACENT RAISED CHARACTERS WITHIN A MESSAGE, EXCLUDING WORD SPACES, WHERE CHARACTERS HAVE RECTANGULAR CROSS SECTIONS. SPACING BETWEEN INDIVIDUAL RAISED CHARACTERS SHALL BE 1/2" MINIMUM AND 4 TIMES THE RAISED CHARACTER STROKE WIDTH MAXIMUM AT THE TOP OF THE CROSS SECTIONS. CHARACTERS SHALL BE SEPARATED FROM RAISED BORDERS AND DECORATIVE ELEMENTS 1/2" MIN.
 - LINE SPACING: SPACING BETWEEN THE BASELINES OF SEPARATE LINES OF RAISED CHARACTERS WITHIN A MESSAGE SHALL BE 135% MINIMUM AND 170% MAXIMUM OF THE RAISED CHARACTER HEIGHT.
 - FORMAT: TEXT SHALL BE IN A HORIZONTAL FORMAT.



- B. BRAILLE CONTRACTED (GRADE 2) PER 11B-703.3 & 11B-703.4**
- DIMENSIONS AND CAPITALIZATION: BRAILLE DOTS SHALL HAVE A DOMED OR ROUNDED SHAPE AND SHALL COMPLY WITH TABLE 11B-703.3.1. THE INDICATION OF AN UPPERCASE LETTER OR LETTERS SHALL ONLY BE USED BEFORE THE FIRST WORD OF SENTENCES, PROPER NOUNS AND NAMES, INDIVIDUAL LETTERS OF THE ALPHABET, INITIALS, AND ACRONYMS.
 - POSITION: BRAILLE SHALL BE POSITIONED BELOW THE CORRESPONDING TEXT IN A HORIZONTAL FORMAT, FLUSH LEFT OR CENTERED. IF TEXT IS MULTI-LINED, BRAILLE SHALL BE PLACED BELOW THE ENTIRE TEXT. BRAILLE SHALL BE SEPARATED 1/2" MINIMUM AND 1/2" MAXIMUM FROM ANY OTHER TACTILE CHARACTERS AND 1/2" MIN FROM RAISED BORDERS AND DECORATIVE ELEMENTS. EXCEPTION: BRAILLE PROVIDED ON ELEVATOR CAR CONTROLS SHALL BE SEPARATED BY 1/2" MINIMUM AND SHALL BE LOCATED EITHER DIRECTLY BELOW THE CORRESPONDING RAISED CHARACTERS OR SYMBOLS.

- C. VISUAL CHARACTERS PER CBC 11B-703.5**
- SHALL COMPLY WITH CBC 11B-703.2 & 11B-703.3
 - FINISH & CONTRAST: CHARACTERS AND THEIR BACKGROUND SHALL HAVE A NON-GLARE FINISH. CHARACTERS SHALL CONTRAST WITH THEIR BACKGROUND WITH EITHER LIGHT CHARACTERS ON A DARK BACKGROUND OR DARK CHARACTERS ON A LIGHT BACKGROUND.
 - STROKE THICKNESS: STROKE THICKNESS OF THE UPPERCASE LETTER 'I' SHALL BE 10% MINIMUM AND 20% MAXIMUM OF THE HEIGHT OF THE CHARACTER.


SIGN BACKGROUND (FIELD) COLOR SC1: FILL IN COLOR
SIGN TEXT/SYMBOL COLOR SC2: FILL IN COLOR

A. SIGNAGE GENERAL NOTES

MEASUREMENT RANGE	MINIMUM IN INCHES	MAXIMUM IN INCHES
DOT BASE DIAMETER	0.059 to 0.063	
DISTANCE BETWEEN TWO DOTS IN THE SAME CELL	0.100	
DISTANCE BETWEEN CORRESPONDING DOTS IN ADJACENT CELLS	0.300	
DOT HEIGHT	0.025 to 0.037	
DISTANCE BETWEEN CORRESPONDING DOTS FROM ONE CELL DIRECTLY BELOW	0.395 to 0.400	

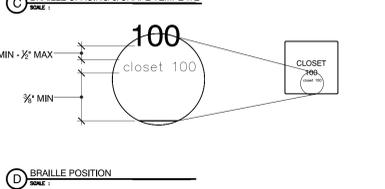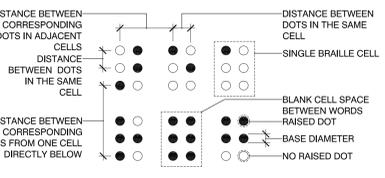

Signage General Notes & Templates

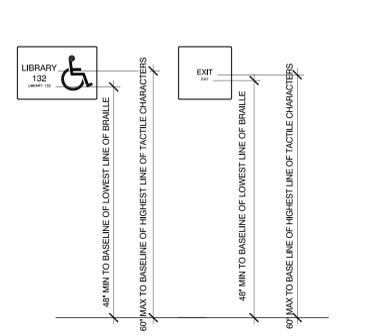

REVISION	DESCRIPTION	DATE	BY
DRAWN	PP/JL		
CHECKED	TJ		
DATE	1/18/2018		
JOB. NO.	18014		
SHEET	DETAILS		
TITLE			
SHEET			

SIGNAL POWER EXPANDER SNAC-4 (BUILDING Q)

BATTERY CALCULATIONS					
DEVICE TYPE	QTY	CURRENT STAND-BY	TOTAL CURRENT STAND-BY	CURRENT ALARM	TOTAL CURRENT ALARM
(NEW ADDED 1) HORN INDOOR	7	-	-	0.056	0.392
(EXISTING) HORN OUTDOOR	4	-	-	0.048	0.387
(EXISTING) STROBE BCD	26	-	-	0.046	1.196
(NEW ADDED 1) STROBE BCD	3	-	-	0.063	0.189
(EXISTING) STROBE MCD	1	-	-	0.063	0.187
(EXISTING) SMOKE DETECTOR	2	0.0063	0.0126	0.007	0.014
(EXISTING) SNAC-4	1	0.000	0.000	0.000	0.000
TOTAL			0.0126	0.0126	2.165

COMPUTATIONS		
TOTAL APPS USED IN STAND-BY:	0.0126 APP X 24 HOURS	= 0.3024 APP-HOUR
TOTAL APPS USED IN ALARM:	2.165 APPS X 0.000 (9 MINUTES)	= 0.195 APP-HOUR
TOTAL STAND-BY BATTERY REQUIRED:		= 1.620 APP-HOUR
TOTAL BACKUP BATTERY PROVIDED:		= 1.980 APP-HOUR
TOTAL BACKUP BATTERY REQUIRED:		= 2.03 APP-HOUR
TOTAL BACKUP BATTERY RESERVED:		= 4.58 APP-HOUR

FIRE ALARM SYSTEM LEGEND				
SYMBOL	DESCRIPTION	MODEL #	C.S.F.M. #	BACK BOX REQUIREMENTS
BD	HORN/STROBE 30CD	GENTEX GEC24-30WR	7135-0569-122	4" SQUARE DEEP BOX

WIRE CHART		
SYMBOL	CIRCUIT USE	1/2" C. & WIRE DESCRIPTION
△	SIGNALING LINE CIRCUIT (SLC)	2#14, THIN
△	NOTIFICATION CIRCUIT	4#12, THIN


SEQUENCE OF OPERATION						
DEVICE	ACTION	MANUAL PULL STATION	HOOD SUPPRESSION HOOD SWITCH	AC LOSS	TROUBLE	DUCT HEAT DETECTOR
ANNUNCIATE AT FIRE CONTROL PANEL AND REWRITE ANNUNCIATOR IF APPLICABLE		x	x	x	x	x
ANNUNCIATE AT 24 HOUR ATTACHED STATION		x	x	x	x	x
ACTIVATE AUDIBLE AND VISUAL SIGNALS THROUGHOUT BUILDING		x	x	x	x	x
SHUT-DOWN INDIVIDUAL AIR HANDLING UNITS						x
ACTIVATE INDIVIDUAL FIRE-ALARM CHIMERS						x

BUILDING Q STROBE #

VOLTAGE DROP CALCULATION			
DEVICE TYPE	QUANTITY	CURRENT ALARM	TOTAL CURRENT ALARM
(EXISTING) STROBE BCD	12	0.046	0.552
(NEW ADDED 1) STROBE BCD	2	0.063	0.126
(NEW ADDED 1) HORN	5	0.056	0.280
(EXISTING) STROBE MCD	1	0.063	0.063
TOTAL			1.021


COMPUTATIONS		
VOLTAGE DROP FORMULA	$V_{D} = I \times R$	$V_{D} = 1.021 \times 100 \times 2.6$
$V_{D} = APPS \times LENGTH \times 2.6$		$= 0.63$
$V_{D} = VD \times 100$		$V_{D} = 0.63 \times 100 = 0.63V$

BUILDING Q REVISED CALCULATIONS FROM APPROVED DSA RECORD DRAWINGS APPL #103015
 SCALE: NONE

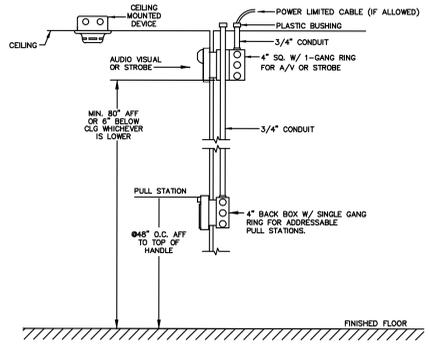

COMMON AREA MOUNTING HEIGHT & ROUGH-IN DETAIL
 SCALE: NONE

REVISED FIRE ALARM RISER, REVISED FIRE ALARM CALCULATIONS SHOWN ON THIS SHEET ARE REFERENCED FROM DSA APPROVED APPL #103015 RECORD DRAWINGS.

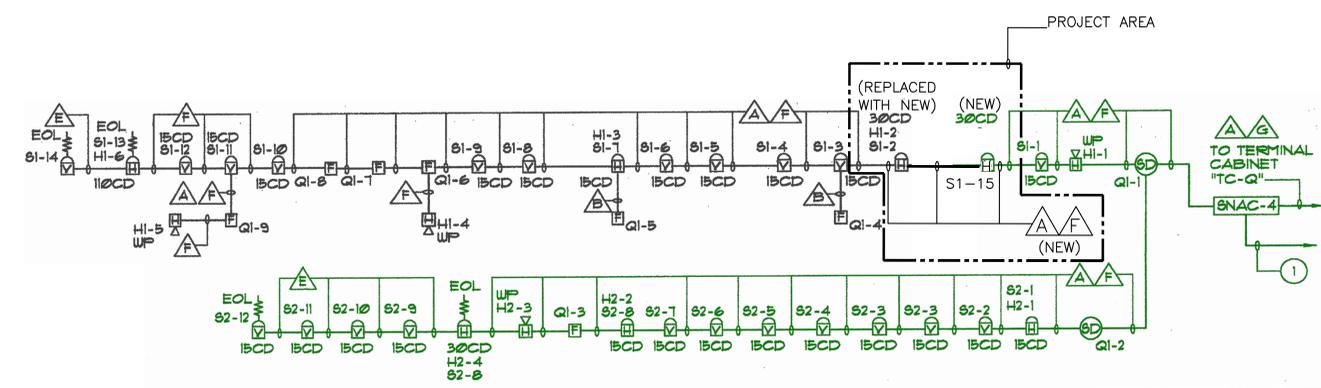

EXISTING BUILDING Q REVISED RISER DIAGRAM
 SCALE: NONE



KRUGER BENSEN ZIEMER ARCHITECTS, INC. AIA
 189 POLKMAN ST. SUITE 100A VENTURA, CA 93001
 TELEPHONE (805) 650-1033

TODD A. JESPERSEN, AIA
 PRINCIPAL ARCHITECT
JONATHAN D. LEE
 ARCHITECTURAL ASSISTANT

All ideas, design arrangements and plans included or incorporated by this drawing are owned by and are the property of Kruger-Bensen-Ziemer, AIA, architects, and were created, devised and prepared for use on, and in connection with, the specific project. None of such ideas, designs, arrangements or plans shall be used by or disclosed to any person, firm or corporation for any purpose whatsoever without the written permission of Kruger-Bensen-Ziemer.




C. HOOD & ASSOCIATES, INC.
 CONSULTING ELECTRICAL ENGINEERS

858 East Front Street Phone (805) 641-4012
 Ventura, California 93001 Fax (805) 641-0450
 www.choodassociates.com
 Copyright © 2018


REVISION	DESCRIPTION	DATE	BY
△		--/--	XX
△		--/--	XX
DRAWN: AM
 CHECKED: CH
 DATE: 3/8/2019
 JOB NO: 18014

SHEET: FIRE ALARM
 TITLE: CALCULATIONS SHEET

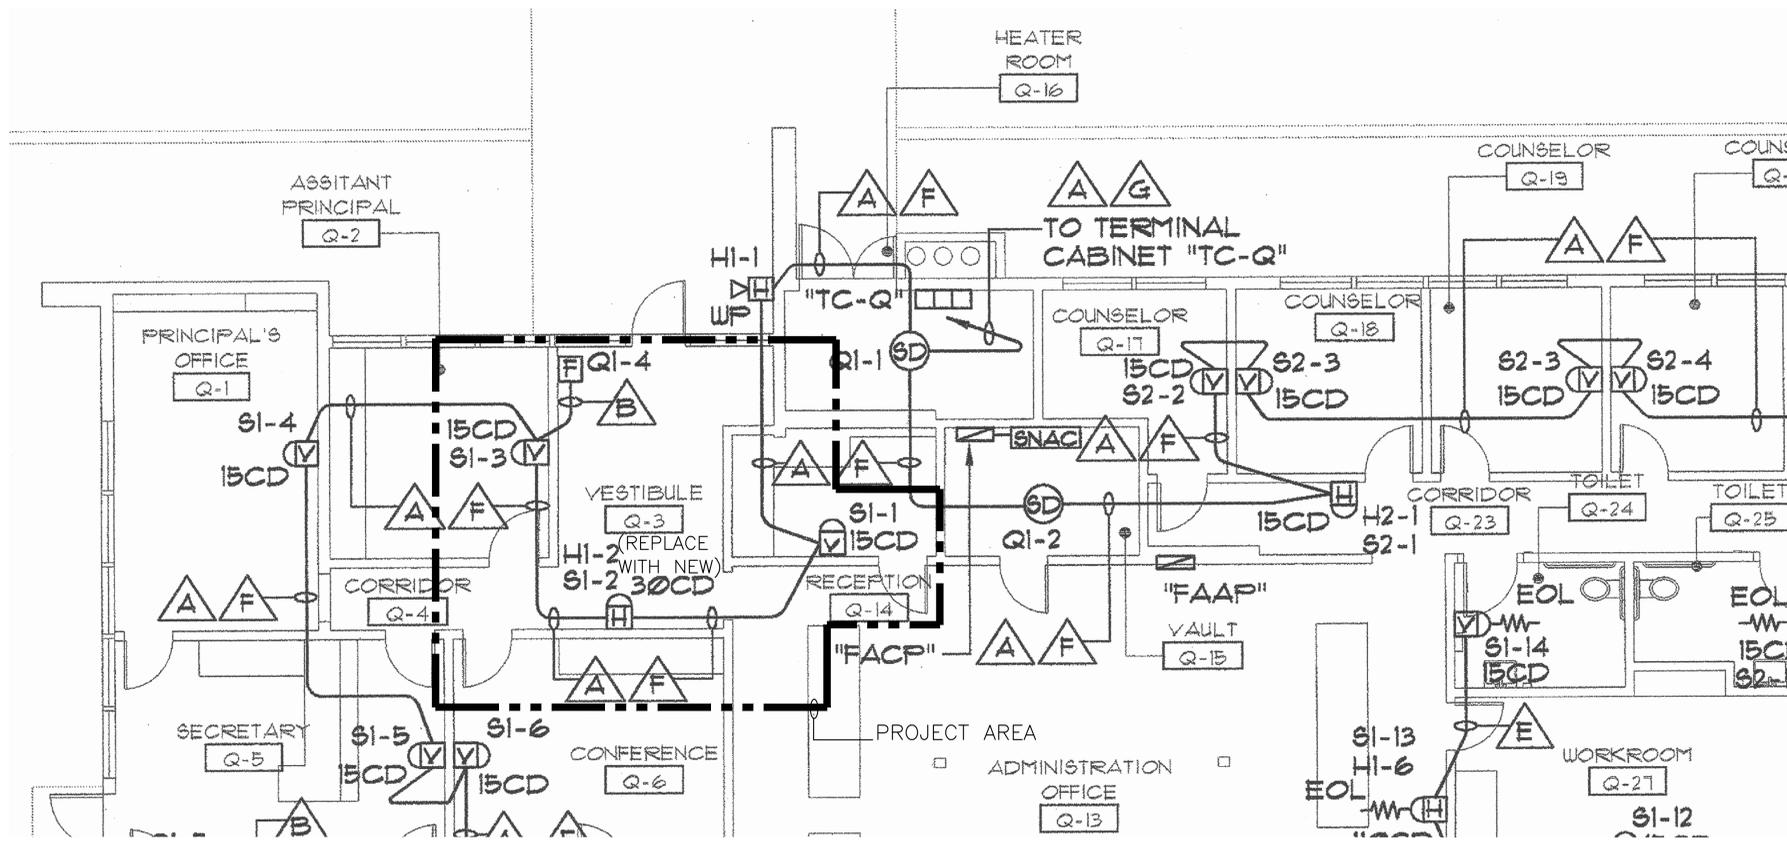

1 EXISTING FIRE ALARM PLAN
SCALE: 1/4" = 1'-0"

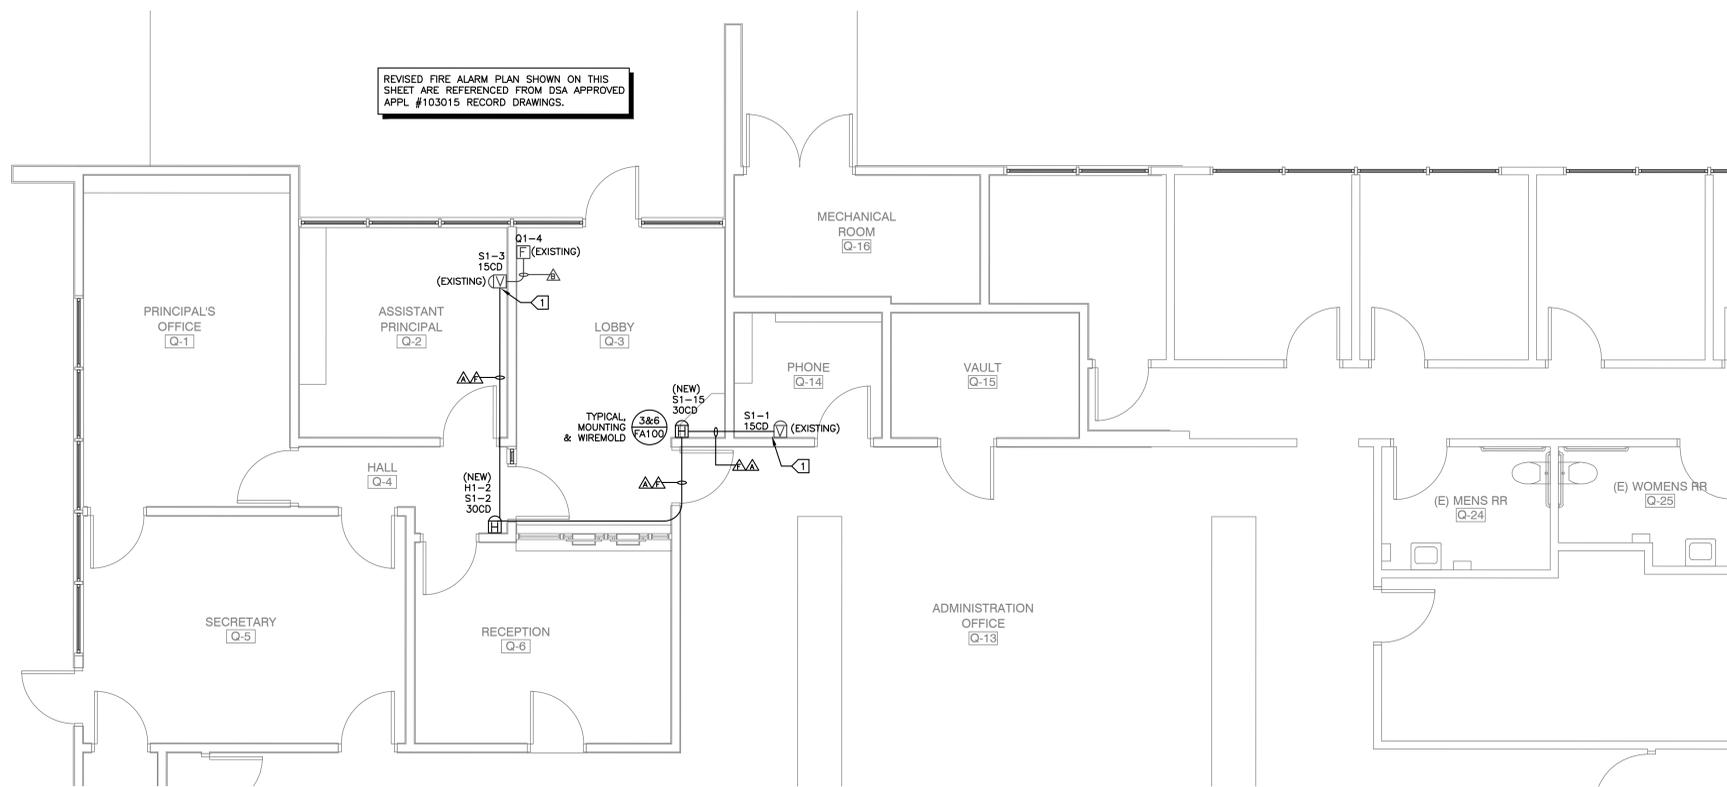

2 FIRE ALARM PLAN
SCALE: 1/4" = 1'-0"

SHEET NOTES

- CONTRACTOR SHALL PROVIDE AND INSTALL A COMPLETE FULLY AUTOMATIC FIRE ALARM & VOICE EVACUATION SYSTEM.
- FIRE ALARM WIRING SHALL BE POWER LIMITED.
- EXPOSED RACEWAYS SHALL BE WIREMOLD #2300.
- FIELD VERIFY LOCATION OF ALL DEVICES.
- 1" MINIMUM BELOW GRADE, 3/4" CONDUIT MINIMUM UNLESS OTHERWISE NOTED.

KEY NOTES

- INTERCEPT AND EXTEND EXISTING FIRE ALARM CIRCUITS TO ADD NEW FIRE ALARM DEVICES.

IDENTIFICATION STAMP
 DIV. OF THE STATE ARCHITECT
 APP. 03-119338 INC.
 REVIEWED FOR
 SS FLS ACS
 DATE: 4/2/19
 OXNARD UNION HIGH SCHOOL DISTRICT
 ADOLFO CAMARILLO HIGH SCHOOL
 4860 MISSION OAKS BLVD, OAKLAND, CA 94612
 SITE SECURITY IMPROVEMENT



KRUGER BENSON ZIEMER ARCHITECTS, INC. AIA
139 HOLBROOK ST. SUITE 100A VENTURA, CA 93001
TELEPHONE (805) 650-1053

TODD A. JESPERSEN, AIA
PRINCIPAL ARCHITECT

JONATHAN D. LEE
ARCHITECTURAL ASSISTANT

All ideas, design arrangements and plans indicated or represented by this drawing are owned by and are the property of KrugerBensonZiemer. All architects, and were created, copied and developed for use on, and in connection with, the specified project. None of such ideas, design, arrangements or plans shall be used by or disclosed to any person, firm or corporation for any purpose whatsoever without the written permission of KrugerBensonZiemer.



858 East Front Street Phone (805) 641-4013
Ventura, California 93001 Fax (805) 641-0450
www.choodassociates.com
Copyright © 2018

REVISION	DESCRIPTION	DATE	BY
1			

DRAWN: AM
CHECKED: CH
DATE: 3/8/2019
JOB NO.: 18014

SHEET: FIRE ALARM DEMO PLAN
TITLE: FIRE ALARM PLAN

