

Verizon

Visual Improvement Program

Revised for Plan Check 10/05/2012

1800 Solar Drive
Oxnard, CA 93030

06.8740.000

Gensler

Architect
1230 Avenue of the Americas
Suite 1500
New York, NY 10020
Telephone 212.492.1400
Facsimile 212.492.1472




SYSKA HENNESSY
GROUP

A member company of SH Group, Inc.


MEP Engineer
800 Corporate Pointe
Suite 200
Culver City, CA 90230
Telephone: 310.312.0200
Fax: 310.473.7468

DEPARTMENT OF BUILDING NOTES

VICINITY MAP

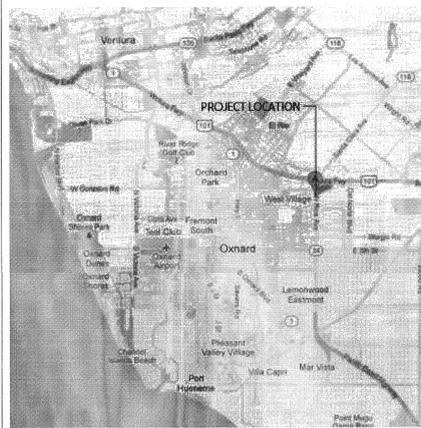

LOCATION MAP

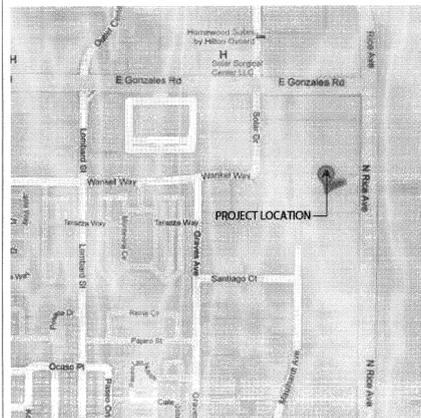

ASBESTOS NOTE

IN THE EVENT OF ASBESTOS OR OTHER TOXIC SUBSTANCE EXPOSURE OR THE SUBSTANTIAL RISK THEREOF, CLIENT WILL HAVE THE DUTY TO INFORM ARCHITECT OF SUCH RISKS KNOWN OR REASONABLY KNOWN TO CLIENT. IF ASBESTOS OR ANY OTHER TOXIC SUBSTANCE, OR RISKS TO EXPOSURE THEREOF IS DISCOVERED BY ARCHITECT DURING WORK ON THE PROJECT, ARCHITECT SHALL, IN ITS SOLE DISCRETION, HAVE THE RIGHT TO SUSPEND WORK ON THE PROJECT. CLIENT SHALL HAVE THE DUTY PROMPTLY TO RETAIN A QUALIFIED EXPERT SAFELY TO RENDER OR SUPERVISE THE REMOVAL OF SUCH ASBESTOS OR OTHER TOXIC SUBSTANCE. CLIENT SHALL INDEMNIFY AND HOLD ARCHITECT, ITS AFFILIATES AND SUB-CONTRACTORS, AND THEIR OFFICERS, AGENTS AND EMPLOYEES HARMLESS FROM ANY AND ALL LIABILITY ON PART OF OR DAMAGE TO SUCH ENTITIES OR PERSONS, INCLUDING THE COST OF LEGAL FEES AND EXPENSES, AS SUCH FEES AND EXPENSES ARE INCURRED, WHICH MAY RESULT FROM ASBESTOS OR OTHER TOXIC SUBSTANCE EXPOSURE ON THE PROJECT.

PROJECT DESCRIPTION

THIS PROJECT OCCUPIES PORTIONS OF THE GROUND, SECOND AND THIRD FLOOR AND IS A SINGLE TENANT RENOVATION INCLUDING ARCHITECTURAL, MECHANICAL, ELECTRICAL AND PLUMBING MODIFICATIONS. SCOPE OF WORK INCLUDES NEW FINISHES IN BATHROOMS, NEW FINISHES AND MILLWORK IN GROUND FLOOR LOBBY AND CAFETERIA, DEMOLITION OF EXISTING ELEVATOR LOBBIES AND BREAK ROOMS ON SECOND AND THIRD FLOORS, NEW CONFERENCE ROOMS, QUIET ROOMS, AND PANTRY ON SECOND AND THIRD FLOORS, NEW EXTERIOR SIGN AT MAIN PARKING ENTRY.

PROJECT INFORMATION

BUILDING ADDRESS: 1800 SOLAR DRIVE, OXNARD, CA 93030
 OCCUPANCY TYPE: BUSINESS (B)
 AREA OF WORK: 17,075 SF
 FIRE PROTECTION: FULLY SPRINKLERED
 CONSTRUCTION TYPE: IA
 SEISMIC ZONE: ZONE 4

APPLICABLE CODES

- INTERNATIONAL BUILDING CODE 2009 (CALIFORNIA BUILDING CODE 2010)
- OXNARD ORDINANCE #2383
- CALIFORNIA BUILDING STANDARDS CODE
- NATIONAL ELECTRICAL CODE 2005 (CALIFORNIA ELECTRICAL CODE 2007)
- INTERNATIONAL FIRE CODE 2006 (CALIFORNIA FIRE CODE 2007)
- NFPA VOLS 1-12
- CALIFORNIA BUILDING CODE 2007 (TITLE 24, PART 2)
- CALIFORNIA ENERGY CODE 2008

DRAWING INDEX

	NEW ISSUE	REVISED ISSUE	ISSUED WITH NO CHANGES	REMOVED FROM SET - NOT ISSUED	REMARKS
ARCHITECTURAL					
A00.00_SD					COVER SHEET
A00.10_SD					DRAWING INDEX, LOCATION MAP, PROJECT INFORMATION, TYPICAL CEILING DETAIL, & BUILDING DEPT. NOTES.
A00.01_SD					GRAPHIC SYMBOLS
A00.10_SD					NOTES, TYPICAL MOUNTING HEIGHTS
A00.11_SD					ACCESSIBILITY DIAGRAMS
A00.20_SD					PARTITION TYPES
A00.21_SD					PARTITION TYPES
A00.30_SD					SITE PLAN
A00.60_SD					GROUND FLOOR EGRESS PLAN
A00.61_SD					SECOND FLOOR EGRESS PLAN
A00.62_SD					THIRD FLOOR EGRESS PLAN
A01.01_SD					FIRST FLOOR DEMOLITION PLAN
A01.02_SD					SECOND FLOOR DEMOLITION PLAN
A01.03_SD					THIRD FLOOR DEMOLITION PLAN
A02.01_SD					FIRST FLOOR CONSTRUCTION PLAN
A02.02_SD					SECOND FLOOR CONSTRUCTION PLAN
A02.03_SD					THIRD FLOOR CONSTRUCTION PLAN
A08.01_SD					ENTRY KIOSK DETAILS
A08.02_SD					ENTRY KIOSK DETAILS
A08.04_SD					RECEPTION DESK DETAILS
A08.40_SD					ENLARGED PLANS
A08.41_SD					ENLARGED PLANS
A08.77_SD					CAFETERIA ENLARGED PLANS
A08.78_SD					CAFETERIA ENLARGED PLANS
A08.81_SD					TYPICAL RESTROOM DETAILS
A11.00_SD					INTERIOR ELEVATIONS
A12.00_SD					TYPICAL GLASS FRONT AND PLAN DETAILS
A12.10_SD					TYPICAL CEILING DETAILS
A12.20_SD					TYPICAL MILLWORK DETAILS
A12.21_SD					TYPICAL MILLWORK DETAILS
A12.25_SD					CAFETERIA MILLWORK DETAILS
A13.03_SD					EXTERIOR SIGNAGE MONUMENT DETAILS
FIRE PROTECTION					
P-001					NOTES, SYMBOLS AND ABBREVIATIONS
P-002					PLUMBING SPECIFICATIONS
P-101					PARTIAL 1ST FLOOR PLUMBING PLAN
P-102					PARTIAL 2ND FLOOR PLUMBING PLAN
P-103					PARTIAL 3RD FLOOR PLUMBING PLAN
MECHANICAL					
M-001					MECHANICAL COVER SHEET
M-002					MECHANICAL SPECIFICATIONS
M-003					TITLE 24
M-101					PARTIAL MECHANICAL PLAN FIRST FLOOR
M-102					PARTIAL MECHANICAL PLAN SECOND FLOOR
M-103					PARTIAL MECHANICAL PLAN THIRD FLOOR
M-801					MECHANICAL DETAILS
M-701					MECHANICAL SCHEDULES
ELECTRICAL					
E-001					MECHANICAL COVER SHEET
E-002					SPECIFICATION
E-003					TITLE 24 COMPLIANCE SCHEDULES
E-101					1ST FLOOR OVERALL PLAN
E-102					2ND FLOOR OVERALL PLAN
E-103					3RD FLOOR OVERALL PLAN
EL-401					1ST FLOOR PARTIAL DEMOLITION AND LIGHTING PLAN
EL-402					2ND AND 3RD FLOOR PARTIAL LIGHTING PLAN
ELD-401					2ND AND 3RD FLOOR PARTIAL LIGHTING AND DEMOLITION PLANS
EP-401					1ST FLOOR PARTIAL DEMOLITION AND POWER PLAN
EP-402					2ND AND 3RD FLOOR PARTIAL POWER PLANS
EPD-401					2ND AND 3RD FLOOR PARTIAL POWER DEMOLITION PLANS
E-501					ELECTRICAL DETAILS
E-601					SINGLE LINE DIAGRAM
E-701					PANEL SCHEDULES
E-702					PANEL SCHEDULES
E-703					PANEL SCHEDULES
IT					
AUDIO VISUAL					
SECURITY					



1800 Solar Drive
Oxnard, CA 93030

1230 Avenue of the Americas
Suite 1500
New York, NY 10020
Telephone: 212.492.1400
Facsimile: 212.492.1472

Gensler



Syska Hennessy Group, Inc.
800 Corporate Pointe
Suite 200
Culver City, CA 90230
Telephone: 310.312.0200
Fax: 310.473.7468

Issue	Date & Issue Description	By	Check
01	06/22/12 PROGRESS SET	SJ	SJ
02	07/31/12 Issued for Plan Check	ES/MC	SJ
1	03 08/10/12 ISSUED FOR CONSTRUCTION	ES/MC	SJ
2	04 08/12/12 BULLETIN # 1	ES/MC	SJ
3	05 10/05/12 REVISED FOR PLAN CHECK COMMENTS	ES/MC	SJ



Project Name: VERIZON V.I.P.
 Project Number: 06.8740.000
 CAD File Name: A00-00
 Description: INDEX
 Scale:

A00.00_SD

GRAPHIC SYMBOLS (CONT.)

ELEVATION INDICATION

- GLASS SYMBOL
- MASONRY COURSING
- WOOD VENEER
- STONE

SECTION INDICATIONS

- ACOUSTICAL CEILING TILE
- ALUMINUM
- BRICK
- CARPET
- CONCRETE
- CONCRETE MASONRY UNIT
- CUTSTONE
- EARTH OR GROUND
- FABRIC WRAPPED PANEL
- GLASS
- GRAVEL
- GYPSUM BOARD
- INSULATION (LOOSE OR BATT)
- INSULATION (RIGID)
- METAL
- PLASTER
- PLASTERLATH
- PLYWOOD
- PRE-CAST PANELS
- SAND OR GROUT
- STONE
- WOOD (FINISHED)
- WOOD (CONTINUOUS MEMBER)
- WOOD (INTERRUPTED MEMBER)

GRAPHIC SYMBOLS (CONT.)

REFLECTED CEILING

- ACOUSTICAL CEILING AND GRID
 - CEILING HEIGHT CHANGE SYMBOL
 - FINISH CEILING HEIGHT SYMBOL
 - GRID STARTPOINT SYMBOL
 - CEILING FINISH TAG
 - MOTION SENSOR
 - CEILING MOUNTED SPEAKER
 - CEILING MOUNTED CAMERA
 - CEILING MOUNTED SPRINKLER HEAD
 - CEILING MOUNTED SMOKE DETECTOR
 - CEILING MOUNTED EXIT SIGN
 - WALL MOUNTED EXIT SIGN
 - DENOTES EXISTING TO REMAIN
 - DENOTES EXISTING TO BE RELOCATED
- LIGHT FIXTURES**
- FLUORESCENT LIGHT FIXTURE
 - FLUORESCENT LIGHT FIXTURE / EMERGENCY CIRCUIT
 - EXISTING LIGHT FIXTURE TO BE REMOVED
 - UNDER CABINET FLORESCENT FIXTURE
 - FLUORESCENT STRIP FIXTURE
 - FLUORESCENT PENDANT FIXTURE
 - RECESSED DOWNLIGHT
 - RECESSED ADJUSTABLE DOWNLIGHT
 - RECESSED WALL WASHER
 - TRACK LIGHTING
 - SURFACE MOUNTED LIGHT FIXTURE
 - WALL SCONCE
 - LIGHT SWITCH
 - DIMMER SWITCH
- MECHANICAL FIXTURES**
- RETURN AIR
 - SUPPLY AIR
 - CIRCULAR DIFFUSER
 - LINEAR DIFFUSER
 - EXHAUST FAN
 - FIRE SPRINKLER
 - ACCESS DOOR

GRAPHIC SYMBOLS (CONT.)

POWER AND COMMUNICATION, CONT

- SURFACE FLOOR MOUNTED, POKE THRU DEVICES**
- SURFACE FLOOR MOUNTED, POKE THRU, SINGLE RECEPTACLE
 - SURFACE FLOOR MOUNTED, POKE THRU, DUPLEX RECEPTACLE
 - SURFACE FLOOR MOUNTED, POKE THRU, QUADRAPLEX RECEPTACLE
 - SURFACE FLOOR MOUNTED, POKE THRU, COMBINATION DUPLEX & VOICE/DATA RECEPTACLE
 - SURFACE FLOOR MOUNTED, POKE THRU, COMBINATION QUADRAPLEX & VOICE/DATA RECEPTACLES
 - SURFACE FLOOR MOUNTED, POKE THRU, COMBINATION DUPLEX, AUDIO VISUAL AND VOICE/DATA RECEPTACLES
 - SURFACE FLOOR MOUNTED, POKE THRU, COMBINATION QUADRAPLEX, AV & VOICE/DATA RECEPTACLES
 - SURFACE FLOOR MOUNTED, POKE THRU, VOICE/DATA RECEPTACLE
 - SURFACE FLOOR MOUNTED, POKE THRU, DATA RECEPTACLE
 - SURFACE FLOOR MOUNTED, POKE THRU, VOICE RECEPTACLE
 - SURFACE FLOOR MOUNTED, POKE THRU, AV RECEPTACLE
 - SURFACE FLOOR MOUNTED, POKE THRU, SYSTEMS WORKSTATION PANEL POWER INFEEED
 - SURFACE FLOOR MOUNTED, POKE THRU, SYSTEMS WORKSTATION PANEL VOICE INFEEED
- FURNITURE SYSTEMS MOUNTED DEVICES**
- FURNITURE SYSTEMS MOUNTED, SINGLE RECEPTACLE
 - FURNITURE SYSTEMS MOUNTED, DUPLEX RECEPTACLE
 - FURNITURE SYSTEMS MOUNTED, QUADRAPLEX RECEPTACLE
 - FURNITURE SYSTEMS MOUNTED, VOICE/DATA RECEPTACLE
 - FURNITURE SYSTEMS MOUNTED, DATA RECEPTACLE
 - FURNITURE SYSTEMS MOUNTED, VOICE RECEPTACLE
 - FURNITURE SYSTEM ELECTRIC PIGTAIL
 - FURNITURE MOUNTED, POWER POLE
- SECURITY DEVICES**
- CARD READER
 - ELECTRIC DOOR BELL PUSH
 - ELECTRIC DOOR BELL
 - INTERCOM
 - REMOTE DOOR RELEASE BUTTON
 - MOTION SENSOR
 - INTRUSION ALARM
 - ELECTRIC DOOR HINGE
 - ELECTRIC DOOR HOLD OPEN
 - ELECTRICAL DOOR RELEASE
 - ELECTRICAL DOOR MONITOR CONTACT
 - DOUBLE DOOR MONITOR CONTACT
 - ELECTRIC LOCKSET
 - ELECTRIC KEY SWITCH
 - ELECTRIC STRIKE
 - MAGNETIC LOCKSET

GRAPHIC SYMBOLS (CONT.)

POWER AND COMMUNICATION

- WALL MOUNTED DEVICES**
- EQUIPMENT TAG (REFER TO EQUIPMENT SCHEDULE)
 - WALL MOUNTED FIRE ALARM STROBE
 - FIRE ALARM PULL
 - FIRE WARDEN STATION
 - WALL MOUNTED, SINGLE RECEPTACLE
 - WALL MOUNTED, DUPLEX RECEPTACLE
 - WALL MOUNTED, QUADRAPLEX RECEPTACLE
 - WALL MOUNTED, VOICE/DATA RECEPTACLE
 - WALL MOUNTED, DATA RECEPTACLE
 - WALL MOUNTED, VOICE RECEPTACLE
 - WALL MOUNTED, THERMOSTAT
 - WALL MOUNTED, CABLE TV RECEPTACLE
 - WALL MOUNTED, AV RECEPTACLE
 - WALL MOUNTED, AV TROUGH
 - WALL MOUNTED, ELECTRICAL JUNCTION BOX
 - WALL MOUNTED, VOICE/DATA JUNCTION BOX
 - WALL MOUNTED, SYSTEMS WORKSTATION PANEL POWER INFEEED
 - WALL MOUNTED, SYSTEMS WORKSTATION PANEL VOICE/DATA INFEEED
 - WALL MOUNTED, CONDUIT STUB-OUT POWER
 - WALL MOUNTED, CONDUIT STUB-OUT VOICE AND DATA
 - WALL MOUNTED, CONDUIT STUB-OUT AV
 - WALL MOUNTED, PLUG MOLD
- FLUSH FLOOR MOUNTED DEVICES**
- FLUSH FLOOR MOUNTED, SINGLE RECEPTACLE
 - FLUSH FLOOR MOUNTED, DUPLEX RECEPTACLE
 - FLUSH FLOOR MOUNTED, QUADRAPLEX RECEPTACLE
 - FLUSH FLOOR MOUNTED, COMBINATION DUPLEX & VOICE/DATA RECEPTACLES
 - FLUSH FLOOR MOUNTED, COMBINATION DUPLEX, AUDIO VISUAL AND VOICE/DATA RECEPTACLES
 - FLUSH FLOOR MOUNTED, COMBINATION QUADRAPLEX, AV & VOICE/DATA RECEPTACLES
 - FLUSH FLOOR MOUNTED, VOICE/DATA RECEPTACLE
 - FLUSH FLOOR MOUNTED, DATA RECEPTACLE
 - FLUSH FLOOR MOUNTED, VOICE RECEPTACLE
 - FLUSH FLOOR MOUNTED, SYSTEMS WORKSTATION PANEL POWER INFEEED
 - FLUSH FLOOR MOUNTED, SYSTEMS WORKSTATION PANEL VOICE INFEEED
 - FLUSH FLOOR MOUNTED, AV RECEPTACLE
 - FLUSH FLOOR MOUNTED, RAISED FLOOR BOX, COMBINATION POWER, VOICE/DATA, AV
 - FLUSH FLOOR MOUNTED, RAISED FLOOR BOX, AV
- FLUSH FLOOR MOUNTED, POKE THRU DEVICES**
- FLUSH FLOOR MOUNTED, POKE THRU, SINGLE RECEPTACLE
 - FLUSH FLOOR MOUNTED, POKE THRU, DUPLEX RECEPTACLE
 - FLUSH FLOOR MOUNTED, POKE THRU, QUADRAPLEX RECEPTACLE
 - FLUSH FLOOR MOUNTED, POKE THRU, COMBINATION DUPLEX & VOICE/DATA RECEPTACLE
 - FLUSH FLOOR MOUNTED, POKE THRU, COMBINATION QUADRAPLEX & VOICE/DATA RECEPTACLES
 - FLUSH FLOOR MOUNTED, POKE THRU, COMBINATION DUPLEX, AUDIO VISUAL AND VOICE/DATA RECEPTACLES
 - FLUSH FLOOR MOUNTED, POKE THRU, COMBINATION QUADRAPLEX, AV & VOICE/DATA RECEPTACLES
 - FLUSH FLOOR MOUNTED, POKE THRU, VOICE/DATA RECEPTACLE
 - FLUSH FLOOR MOUNTED, POKE THRU, DATA RECEPTACLE
 - FLUSH FLOOR MOUNTED, POKE THRU, VOICE RECEPTACLE
 - FLUSH FLOOR MOUNTED, POKE THRU, AV RECEPTACLE
 - FLUSH FLOOR MOUNTED, POKE THRU, SYSTEMS WORKSTATION PANEL POWER INFEEED
 - FLUSH FLOOR MOUNTED, POKE THRU, SYSTEMS WORKSTATION PANEL VOICE INFEEED
- SURFACE FLOOR MOUNTED DEVICES**
- SURFACE FLOOR MOUNTED, SINGLE RECEPTACLE
 - SURFACE FLOOR MOUNTED, DUPLEX RECEPTACLE
 - SURFACE FLOOR MOUNTED, QUADRAPLEX RECEPTACLE
 - SURFACE FLOOR MOUNTED, COMBINATION DUPLEX & VOICE/DATA RECEPTACLE
 - SURFACE FLOOR MOUNTED, COMBINATION QUADRAPLEX & VOICE/DATA RECEPTACLES
 - SURFACE FLOOR MOUNTED, COMBINATION DUPLEX, AUDIO VISUAL AND VOICE/DATA RECEPTACLES
 - SURFACE FLOOR MOUNTED, COMBINATION QUADRAPLEX, AV & VOICE/DATA RECEPTACLES
 - SURFACE FLOOR MOUNTED, VOICE/DATA RECEPTACLE
 - SURFACE FLOOR MOUNTED, DATA RECEPTACLE
 - SURFACE FLOOR MOUNTED, VOICE RECEPTACLE
 - SURFACE FLOOR MOUNTED, AV RECEPTACLE
 - SURFACE FLOOR MOUNTED, SYSTEMS WORKSTATION PANEL POWER INFEEED
 - SURFACE FLOOR MOUNTED, SYSTEMS WORKSTATION PANEL VOICE INFEEED
 - SURFACE FLOOR MOUNTED, CONDUIT STUB UP, AV
 - SURFACE FLOOR MOUNTED, CONDUIT STUB UP, POWER
 - SURFACE FLOOR MOUNTED, CONDUIT STUB UP, VOICE/DATA

GRAPHIC SYMBOLS (CONT.)

CONSTRUCTION (CONT.)

- OFFICE**
- OFFICE 1A25
- ROOM NAME**
- SHEETNOTE REFERENCE
 - WALL TYPE REFERENCE
 - DOOR REFERENCE NUMBER (REFER TO DOOR SCHEDULE)
 - DOOR TYPE
 - HARDWARE TYPE
 - DOOR NUMBER
 - DOOR TYPE | HARDWARE TYPE
- WINDOW REFERENCE NUMBER (REFER TO WINDOW SCHEDULE)**
- WINDOW REFERENCE NUMBER (REFER TO WINDOW SCHEDULE)
 - WINDOW REFERENCE NUMBER (REFER TO WINDOW SCHEDULE)
- MILLWORK REFERENCE NUMBER (REFER TO MILLWORK SCHEDULE)**
- MILLWORK REFERENCE NUMBER (REFER TO MILLWORK SCHEDULE)
- ELEVATION DATUM REFERENCE**
- MATCH LINE SYMBOL
 - ALIGN WITH ESTABLISHED SURFACES
- WALL MOUNTED LIFE SAFETY EQUIPMENT AND DEVICES**
- FIRE WARDEN STATION SYMBOL
 - WALL MOUNTED FIRE ALARM STROBE SYMBOL
 - FIRE ALARM PULL SYMBOL
 - WALL MOUNTED, FIRE EXTINGUISHER CABINET
 - WALL MOUNTED FIRE EXTINGUISHER
 - WALL MOUNTED FIRE HOSE CABINET
 - WALL MOUNTED FIRE VALVE
 - WALL MOUNTED FIRE VALVE CABINET
- FINISH**
- WALL FINISH
 - BASE FINISH
 - WALL FINISH
 - WALL FINISH
 - WAISCOLT FINISH
 - BASE FINISH
 - EXTENT OF WALL/WAINSCOT/BASE FINISH
 - SPECIAL FINISH
 - FLOOR FINISH
 - CHANGE IN FLOOR FINISH

GRAPHIC SYMBOLS

CONSTRUCTION

- COLUMN GRID REFERENCE NUMBER
- COLUMN GRID LINES AND REFERENCE NUMBER
- EXISTING CONSTRUCTION TO REMAIN
- EXISTING CONSTRUCTION TO BE DEMOLISHED
- NEW PARTITION
- 1 HR. RATED PARTITION
- 2 HR. RATED PARTITION
- 3 HR. RATED PARTITION
- 4 HR. RATED PARTITION
- SMOKE PARTITION
- EGRESS PATH PRIMARY
- EGRESS PATH SECONDARY
- MILLWORK ABOVE
- DETAIL NUMBER
- SHEET NUMBER
- DESCRIPTION OF SIMILAR OR OPPOSITE
- FLOOR NUMBER AND AREA OR PHASE
- AREA TO BE DETAILED
- LOCATION ON ROW WHERE ELEVATION IS SHOWN
- DIRECTION OF ELEVATION
- ROW ON SHEET WHERE ELEVATION IS SHOWN
- SHEET NUMBER WHERE ELEVATION IS SHOWN
- REVISION REFERENCE NUMBER
- REVISION CLOUD DEPICTING ARE REVISED



1800 Solar Drive
Oxnard, CA 93030

Gensler



1230 Avenue of the Americas
Suite 1500
New York, NY 10020
Telephone: 212.492.1400
Facsimile 212.492.1472

Syska Hennessy Group, Inc.
800 Corporate Pointe
Suite 200
Culver City, CA 90230
Telephone: 310.312.0200
Fax: 310.473.7468

Issue	Date & Issue Description	By	Check
01	08/22/12 PROGRESS SET	SJ	SJ
02	07/31/12 Issued for Plan Check	ESIMC	SJ
1	03 08/10/12 ISSUED FOR CONSTRUCTION	ESIMC	SJ
3	04 10/09/12 REVISED FOR PLAN CHECK COMMENTS	ESIMC	SJ




Project Name
VERIZON V.I.P.

Project Number
06.8740.000
CAD File Name
A00-01
Description
GRAPHIC SYMBOLS


Scale

A00.01_SD

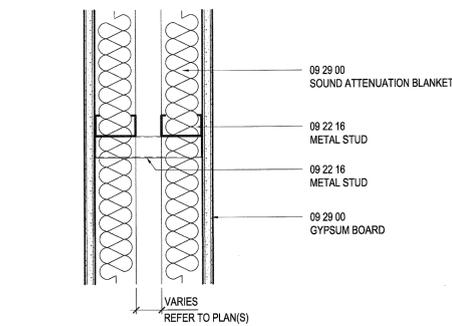


PARTITION TYPE	MTL THICKNESS	STUD SPACING	GYP BD THICKNESS	ATTENUATION THICKNESS	HEAD OF WALL DETAIL	BOTTOM OF WALL DETAIL	FIRE RATING	TESTED ASSEMBLY NUMBER	STC RATING
K3F	.032	16"	5/8"	3"	HWK1	BWK1	-	-	-

REMARKS:

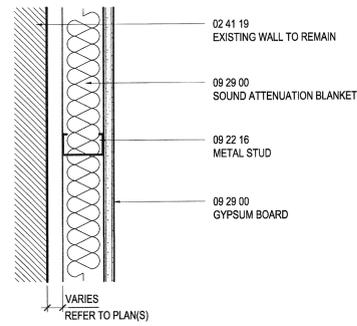

PARTITION TYPE	MTL THICKNESS	STUD SPACING	GYP BD THICKNESS	ATTENUATION THICKNESS	HEAD OF WALL DETAIL	BOTTOM OF WALL DETAIL	FIRE RATING	TESTED ASSEMBLY NUMBER	STC RATING
D3E	.032	16"	5/8"	3"	HWD7/8	BWD1	-	-	-

REMARKS:

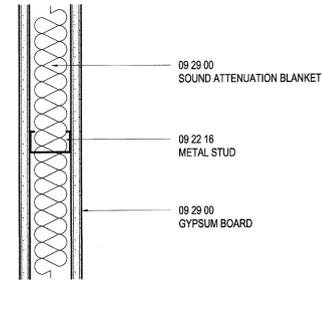


PARTITION TYPE	MTL THICKNESS	STUD SPACING	GYP BD THICKNESS	ATTENUATION THICKNESS	HEAD OF WALL DETAIL	BOTTOM OF WALL DETAIL	FIRE RATING	TESTED ASSEMBLY NUMBER	STC RATING
A3C	.032	16"	5/8"	3"	HWA3	BWA1	-	-	-

REMARKS:

PARTITION PLAN TYPE K
SCALE: 3" = 1'-0"


PARTITION PLAN TYPE D
SCALE: 3" = 1'-0"

PARTITION PLAN TYPE A
SCALE: 3" = 1'-0"

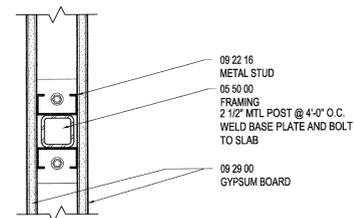


PARTITION TYPE	MTL THICKNESS	STUD SPACING	GYP BD THICKNESS	ATTENUATION THICKNESS	HEAD OF WALL DETAIL	BOTTOM OF WALL DETAIL	FIRE RATING	TESTED ASSEMBLY NUMBER	STC RATING
H2L	.032	16"	5/8"	-	HWA10	BWL1	-	-	-

REMARKS:

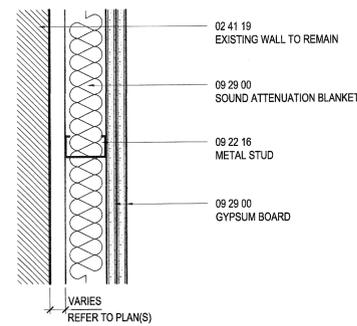

PARTITION TYPE	MTL THICKNESS	STUD SPACING	GYP BD THICKNESS	ATTENUATION THICKNESS	HEAD OF WALL DETAIL	BOTTOM OF WALL DETAIL	FIRE RATING	TESTED ASSEMBLY NUMBER	STC RATING
E3C	.032	16"	5/8"	3"	HWE3	BWE1	-	-	-

REMARKS:

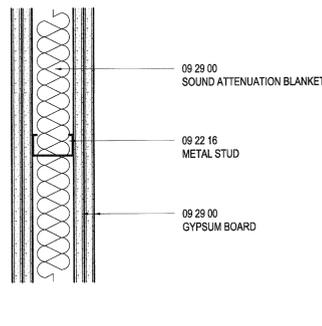

PARTITION TYPE	MTL THICKNESS	STUD SPACING	GYP BD THICKNESS	ATTENUATION THICKNESS	HEAD OF WALL DETAIL	BOTTOM OF WALL DETAIL	FIRE RATING	TESTED ASSEMBLY NUMBER	STC RATING
B3C	.032	16"	5/8"	3"	HWB3	BWB1	-	-	-


REMARKS:

PARTITION PLAN TYPE H
SCALE: 3" = 1'-0"

PARTITION PLAN TYPE E
SCALE: 3" = 1'-0"

PARTITION PLAN TYPE B
SCALE: 3" = 1'-0"

SHEET NOTES

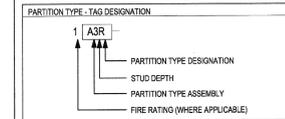

TYPE	STRUCTURAL ASSEMBLY	STUD	SHEATHING
A	1-LAYER	METAL C-STUD	1-LAYER
B	2-LAYERS	METAL C-STUD	2-LAYERS
C	2-LAYERS	METAL C-STUD	1-LAYER
D	1-LAYER	METAL C-STUD	NONE
E	2-LAYERS	METAL C-STUD	NONE
F	1-LAYER	HAT CHANNEL	NONE
G	1-LAYER	LAMINATED	NONE
H	1-LAYER	METAL CH STUD	1-LAYER
J	2-LAYERS	METAL CH STUD	1-LAYER
K	1-LAYER	METAL CH STUD (2)	1-LAYER
L	2-LAYERS	METAL CH STUD (2)	2-LAYERS
M	1-LAYER	MASONRY WALL	
NZ	FOR FUTURE EXPANSION		
WA	1-LAYER	WOOD STUD	1-LAYER
WB	2-LAYERS	WOOD STUD	2-LAYERS
WC	2-LAYERS	WOOD STUD	1-LAYER
WD	1-LAYER	WOOD STUD	NONE
WE	2-LAYERS	WOOD STUD	NONE
WK	1-LAYER	WOOD STUD (2)	1-LAYER
WL	2-LAYERS	WOOD STUD (2)	2-LAYERS

TAG NUMBER	MTL STUD DEPTH	MTL CH STUD DEPTH	WOOD STUD DEPTH	CMU WIDTH
0	NO FRAMING REQUIRED			
1	1 5/8"	2 1/2"	4"	9 5/8"
2	2 1/2"	2 1/2"	4"	11 5/8"
3	3 5/8"	4"	4"	3 5/8"
4	4"	4"	4"	5 5/8"
6	8"	8"	8"	5 5/8"
7	7/8" FURRING CHANNEL			
8	7 5/8"			

*THE DEPTH DESIGNATIONS 1 AND 2 ARE USED FOR 9 5/8" AND 11 5/8" BLOCKS RESPECTIVELY

TYPE	DESCRIPTION
F	FULL HEIGHT PARTITION
C	8" ABOVE FINISHED CEILING-SLAB TO 8" ABOVE
W	WATER RESISTANT GYPSUM BOARD-SLAB TO SLAB
R	RATED WALL
A	RAISED FLOOR - SLAB
B	RAISED FLOOR - 8" ABOVE CEILING
Q	RAISED FLOOR - UNDERSIDE OF CEILING
E	SLAB - UNDERSIDE OF CEILING
L	LOW HEIGHT PARTITION



1800 Solar Drive
Oxnard, CA 93030

1230 Avenue of the Americas
Suite 1500
New York, NY 10020
Telephone: 212.492.1400
Facsimile: 212.492.1472



Syska Hennessy Group, Inc.
800 Corporate Pointe
Suite 200
Culver City, CA 90230
Telephone: 310.312.0200
Fax: 310.473.7468

Issue	Date & Issue Description	By	Check
01	06/22/12 PROGRESS SET	SJ	SJ
02	07/31/12 Issued for Plan Check	ESIMC	SJ
1	03 08/10/12 ISSUED FOR CONSTRUCTION	ESIMC	SJ
2	04 09/12/12 BULLETIN #1	ESIMC	SJ
3	05 10/05/12 REVISED FOR PLAN CHECK COMMENTS	ESIMC	SJ

GENERAL NOTES

Seal/Signature

Project Name
VERIZON V.I.P.

Project Number
06.8740.000

CAD File Name
A00-20


Description
PARTITION TYPES

Scale




A00.20_SD




©2012 Gensler

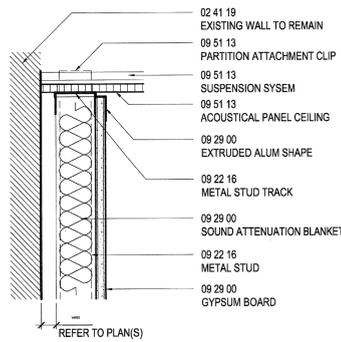


HEAD OF WALL DETAIL HWD7
SCALE: 3"= 1'-0"

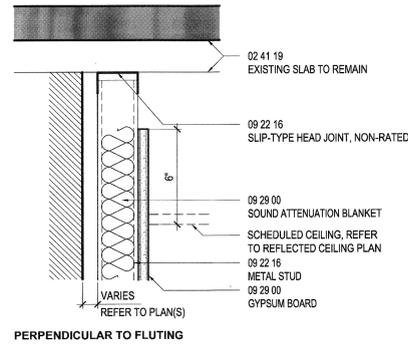


HEAD OF WALL DETAIL HWD3
SCALE: 3"= 1'-0"

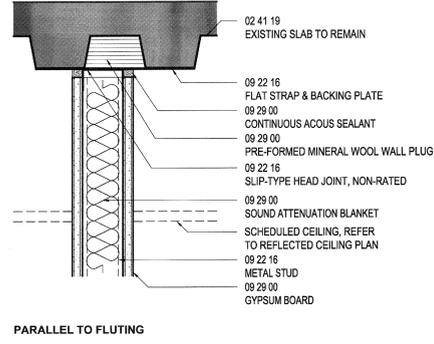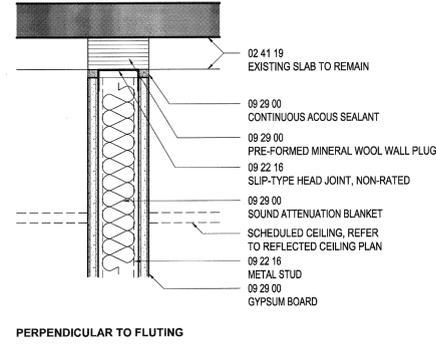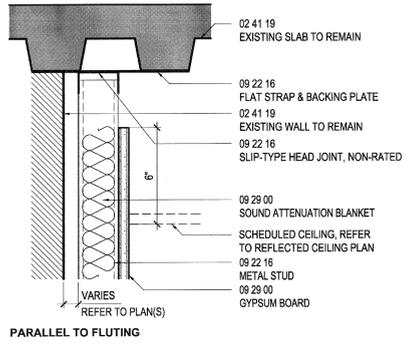




HEAD OF WALL DETAIL HWA1
SCALE: 3"= 1'-0"

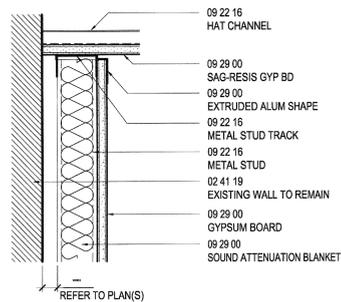


HEAD OF WALL DETAIL HWD8
SCALE: 3"= 1'-0"

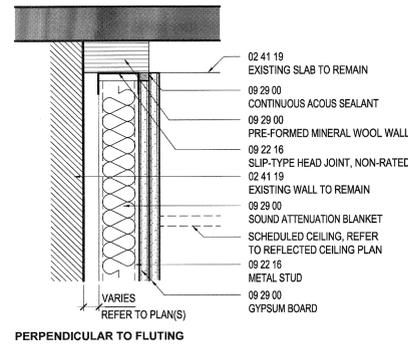


HEAD OF WALL DETAIL HWE1
SCALE: 3"= 1'-0"

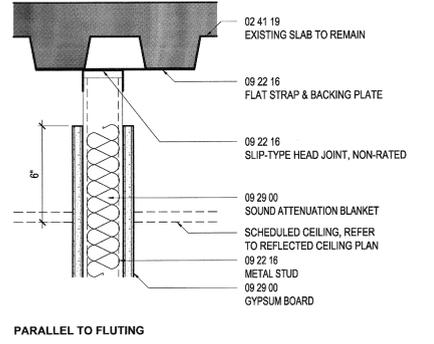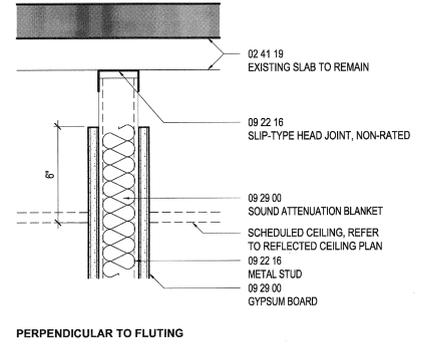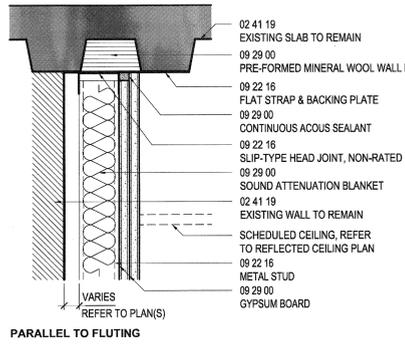




HEAD OF WALL DETAIL HWA3
SCALE: 3"= 1'-0"

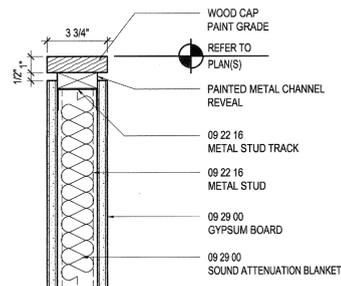


HEAD OF WALL DETAIL HWA10
SCALE: 3"= 1'-0"

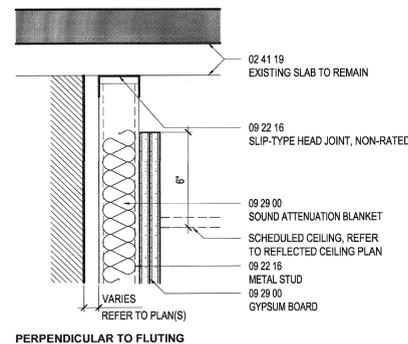



HEAD OF WALL DETAIL HWE3
SCALE: 3"= 1'-0"

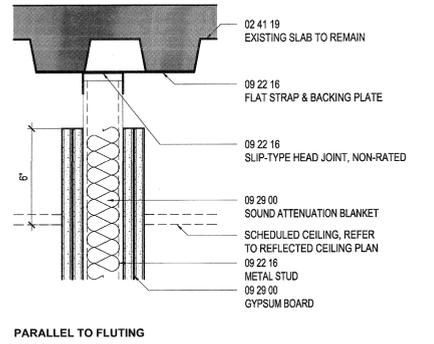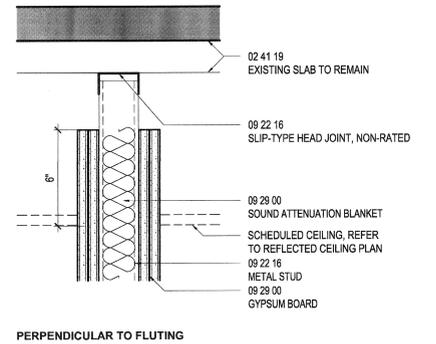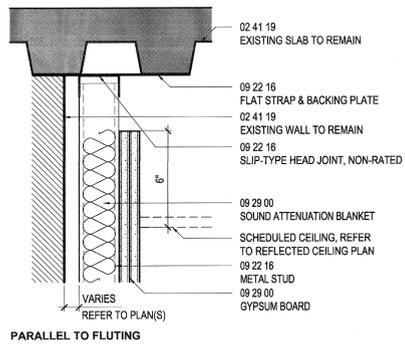


HEAD OF WALL DETAIL HWB3
SCALE: 3"= 1'-0"

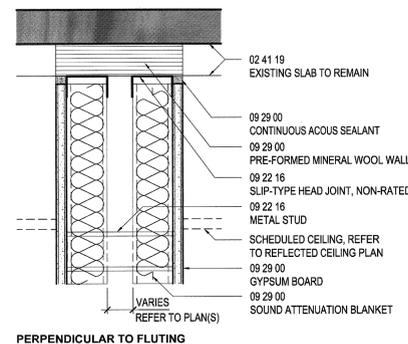

HEAD OF WALL DETAIL HWK1
SCALE: 3"= 1'-0"

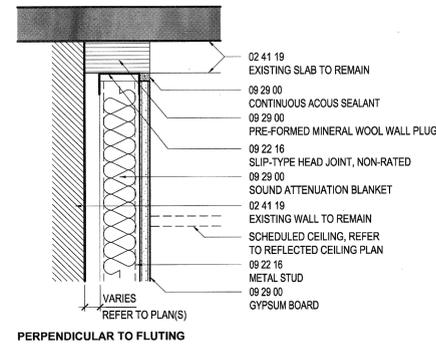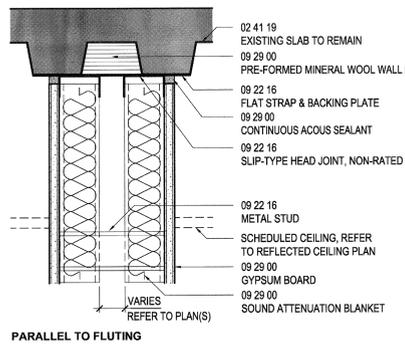

HEAD OF WALL DETAIL HWD1
SCALE: 3"= 1'-0"

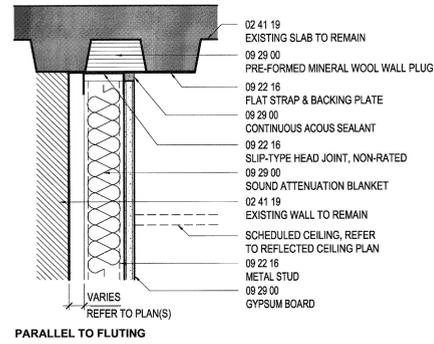

SHEET NOTES

GENERAL NOTES

- REPAIR ANY SPRAY ON FIREPROOFING DAMAGED DURING DEMOLITION OR CONSTRUCTION ON UNDERSIDE OF EXISTING SLAB TYP ALL LOCATIONS.



1800 Solar Drive
Oxnard, CA 93030

1230 Avenue of the Americas
Suite 1500
New York, NY 10020
Telephone: 212.492.1400
Facsimile: 212.492.1472

Gensler



Syska Hennessy Group, Inc.
3800 Corporate Pointe
Suite 200
Culver City, CA 90230
Telephone: 310.312.0200
Fax: 310.473.7468

Issue	Date & Issue Description	By	Check
01	06/22/12 PROGRESS SET	SJ	SJ
02	07/31/12 Issued for Plan Check	ESIMC	SJ
1	08/10/12 ISSUED FOR CONSTRUCTION	ESIMC	SJ
3	04 10/05/12 REVISED FOR PLAN CHECK COMMENTS	ESIMC	SJ

Seal/Signature



Project Name

VERIZON V.I.P.

Project Number

06.8740.000

CAD File Name

A00-20

Description

PARTITION TYPES

Scale

A00.21_SD

©2012 Gensler

SHEET NOTES




1800 Solar Drive
Oxnard, CA 93030

Gensler


1230 Avenue of the Americas
Suite 1500
New York, NY 10020
Telephone: 212.492.1400
Facsimile: 212.492.1472




Syska Hennessy Group, Inc.
800 Corporate Pointe
Suite 200
Culver City, CA 90230
Telephone: 310.312.0200
Fax: 310.473.7468

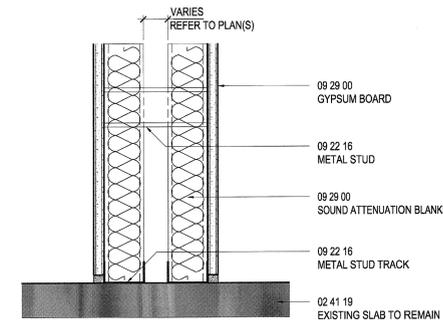


BOTTOM OF WALL DETAIL BWK1
SCALE: 3"= 1'-0"

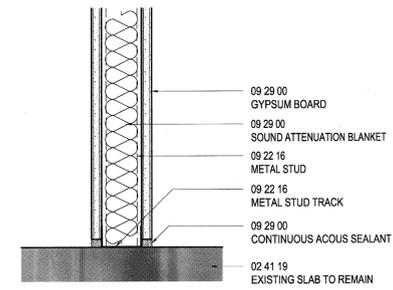


BOTTOM OF WALL DETAIL BWA1
SCALE: 3"= 1'-0"

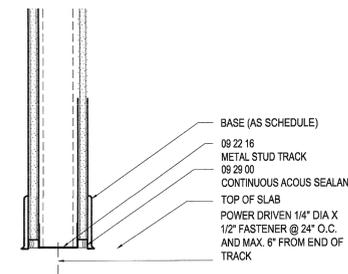


BOTTOM OF WALL DETAIL BWL1
SCALE: 3"= 1'-0"

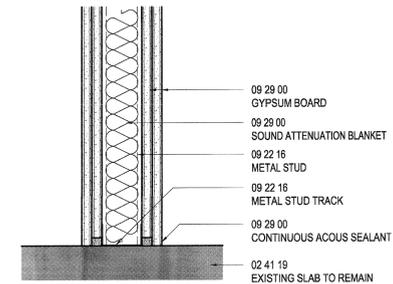


BOTTOM OF WALL DETAIL BWB1
SCALE: 3"= 1'-0"

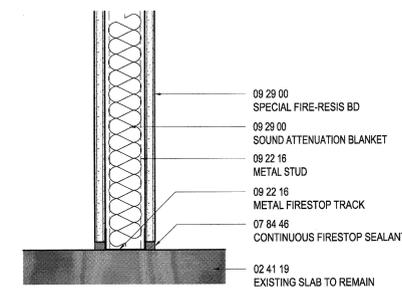


BOTTOM OF WALL DETAIL BWA2
SCALE: 3"= 1'-0"

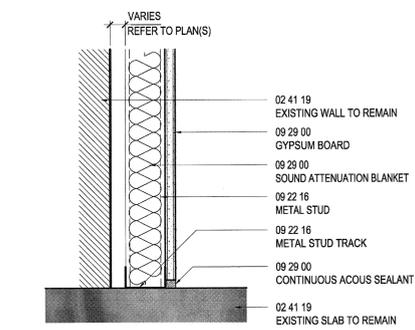


BOTTOM OF WALL DETAIL BWD1
SCALE: 3"= 1'-0"

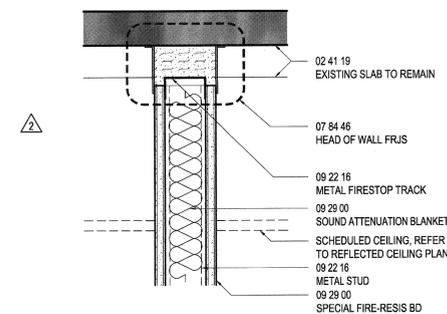

HEAD OF WALL DETAIL HWA2
SCALE: 3"= 1'-0"

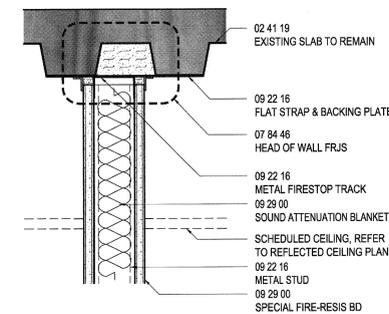

HEAD OF WALL DETAIL HWA2

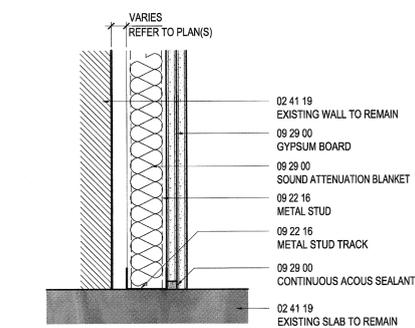

BOTTOM OF WALL DETAIL BWE1
SCALE: 3"= 1'-0"

GENERAL NOTES

- REPAIR ANY SPRAY ON FIREPROOFING DAMAGED DURING DEMOLITION OR CONSTRUCTION ON UNDERSIDE OF EXISTING SLAB TYP ALL LOCATIONS.

Issue	Date & Issue Description	By	Check
01	07/31/12	ES/MC	SJ
Issued for Plan Check			
1	02 08/10/12	ES/MC	SJ
ISSUED FOR CONSTRUCTION			
2	03 09/12/12	ES/MC	SJ
BULLETIN # 1			
3	04 10/05/12	ES/MC	SJ
REVISED FOR PLAN CHECK COMMENTS			

Seal/Signature



Project Name

VERIZON V.I.P.

Project Number

06.8740.000

CAD File Name

A00-20

Description

PARTITION TYPES








Scale

A00.22_SD



True North
Ref North

©2012 Gensler

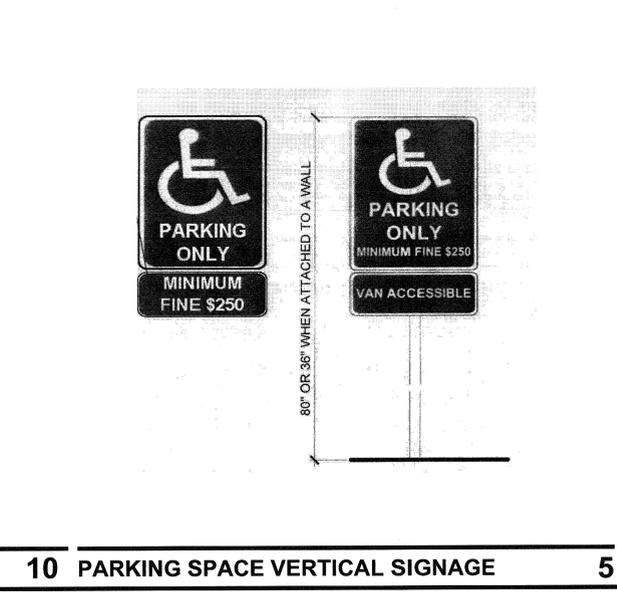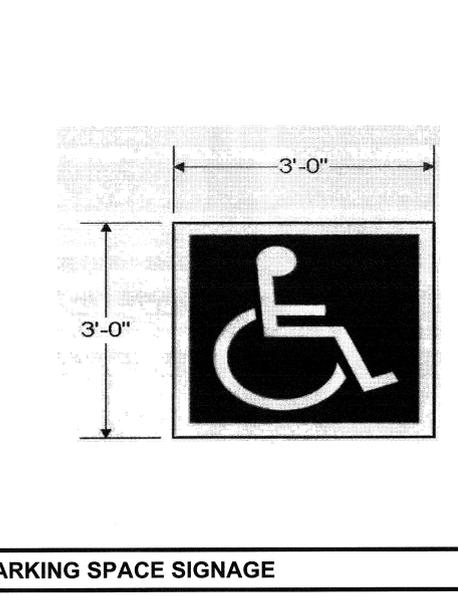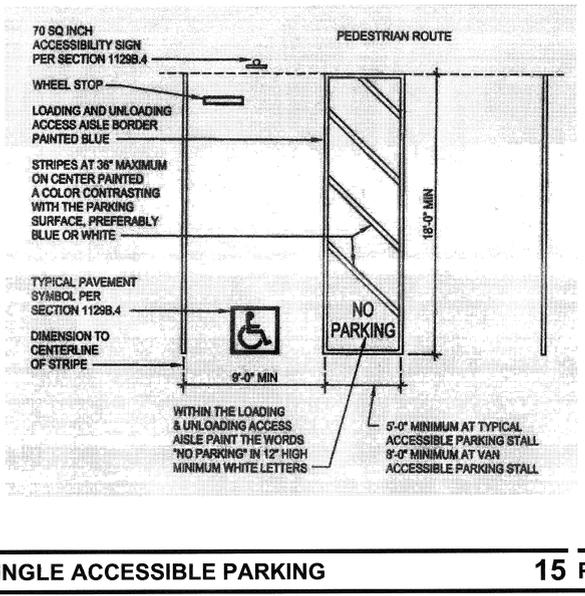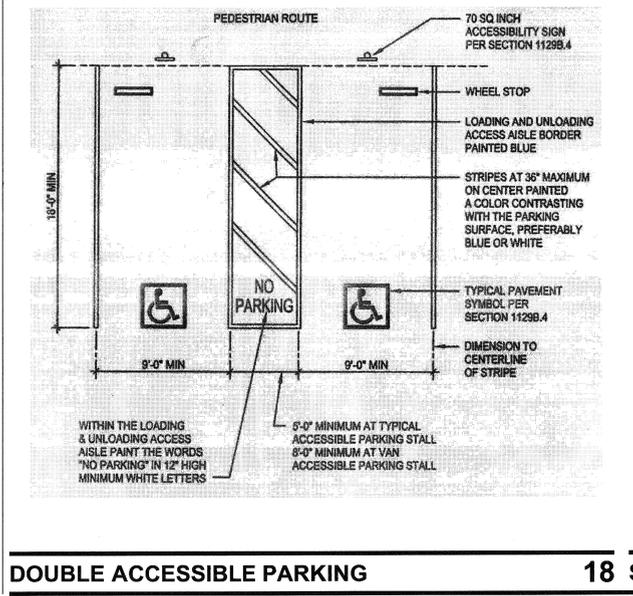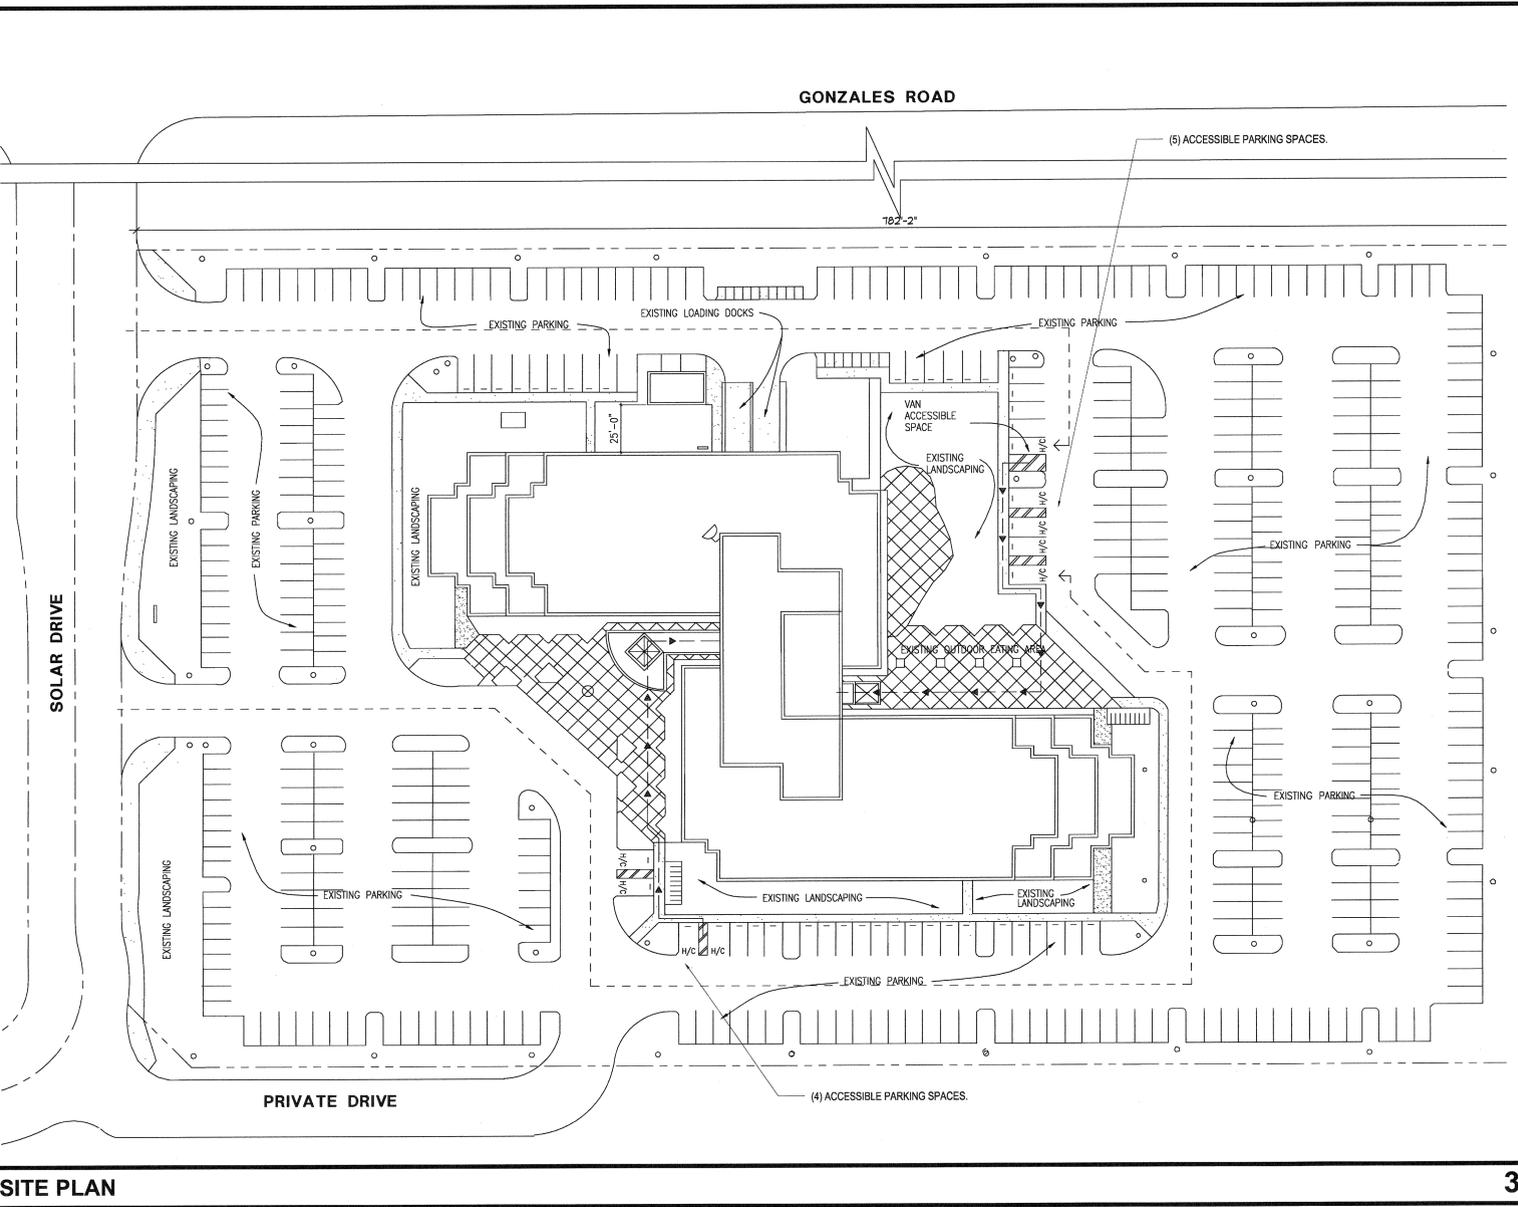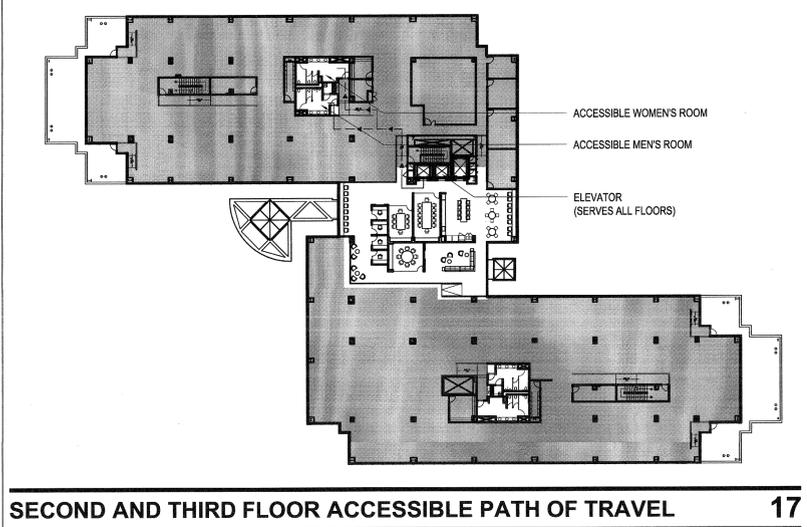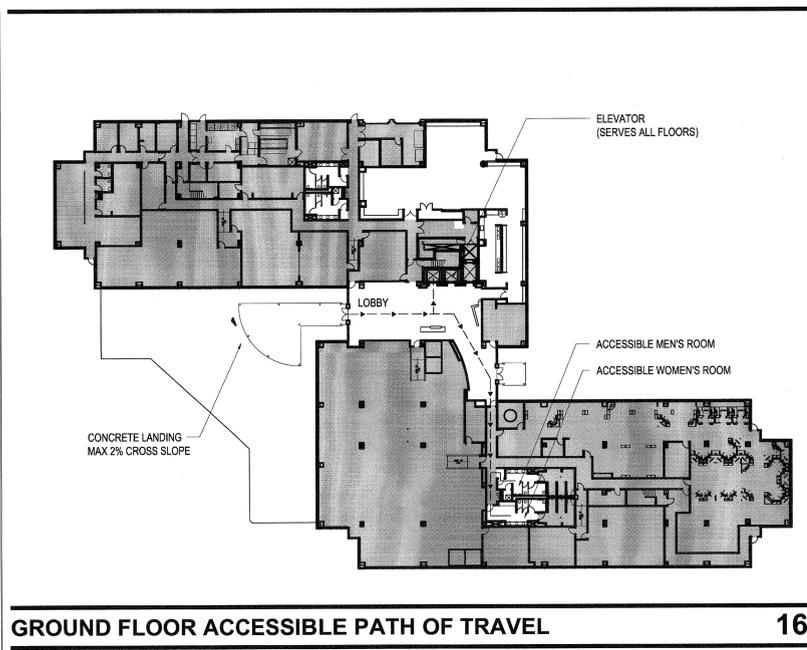

SHEET NOTES

GENERAL NOTES

Seal/Signature

PROJECT ARCHITECT
GENSELER ARCHITECTS
1500 P. CALIFORNIA
SAN JOSE, CA 95128
PHONE: 415.353.1373

Project Name
VERIZON V.I.P.

Project Number
06 8740 000

CAD File Name
A00-10

Description
ACCESSIBILITY DIAGRAMS

Scale

A00.11_SD

©2012 Gensler

True North
Ref North

1800 Solar Drive
Oxnard, CA 93030


1230 Avenue of the Americas
Suite 1500
New York, NY 10020
Telephone: 212.492.1400
Facsimile: 212.492.1472

Gensler

Syska Hennessy Group, Inc.
800 Corporate Pointe
Suite 200
Culver City, CA 90230
Telephone: 310.312.0200
Fax: 310.473.7468

SYSKA HENNESSY GROUP
A member company of Gensler Group, Inc.

Issue	Date & Issue Description	By	Check
3	01 10/05/12	ES	SJ
REVISED FOR PLAN CHECK COMMENTS			

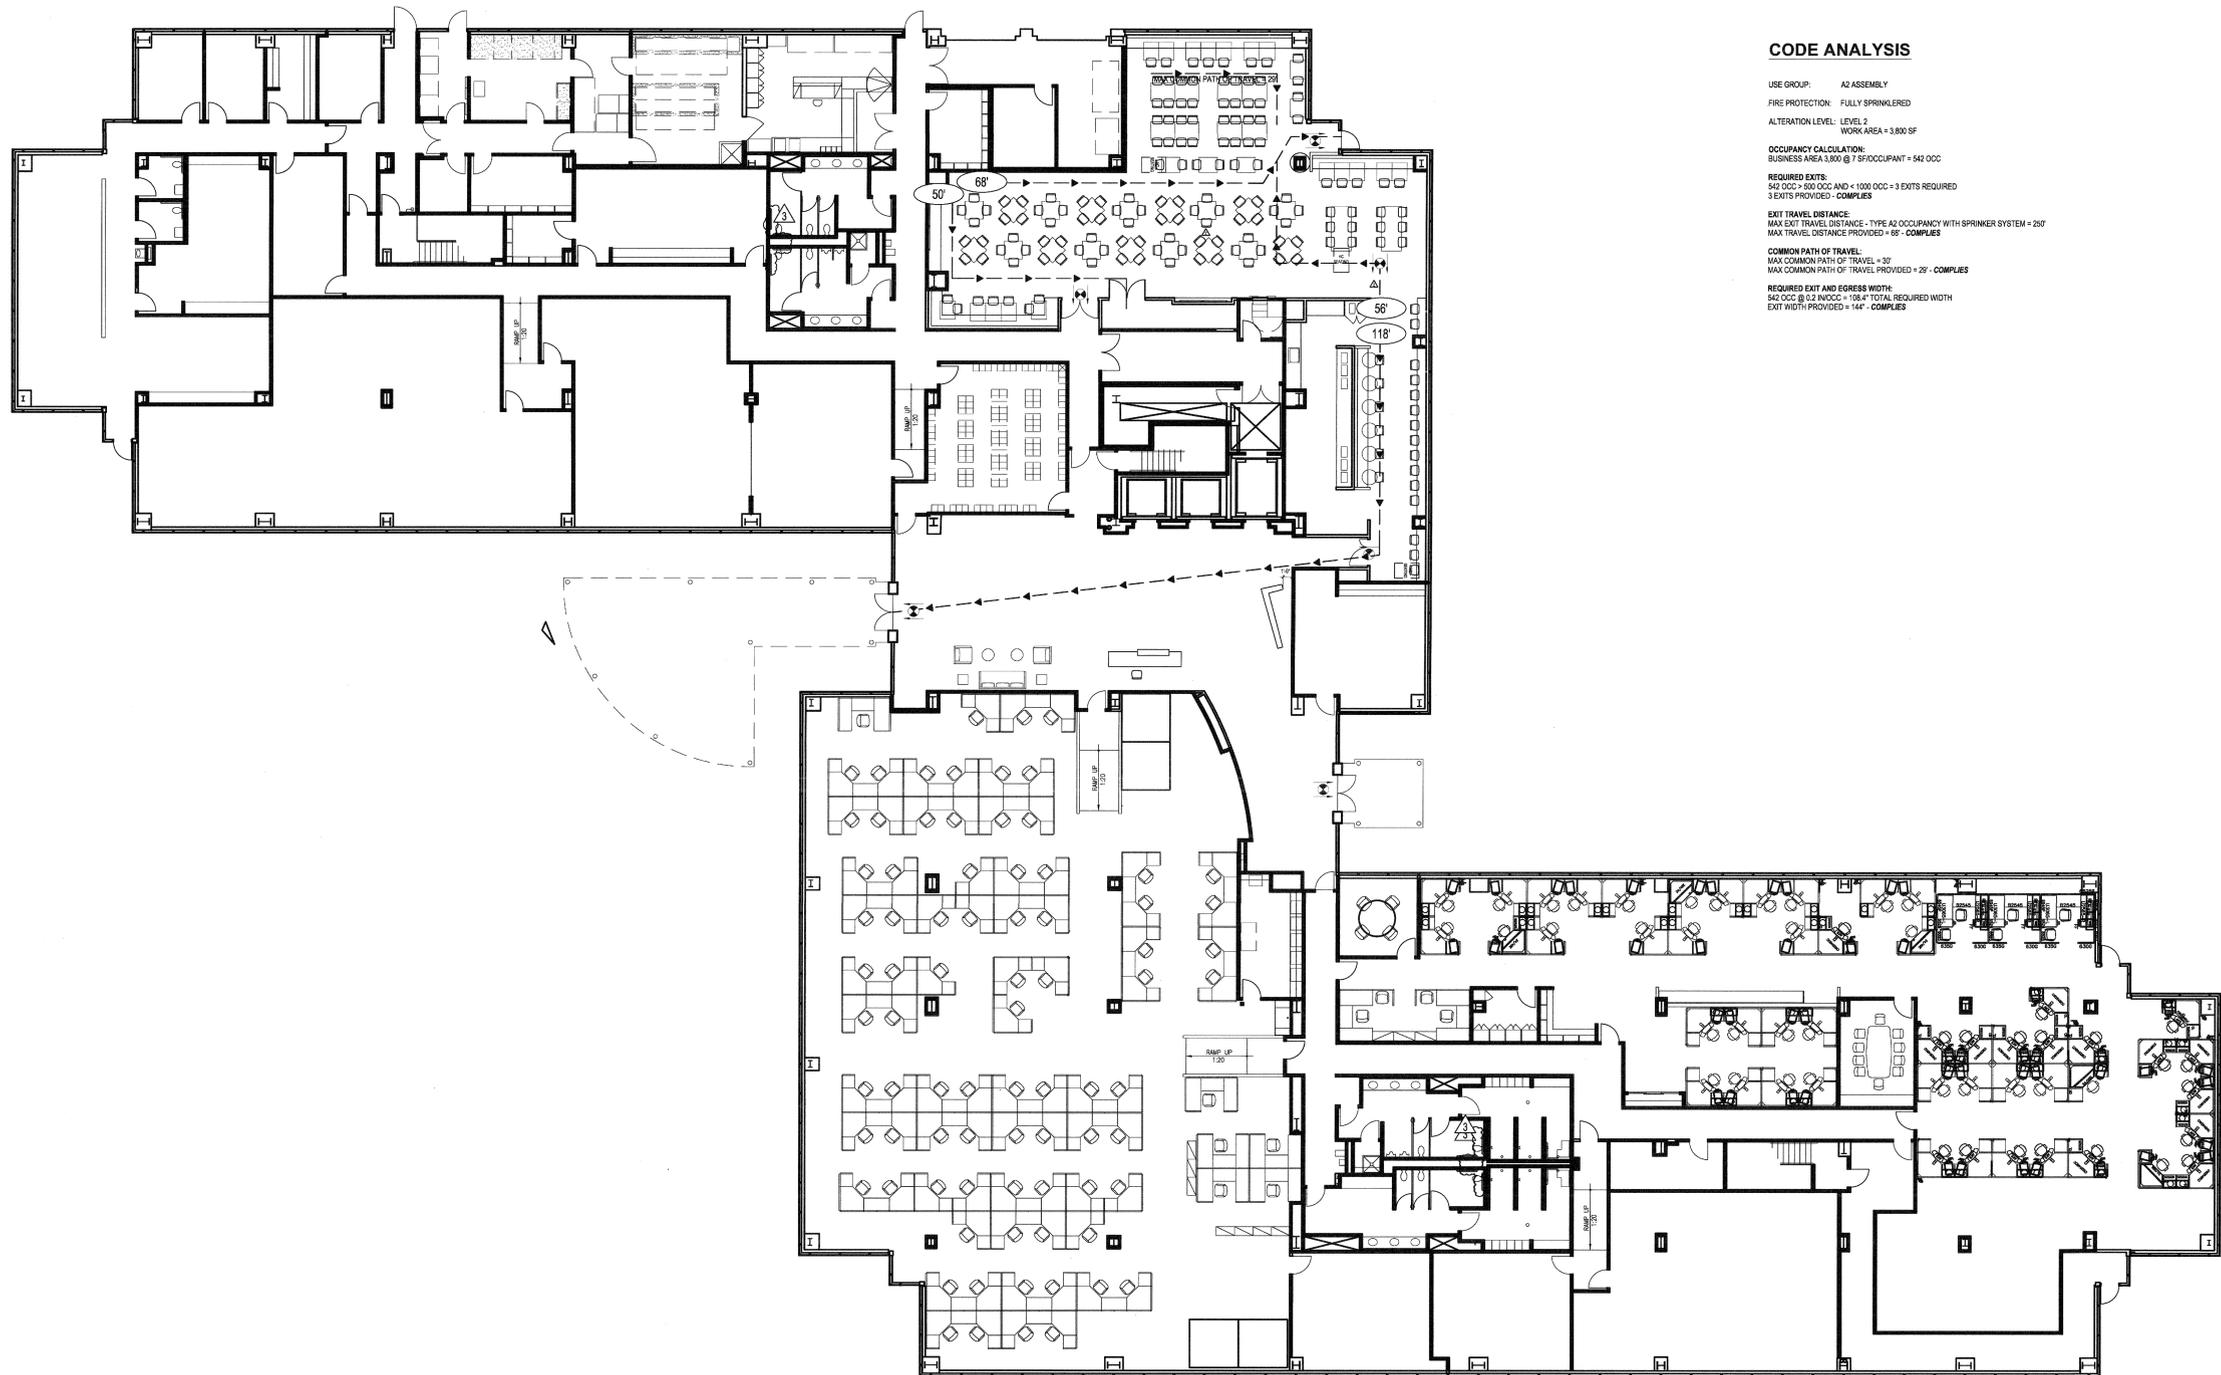

CODE ANALYSIS

USE GROUP: A2 ASSEMBLY
 FIRE PROTECTION: FULLY SPRINKLERED
 ALTERATION LEVEL: LEVEL 2
 WORK AREA = 3,800 SF

OCCUPANCY CALCULATION:
 BUSINESS AREA 3,800 @ 7 SF/OCCUPANT = 542 OCC

REQUIRED EXITS:
 542 OCC > 500 OCC AND < 1000 OCC - 3 EXITS REQUIRED
 3 EXITS PROVIDED - COMPLIES


EXIT TRAVEL DISTANCE:
 MAX EXIT TRAVEL DISTANCE - TYPE A2 OCCUPANCY WITH SPRINKLER SYSTEM = 200'
 MAX TRAVEL DISTANCE PROVIDED = 68' - COMPLIES

COMMON PATH OF TRAVEL:
 MAX COMMON PATH OF TRAVEL = 30'
 MAX COMMON PATH OF TRAVEL PROVIDED = 29' - COMPLIES

REQUIRED EXIT AND EGRESS WIDTH:
 542 OCC @ 0.2 IN/OCC = 108.4" TOTAL REQUIRED WIDTH
 EXIT WIDTH PROVIDED = 144" - COMPLIES

SHEET NOTES

EGRESS LEGEND

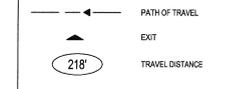

GENERAL NOTES



1800 Solar Drive
 Oxnard, CA 93030



1230 Avenue of the Americas
 Suite 1500
 New York, NY 10020
 Telephone: 212.492.1400
 Facsimile: 212.492.1472



Syska Hennessy Group, Inc.
 800 Corporate Pointe
 Suite 200
 Culver City, CA 90230
 Telephone: 310.312.0200
 Fax: 310.473.7468

Issue	Date & Issue Description	By	Check
01	07/31/12 Issued for Plan Check	ESMC	SJ

Seal/Signature



Project Name
 VERIZON V.I.P.

Project Number
 06.8740.000

CAD File Name
 A00-60


Description
 FIRST FLOOR EGRESS PLAN

Scale
 3/32" = 1'-0"

A00.60_SD



©2012 Gensler

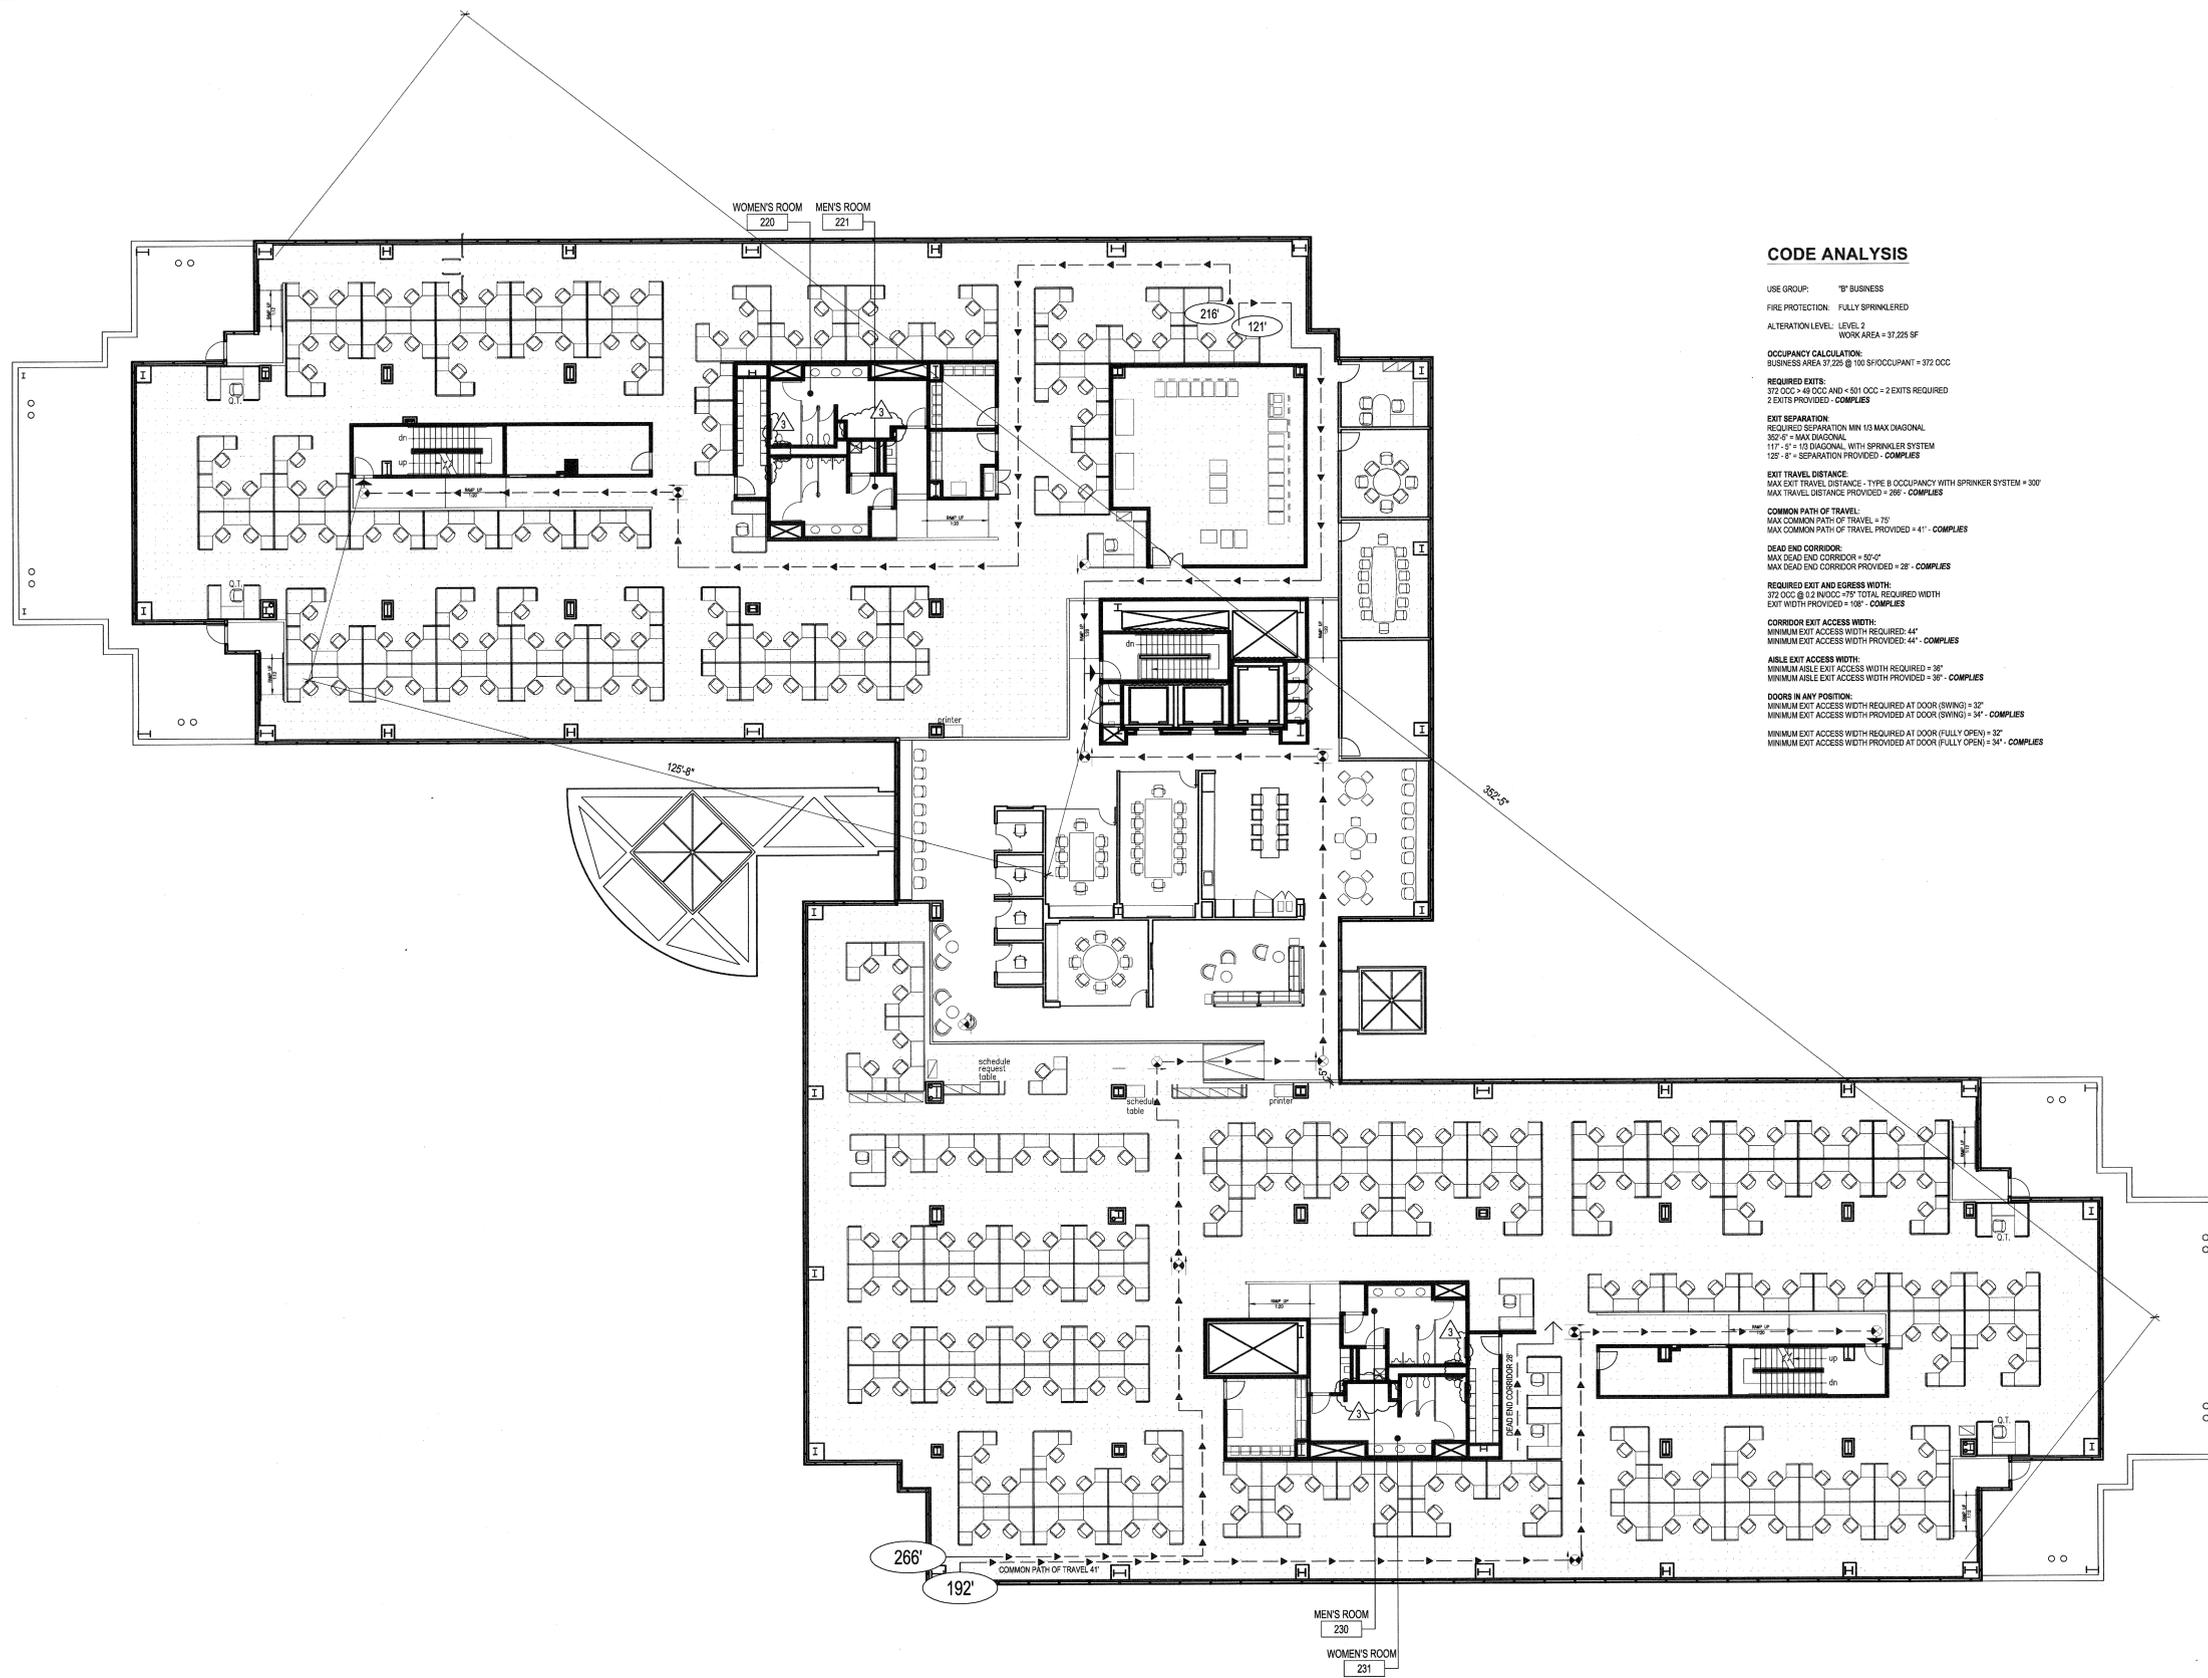


CODE ANALYSIS

USE GROUP: 1^B BUSINESS
 FIRE PROTECTION: FULLY SPRINKLERED
 ALTERNATION LEVEL: LEVEL 2
 WORK AREA = 37,225 SF
 OCCUPANCY CALCULATION:
 BUSINESS AREA 37,225 @ 100 SF/OCCUPANT = 372 OCC
 REQUIRED EXITS:
 372 OCC ÷ 48 OCC/AMB = 501 OCC - 2 EXITS REQUIRED
 2 EXITS PROVIDED - COMPLIES
 EXIT SEPARATION:
 REQUIRED SEPARATION MIN 1/3 MAX DIAGONAL
 252'-6" = MAX DIAGONAL
 117'-5" = 1/3 DIAGONAL WITH SPRINKLER SYSTEM
 125'-6" = SEPARATION PROVIDED - COMPLIES
 EXIT TRAVEL DISTANCE:
 MAX EXIT TRAVEL DISTANCE - TYPE B OCCUPANCY WITH SPRINKLER SYSTEM = 300'
 MAX TRAVEL DISTANCE PROVIDED = 266' - COMPLIES
 COMMON PATH OF TRAVEL:
 MAX COMMON PATH OF TRAVEL = 75'
 MAX COMMON PATH OF TRAVEL PROVIDED = 41' - COMPLIES
 DEAD END CORRIDOR:
 MAX DEAD END CORRIDOR = 52'-0"
 MAX DEAD END CORRIDOR PROVIDED = 28' - COMPLIES
 REQUIRED EXIT AND EGRESS WIDTH:
 372 OCC @ 1.2 INCHES = 446" TOTAL REQUIRED WIDTH
 EXIT WIDTH PROVIDED = 108" - COMPLIES
 CORRIDOR EXIT ACCESS WIDTH:
 MINIMUM EXIT ACCESS WIDTH REQUIRED = 44"
 MINIMUM EXIT ACCESS WIDTH PROVIDED = 44" - COMPLIES
 AISLE EXIT ACCESS WIDTH:
 MINIMUM AISLE EXIT ACCESS WIDTH REQUIRED = 36"
 MINIMUM AISLE EXIT ACCESS WIDTH PROVIDED = 36" - COMPLIES
 DOORS IN ANY POSITION:
 MINIMUM EXIT ACCESS WIDTH REQUIRED AT DOOR (SWING) = 32"
 MINIMUM EXIT ACCESS WIDTH PROVIDED AT DOOR (SWING) = 34" - COMPLIES
 MINIMUM EXIT ACCESS WIDTH REQUIRED AT DOOR (FULLY OPEN) = 32"
 MINIMUM EXIT ACCESS WIDTH PROVIDED AT DOOR (FULLY OPEN) = 34" - COMPLIES

SHEET NOTES

EGRESS LEGEND

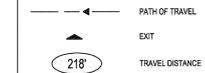

GENERAL NOTES



1800 Solar Drive
Oxnard, CA 93030



1230 Avenue of the Americas
Suite 1500
New York, NY 10020
Telephone: 212.492.1400
Facsimile 212.492.1472



Syska Hennessy Group, Inc.
800 Corporate Pointe
Suite 200
Culver City, CA 90230
Telephone: 310.812.0200
Fax: 310.473.7468

Issue	Date & Issue Description	By	Check
01	07/31/12	ESMC	SJ
Issued for Plan Check			
4	02 10/05/12	ES	SJ
REVISED FOR PLAN CHECK COMMENTS			

Seal/Signature



Project Name
VERIZON V.I.P.


Project Number
06.8740.000
CAD File Name
A00-60
Description
SECOND FLOOR EGRESS PLAN

Scale
3/32" = 1'-0"

A00.61_SD



©2012 Gensler

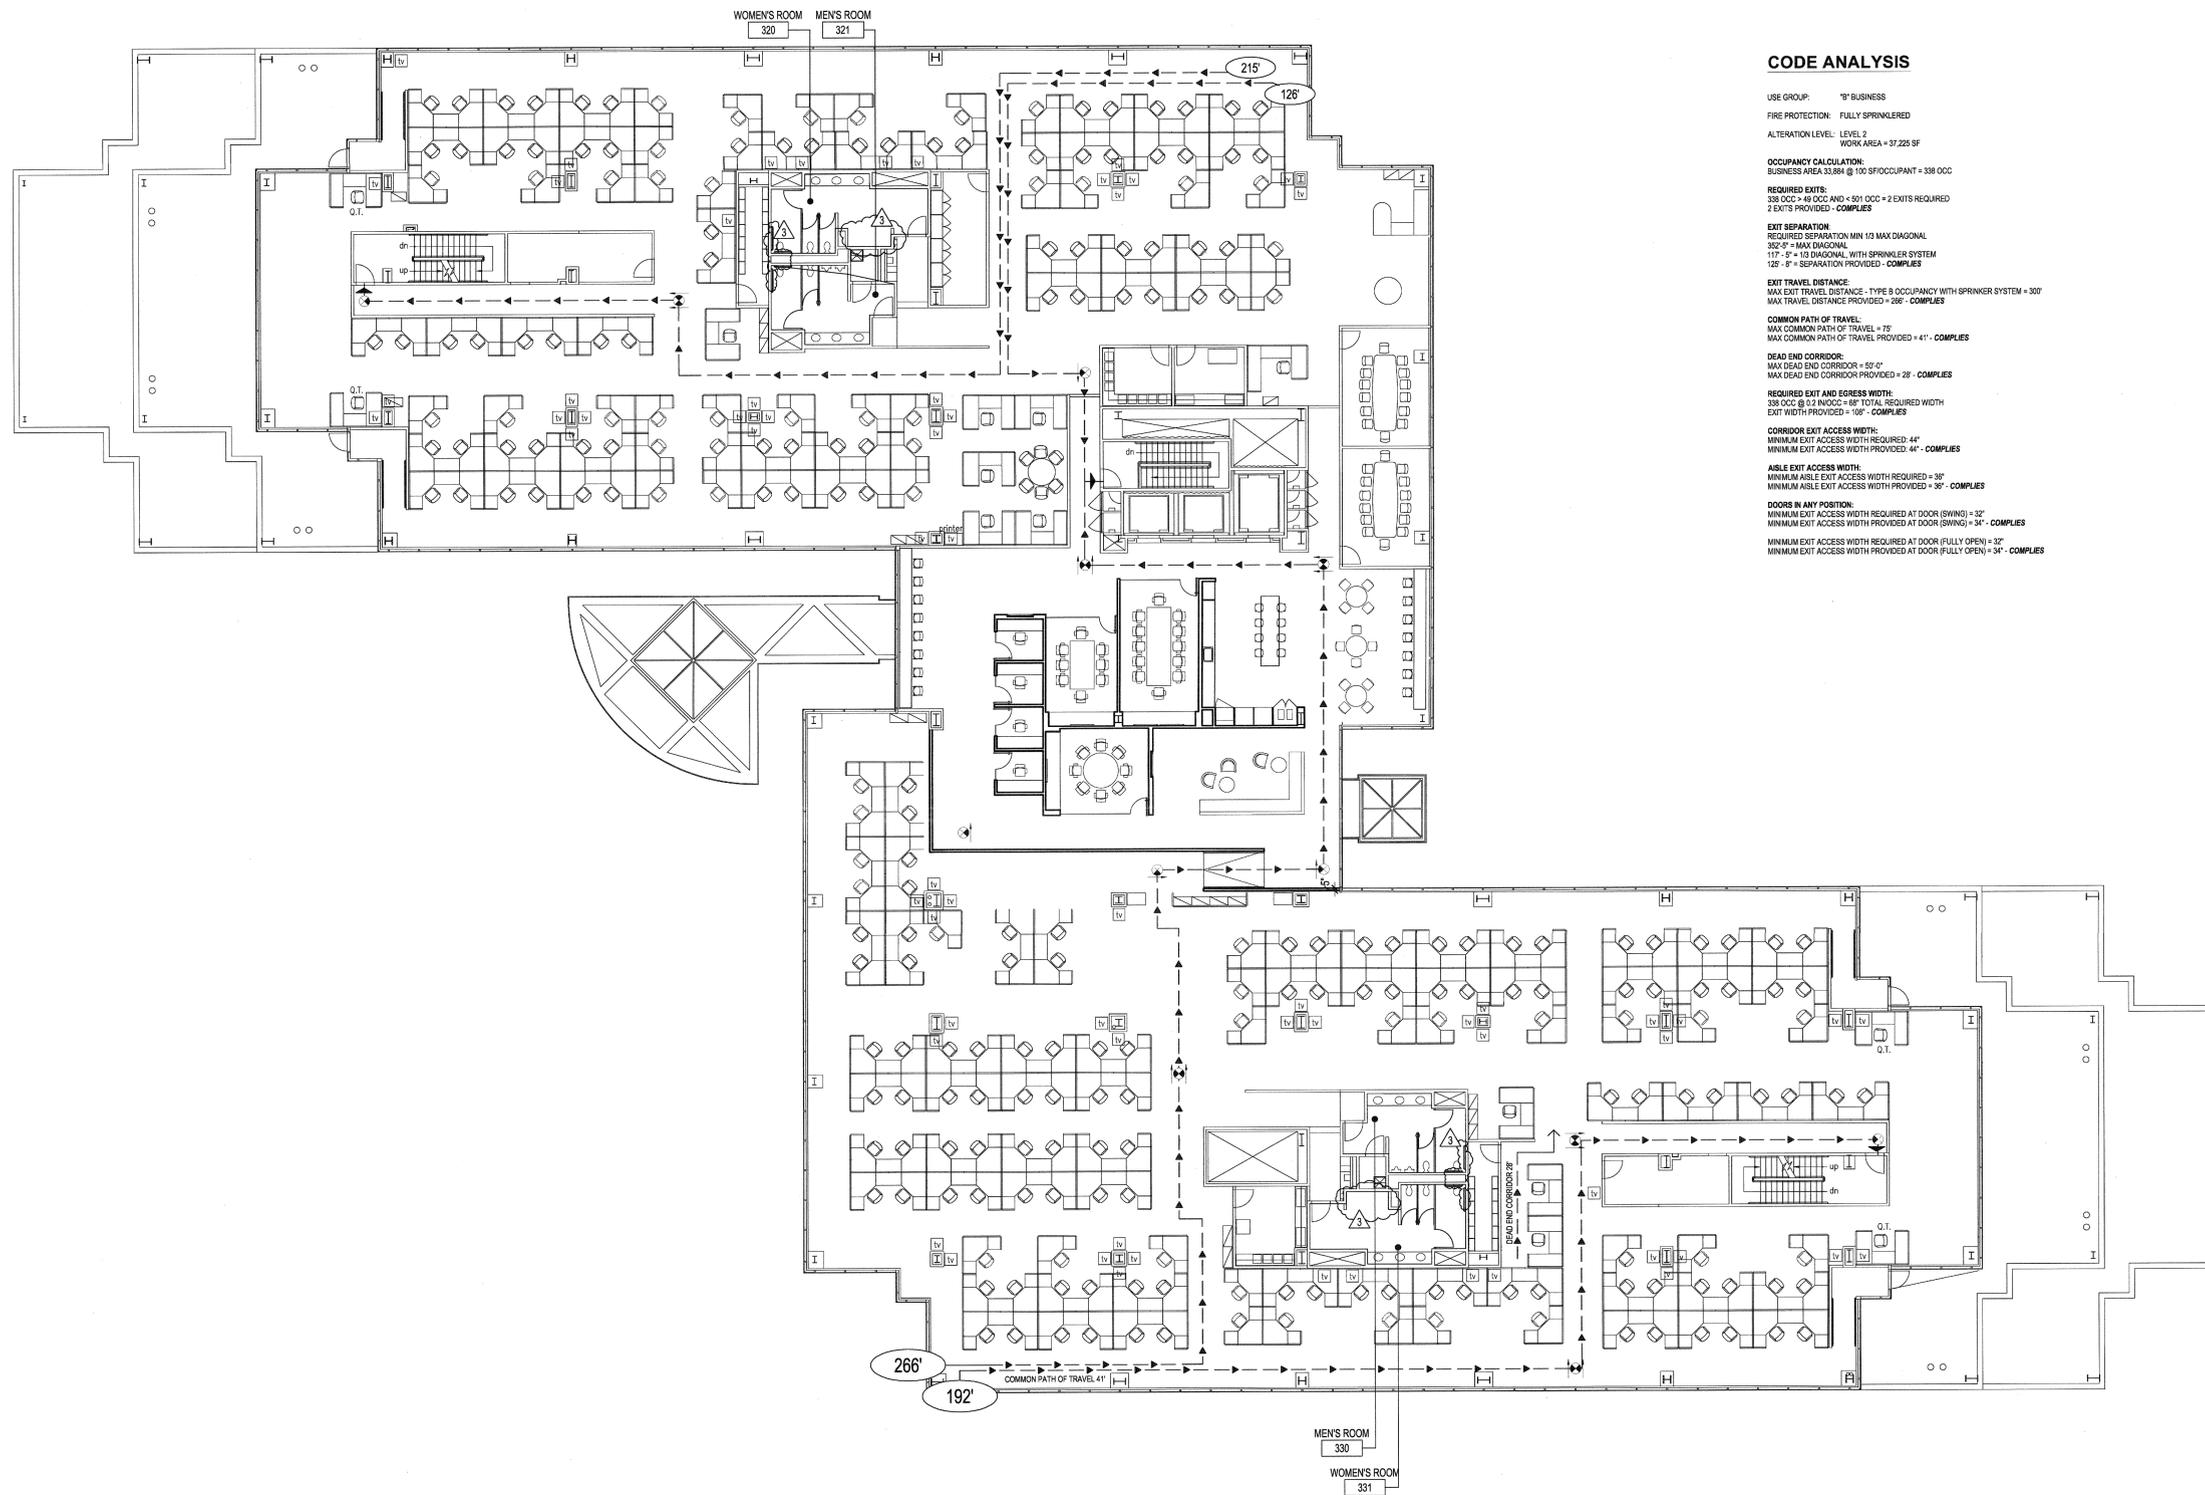

CODE ANALYSIS

USE GROUP: "B" BUSINESS
 FIRE PROTECTION: FULLY SPRINKLERED
 ALTERATION LEVEL: LEVEL 2
 WORK AREA = 37,225 SF

OCCUPANCY CALCULATION:
 BUSINESS AREA 33,864 @ 100 SF/OCCUPANT = 338 OCC

REQUIRED EXITS:
 338 OCC @ 45 FEET AND < 501 OCC = 2 EXITS REQUIRED
 2 EXITS PROVIDED - COMPLIES

EXIT SEPARATION:
 REQUIRED SEPARATION MIN 193 MAX DIAGONAL
 252'-0" = MAX DIAGONAL
 117'-5" = 193 DIAGONAL WITH SPRINKLER SYSTEM
 125'-8" = SEPARATION PROVIDED - COMPLIES

EXIT TRAVEL DISTANCE:
 MAX EXIT TRAVEL DISTANCE - TYPE B OCCUPANCY WITH SPRINKLER SYSTEM = 300'
 MAX TRAVEL DISTANCE PROVIDED = 286' - COMPLIES

COMMON PATH OF TRAVEL:
 MAX COMMON PATH OF TRAVEL = 75'
 MAX COMMON PATH OF TRAVEL PROVIDED = 41' - COMPLIES

DEAD END CORRIDOR:
 MAX DEAD END CORRIDOR = 57'-0"
 MAX DEAD END CORRIDOR PROVIDED = 28' - COMPLIES

REQUIRED EXIT AND EGRESS WIDTH:
 338 OCC @ 0.2 IN/OCC = 68' TOTAL REQUIRED WIDTH
 EXIT WIDTH PROVIDED = 108' - COMPLIES

CORRIDOR EXIT ACCESS WIDTH:
 MINIMUM EXIT ACCESS WIDTH REQUIRED = 44"
 MINIMUM EXIT ACCESS WIDTH PROVIDED = 44" - COMPLIES

ASLE EXIT ACCESS WIDTH:
 MINIMUM ASLE EXIT ACCESS WIDTH REQUIRED = 30"
 MINIMUM ASLE EXIT ACCESS WIDTH PROVIDED = 30" - COMPLIES

DOORS IN ANY POSITION:
 MINIMUM EXIT ACCESS WIDTH REQUIRED AT DOOR (SWING) = 32"
 MINIMUM EXIT ACCESS WIDTH PROVIDED AT DOOR (SWING) = 34" - COMPLIES
 MINIMUM EXIT ACCESS WIDTH REQUIRED AT DOOR (FULLY OPEN) = 32"
 MINIMUM EXIT ACCESS WIDTH PROVIDED AT DOOR (FULLY OPEN) = 34" - COMPLIES

SHEET NOTES

EGRESS LEGEND



GENERAL NOTES



1800 Solar Drive
 Oxnard, CA 93030



1230 Avenue of the Americas
 Suite 1500
 New York, NY 10020
 Telephone: 212.492.1400
 Facsimile 212.492.1472



Syska Hennessy Group, Inc.
 800 Corporate Pointe
 Suite 200
 Culver City, CA 90230
 Telephone: 310.312.0200
 Fax: 310.473.7468

Issue	Date	Description	By	Check
01	07/31/12	Issued for Plan Check	ES/MC	SJ
4	02	10/09/12 REVISED FOR PLAN CHECK COMMENTS	ES	SJ

Seal/Signature



Project Name
 VERIZON V.I.P.

Project Number
 06.8740.000
 CAD File Name
 A00-60
 Description
 THIRD FLOOR EGRESS PLAN

Scale
 3/32" = 1'-0"

A00.62_SD

©2012 Gensler





SHEET NOTES

- 01 REMOVE EXISTING PARTITION
- 02 DEMOLISH EXISTING SECURITY DESK
- 03 REMOVE EXIST PLUMBING FIXTURES & CAP PIPING. SEE PLUMBING DRAWING FOR MORE INFO.
- 04 REMOVE EXIST FLOOR FINISH IN THIS AREA.
- 05 REMOVE WALL FINISH IN THIS AREA.
- 06 DEMOLISH EXISTING MILLWORK.
- 07 REMOVE EXISTING INFORMATION SIGNAGE BOARDS.
- 08 REMOVE EXISTING TOILET PARTITIONS/GRAB BARS, SINKS AND COUNTER.
- 09 DEMOLISH WALL AS INDICATED FOR NEW DOOR LOCATION. REFER TO CONSTRUCTION PLAN.
- 10 REMOVE EXISTING CEILING GRID AND TILES AND LIGHT FIXTURES.

GENERAL NOTES

1. PATCH & REPAIR ALL EXISTING WALLS TO REMAIN AFFECTED BY DEMOLITION WORK.
2. REFER TO MEP DRAWINGS FOR FURTHER INFORMATION ON ITEMS TO BE REMOVED.
3. PREPARE FOR NEW FLOORING AS SPECIFIED.
4. REMOVE EXISTING ROLLER SHADES AT NORTH, SOUTH AND WEST FACADE.
5. EXISTING CEILING TO REMAIN U.O.N.



1800 Solar Drive
Oxnard, CA 93050

Gensler

Syska Hennessy Group
A member company of SH Group, Inc.

1230 Avenue of the Americas
Suite 1500
New York, NY 10020
Telephone: 212.492.1400
Facsimile 212.492.1472

Syska Hennessy Group, Inc.
800 Corporate Pointe
Suite 200
Calver City, CA 90230
Telephone: 310.312.0200
Fax: 310.473.7468

Issue	Date & Issue Description	By	Check
01	07/18/12	SJ	SJ
ISSUED FOR PERMIT			
02	07/31/12	ES	SJ
ISSUED FOR PERMIT/BID			
03	07/31/12	ESMC	SJ
Issued for Plan Check			
1	08/10/12	ESMC	SJ
ISSUED FOR CONSTRUCTION			
3	10/05/12	ESMC	SJ
REVISED FOR PLAN CHECK COMMENTS			

Seal/Signature



Project Name
VERIZON V.I.P.

Project Number
06.8740.000
CAD File Name

A01-01
Description
FIRST FLOOR DEMOLITION PLAN

Scale
3/32" = 1'-0"

A01.01_SD



©2012 Gensler



SHEET NOTES

- 01 REMOVE EXISTING PARTITION
- 02 REMOVE EXISTING FINISHES ON CORE WALL
- 03 REMOVE EXISTING RAISED FLOOR TILE
- 04 REMOVE TOILET PARTITIONS, GRAB BARS, SINKS AND COUNTER.
- 05 REMOVE EXISTING CEILING TILES, GRID AND LIGHT FIXTURES IN ARE OF WORK. REFER TO REFLECTED CEILING PLAN FOR EXTENT AND NEW LAYOUT.

GENERAL NOTES

1. PATCH & REPAIR ALL EXISTING WALLS TO REMAIN AFFECTED BY DEMOLITION WORK.
2. REFER TO MEP DRAWINGS FOR FURTHER INFORMATION ON ITEMS TO BE REMOVED.
3. PREPARE FOR NEW FLOORING AS SPECIFIED.
4. REMOVE EXISTING ROLLER SHADES AT NORTH, SOUTH AND WEST FACADE.
5. EXISTING CEILING TO REMAIN U.O.N.



1800 Solar Drive
Oxnard, CA 93030



1230 Avenue of the Americas
Suite 1500
New York, NY 10020
Telephone: 212.492.1400
Facsimile: 212.492.1472



Syska Hennessy Group, Inc.
800 Corporate Pointe
Suite 200
Calver City, CA 90230
Telephone: 310.312.0200
Fax: 310.473.7468

Issue	Date & Issue Description	By	Check
01	08/22/12	SJ	SJ
PROGRESS SET			
02	07/31/12	ESMC	SJ
Issued for Plan Check			
1	08/10/12	ESMC	SJ
ISSUED FOR CONSTRUCTION			
3	04	ESMC	SJ
REVISED FOR PLAN CHECK COMMENTS			

Seal/Signature



Project Name
VERIZON V.I.P.

Project Number
06.8740.000
CAD File Name

A01-01
Description
SECOND FLOOR DEMOLITION PLAN

Scale
3/32" = 1'-0"

A01.02_SD



©2012 Gensler



SHEET NOTES

- 01 REMOVE EXISTING PARTITION
- 02 REMOVE EXISTING FINISHES ON CORE WALL
- 03 REMOVE EXISTING RAISED FLOOR TILE
- 04 REMOVE TOILET PARTITIONS, GRAB BARS, SINKS AND COUNTER
- 05 REMOVE EXISTING CEILING TILES, GRID AND LIGHT FIXTURES IN ARE OF WORK. REFER TO REFLECTED CEILING PLAN FOR EXTENT AND NEW LAYOUT.

GENERAL NOTES

1. PATCH & REPAIR ALL EXISTING WALLS TO REMAIN AFFECTED BY DEMOLITION WORK.
2. REFER TO MEP DRAWINGS FOR FURTHER INFORMATION ON ITEMS TO BE REMOVED.
3. PREPARE FOR NEW FLOORING AS SPECIFIED.
4. REMOVE EXISTING ROLLER SHADES AT NORTH, SOUTH AND WEST FACADE.
5. EXISTING CEILING TO REMAIN U.O.N.



1800 Solar Drive
Oxnard, CA 93030

Gensler



1230 Avenue of the Americas
Suite 1500
New York, NY 10020
Telephone 212.492.1400
Facsimile 212.492.1472

Syska Hennessy Group, Inc.
880 Corporate Pointe
Suite 200
Culver City, CA 90230
Telephone: 310.312.0200
Fax: 310.473.7468

Issue	Date	Issue Description	By	Check
01	08/22/12	PROGRESS SET	SJ	SJ
02	07/31/12	ESMC	ESMC	SJ
		Issued for Plan Check		
1	08/10/12	ISSUED FOR CONSTRUCTION	ESMC	SJ
3	04	10/05/12	ESMC	SJ
		REVISED FOR PLAN CHECK COMMENTS		

Seal/Signature



Project Name

VERIZON V.I.P.

Project Number

06.8740.000

CAD File Name

A01-01

Description

THIRD FLOOR DEMOLITION PLAN

Scale

3/32" = 1'-0"

A01.03_SD



True North
Ref North

©2012 Gensler



SHEET NOTES

GENERAL NOTES

1. FOR FURTHER INFORMATION SEE A08 SERIES.
2. INSTALL NEW ROLLER SHADE IN EXISTING BRACKETS ON NORTH, SOUTH, AND WEST FACADES.



1800 Solar Drive
Oxnard, CA 93030

Gensler

1230 Avenue of the Americas
Suite 1500
New York, NY 10020
Telephone: 212.492.1400
Facsimile: 212.492.1472



Syska Hennessy Group, Inc.
800 Corporate Pointe
Suite 200
Culver City, CA 90230
Telephone: 310.312.0200
Fax: 310.473.7468

Issue	Date & Issue Description	By	Check
01	06/22/12 PROGRESS SET	SJ	SJ
02	07/31/12 Issued for Plan Check	ESMC	SJ
1	08/10/12 ISSUED FOR CONSTRUCTION	ESMC	SJ
3	10/05/12 REVISED FOR PLAN CHECK COMMENTS	ESMC	SJ

Seal/Signature



Project Name
VERIZON V.I.P.

Project Number
06.8740.000
CAD File Name
A01-01
Description
SECOND FLOOR CONSTRUCTION PLAN

Scale
3/32" = 1'-0"

A02.02_SD



©2012 Gensler



SHEET NOTES

GENERAL NOTES

1. FOR FURTHER INFORMATION SEE A08 SERIES.
2. INSTALL NEW ROLLER SHADE IN EXISTING BRACKETS ON NORTH, SOUTH, AND WEST FACADES.



1800 Solar Drive
Oxnard, CA 93030

Gensler

1230 Avenue of the Americas
Suite 1500
New York, NY 10020
Telephone: 212.492.1400
Facsimile: 212.492.1472



Syska Hennessy Group, Inc.
800 Corporate Pointe
Suite 200
Culver City, CA 90230
Telephone: 310.312.0200
Fax: 310.473.7468

Issue	Date & Issue Description	By	Check
01	08/22/12 PROGRESS SET	SJ	SJ
02	07/31/12 Issued for Plan Check	ESMC	SJ
1	08/10/12 ISSUED FOR CONSTRUCTION	ESMC	SJ
3	04 10/05/12 REVISED FOR PLAN CHECK COMMENTS	ESMC	SJ

Scale/Signature



Project Name
VERIZON V.I.P.

Project Number
06.8740.000

CAD File Name
A01-01


Description
THIRD FLOOR CONSTRUCTION PLAN

Scale
3/32" = 1'-0"


A02.03_SD




©2012 Gensler

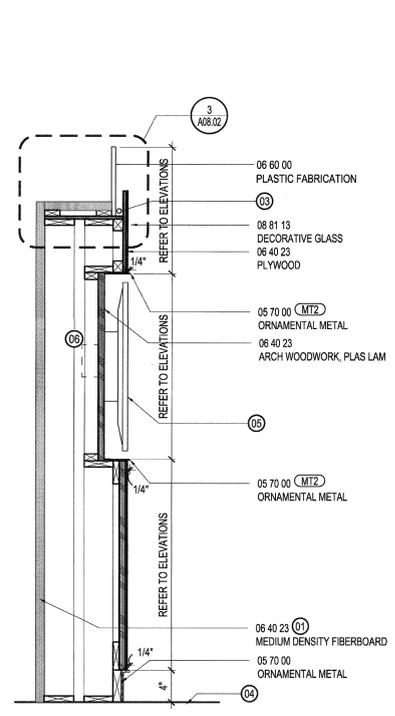

SMALL RECEPTION KIOSK SIDE ELEV. 9
 SCALE: 3/8" = 1'-0"

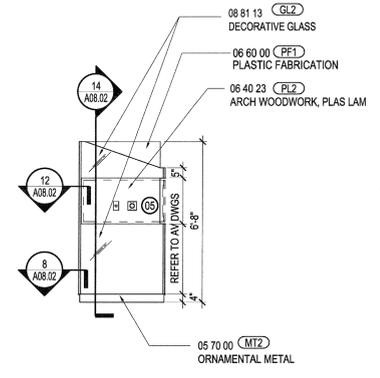


SMALL RECEPT. KIOSK PLAN
 SCALE: 3/8" = 1'-0"

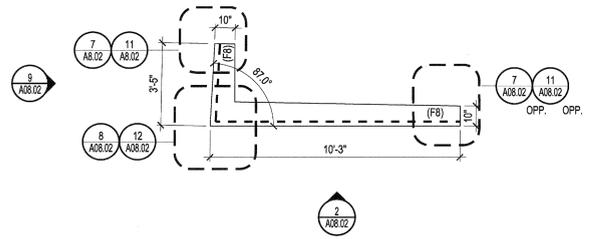


SMALL RECEPT. KIOSK FRONT ELEV. 2
 SCALE: 3/8" = 1'-0"


RECEPTION KIOSK CHECK-IN SECT. 14
 SCALE: 1 1/2" = 1'-0"

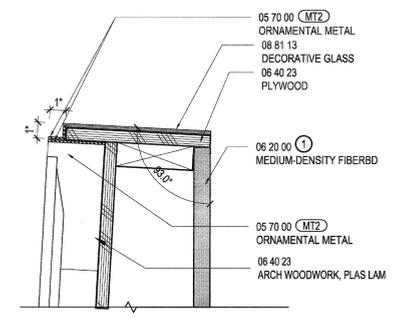


END DETAIL @ A/V EQUIP 11
 SCALE: 3" = 1'-0"

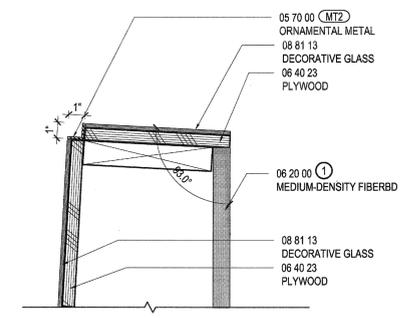


END DETAIL 7
 SCALE: 3" = 1'-0"

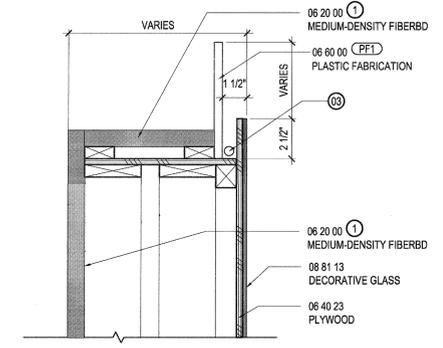


TOP CAP DETAIL 3
 SCALE: 3" = 1'-0"

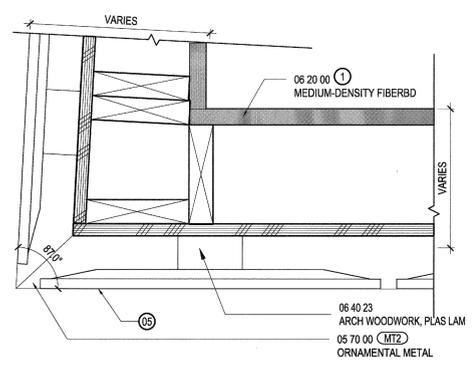

OUTSIDE CORNER @ A/V EQUIP. 12
 SCALE: 3" = 1'-0"

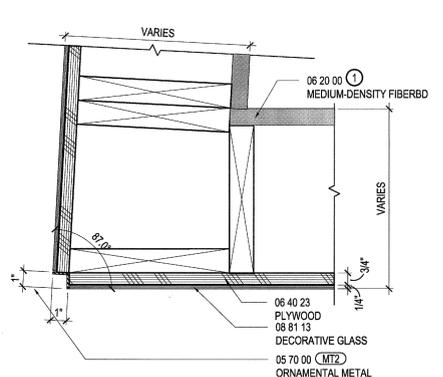

OUTSIDE CORNER DETAIL 8
 SCALE: 3" = 1'-0"

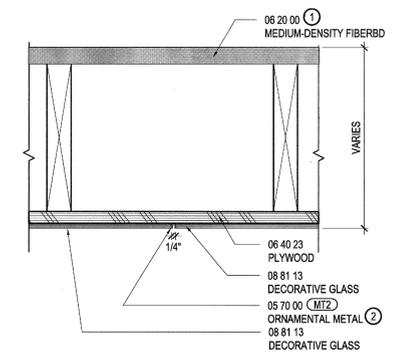

GLASS JOINT DETAIL 4
 SCALE: 3" = 1'-0"

SHEET NOTES

- 01 PAINTED PT3
- 02 NOT USED
- 03 SCHEDULED LIGHT FIXTURE F8
- 04 TOP OF EXISTING FINISHED FLOOR
- 05 SCHEDULED AV EQUIPMENT. COORDINATE POWER AND DATA REQUIREMENTS WITH ENGINEERING DRAWINGS.
- 06 SCHEDULED POWER AND DATA OUTLETS

GENERAL NOTES



1800 Solar Drive
 Oxnard, CA 93030



1230 Avenue of the Americas
 Suite 1500
 New York, NY 10020
 Telephone 212.492.1400
 Facsimile 212.492.1472



Syska Hennessy Group, Inc.
 800 Corporate Pointe
 Suite 200
 Culver City, CA 90230
 Telephone: 310.312.0200
 Fax: 310.473.7468

Issue	Date & Issue Description	By	Check
01	07/31/12	ES/MC	SJ
1	08/10/12 Issued for Plan Check	ES/MC	SJ
2	08/10/12 ISSUED FOR CONSTRUCTION	ES/MC	SJ
3	10/05/12 REVISED FOR PLAN CHECK COMMENTS	ES/MC	SJ

Seal/Signature



Project Name
 VERIZON V.I.P.


Project Number
 06.8740.000
 CAD File Name

Description
 SMALL RECEPTION KIOSK DETAILS

Scale
 AS NOTED


A08.02_SD



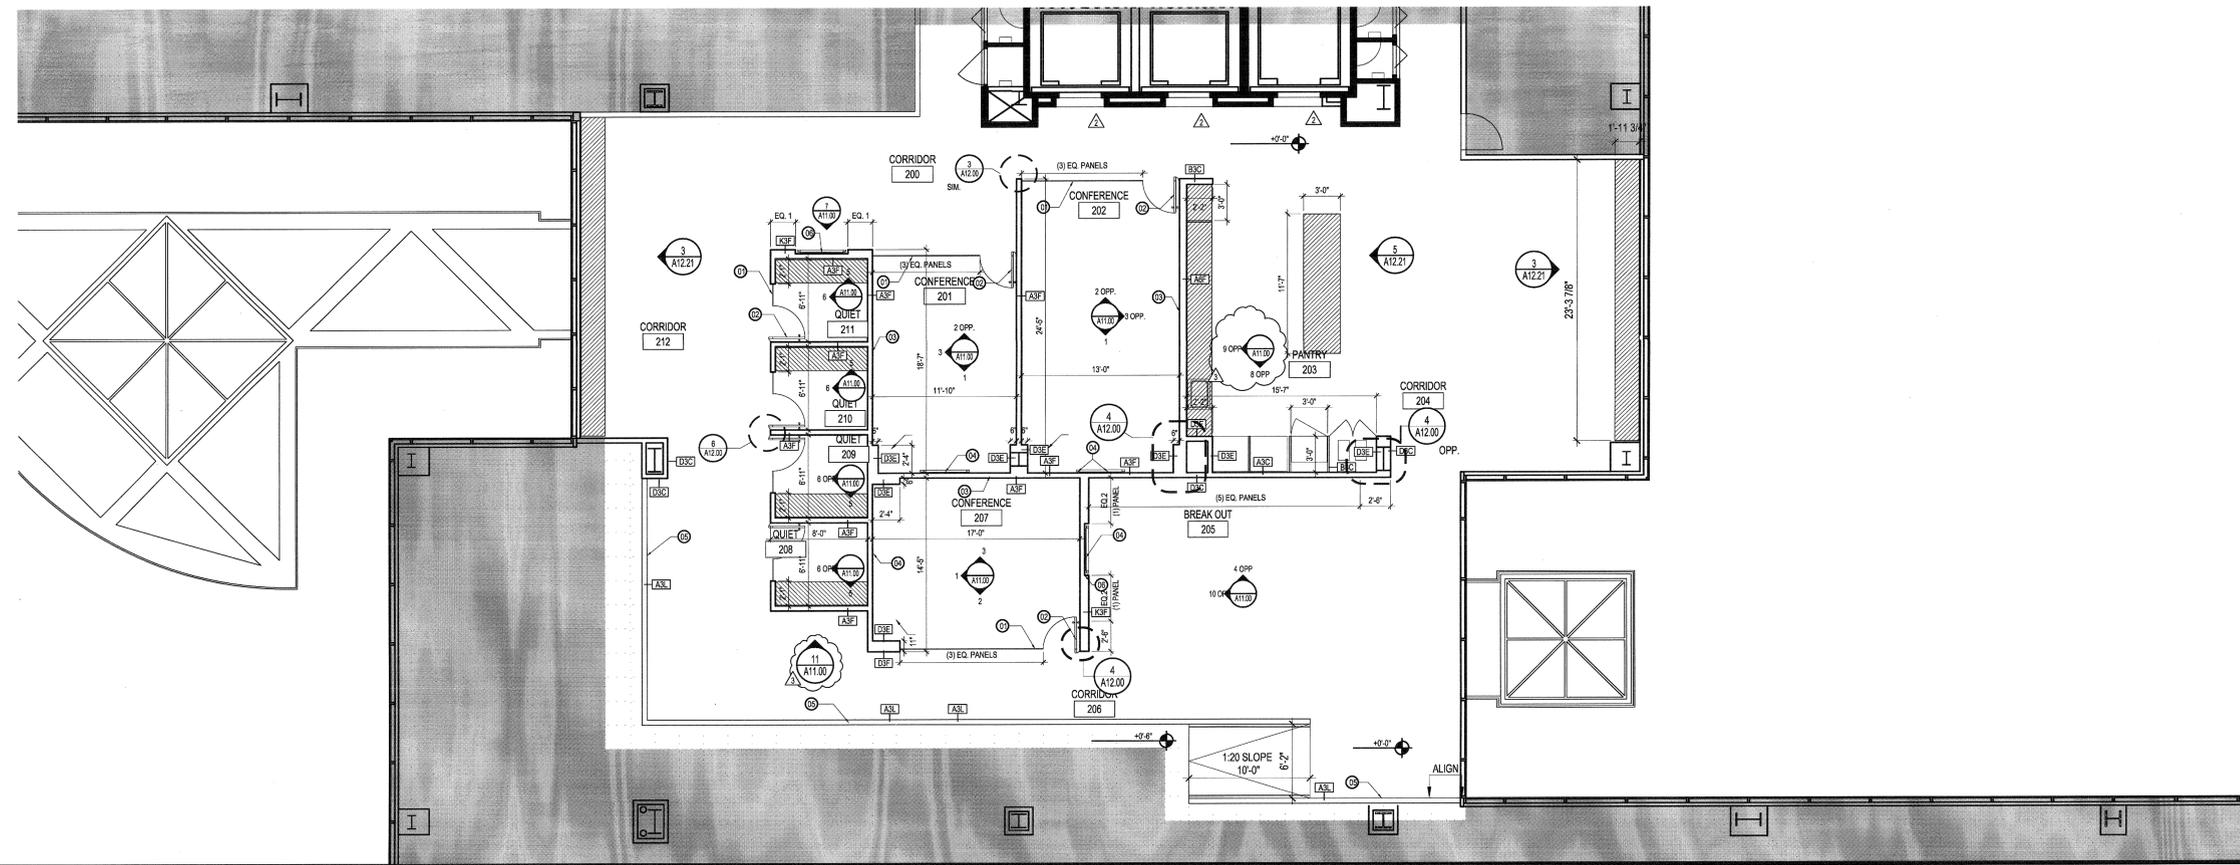

CONSTRUCTION PLAN

1

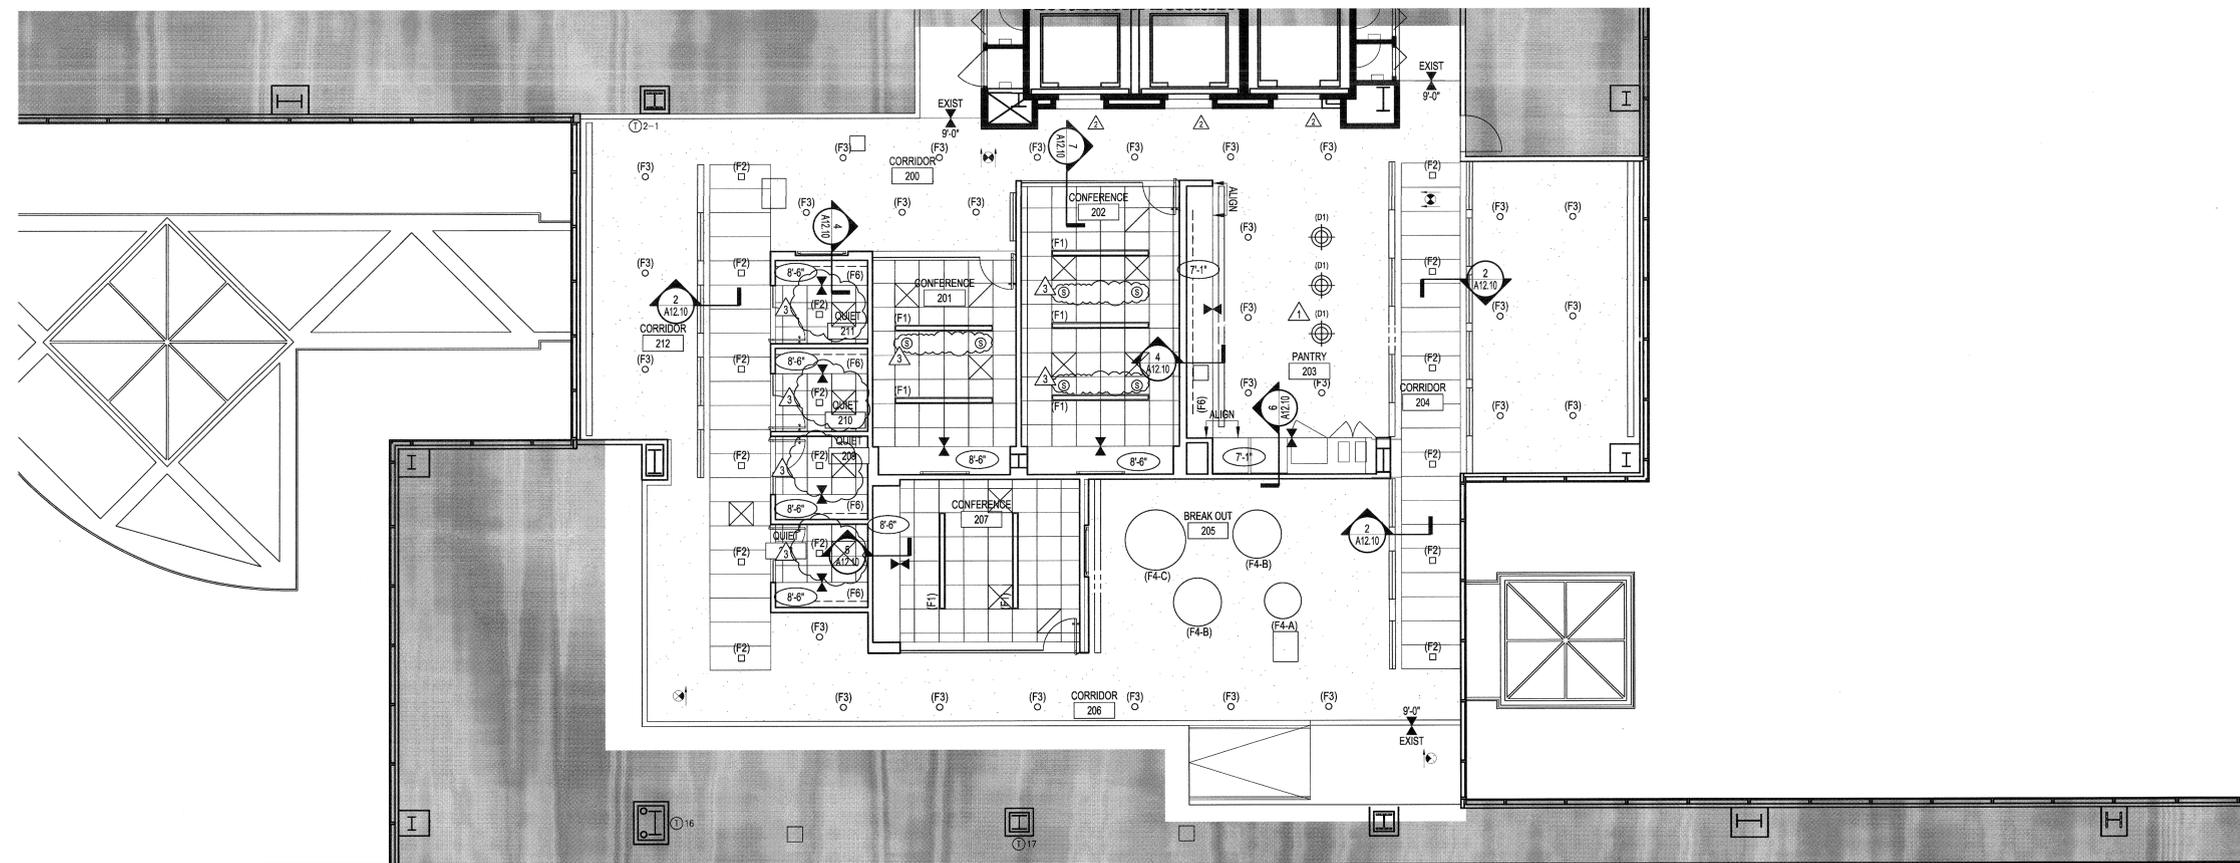

REFLECTED CEILING PLAN

2

SHEET NOTES

- (01) 1/2" THICK TEMPERED GLASS, BUTT GLAZED W/ STRUCTURAL SILICONE JOINTS, IN 1" ALUMINUM CHANNEL.
- (02) TEMPERED GLASS DOOR IN ALUMINUM FRAME.
- (03) PROVIDE BLOCKING FOR GLASS MARKERBOARD. SEE ELEVATIONS FOR LOCATION.
- (04) PROVIDE BLOCKING FOR MONITOR. COORDINATE HEIGHT WITH AV DRAWINGS.
- (05) WALL HEIGHT 3'-6" ABOVE SLAB.
- (06) PROVIDE BLOCKING FOR MONITOR.

LEGEND

- (F1) 8' X 6" RECESSED FLUORESCENT.
- (F2) 4 1/2" SQUARE LED DOWNLIGHT.
- (F3) 4 1/2" ROUND LED DOWNLIGHT.
- (F4-A) 36" ROUND FLUORESCENT.
- (F4-B) 48" ROUND FLUORESCENT.
- (F4-C) 60" ROUND FLUORESCENT.
- (F4-D) 24" ROUND FLUORESCENT.
- (F5) 2' X 4" RECESSED FLUORESCENT.
- (F5A) 6' X 4" RECESSED FLUORESCENT.
- (F5B) 4" CONTINUOUS RUN RECESSED FLUORESCENT. LENGTH VARIES IN WHOLE FEET.
- (F6) 3" MICRO STAGGERED CHANNEL.
- (F7) 1" LED MODULAR TASK LIGHT.
- (F8) LED LINEAR FLEX LIGHT.
- (F9) REMOTE STRIP LIGHT.
- (F10) 6" CONTINUOUS RUN RECESSED FLUORESCENT. LENGTH VARIES IN WHOLE FEET.
- (F11) 4" X 8" VERTICAL RECESSED FLUORESCENT.
- (F12) 24" X 24" RECESSED FLUORESCENT.
- (D1) 19 1/2" DECORATIVE PENDANT LIGHT FIXTURE.
- (D2) 3.7" DECORATIVE PENDANT LIGHT FIXTURE.

GENERAL NOTES

- 1. REFER TO PROJECT MANUAL FOR LIGHTING SCHEDULE.



1800 Solar Drive
Oxnard, CA 93030

Gensler

SYSKA HENNESSY
group
A member company of SH Group, Inc.

1230 Avenue of the Americas
Suite 1500
New York, NY 10020
Telephone: 212.492.1400
Facsimile: 212.492.1472

Syska Hennessy Group, Inc.
800 Corporate Pointe
Suite 200
Calver City, CA 90230
Telephone: 310.312.0200
Fax: 310.473.7468

Issue	Date & Issue Description	By	Check
01	06/22/12	SJ	SJ
PROGRESS SET			
02	07/31/12	ES/MC	SJ
Issued for Plan Check			
03	08/10/12	ES/MC	SJ
ISSUED FOR CONSTRUCTION			
04	10/05/12	ES/MC	SJ
REVISED FOR PLAN CHECK COMMENTS			

Seal/Signature



Project Name
VERIZON V.I.P.

Project Number
06.8740.000
CAD File Name


Description
ENLARGED PLANS

Scale
3/16" = 1'-0"

A08.40_SD




©2012 Gensler

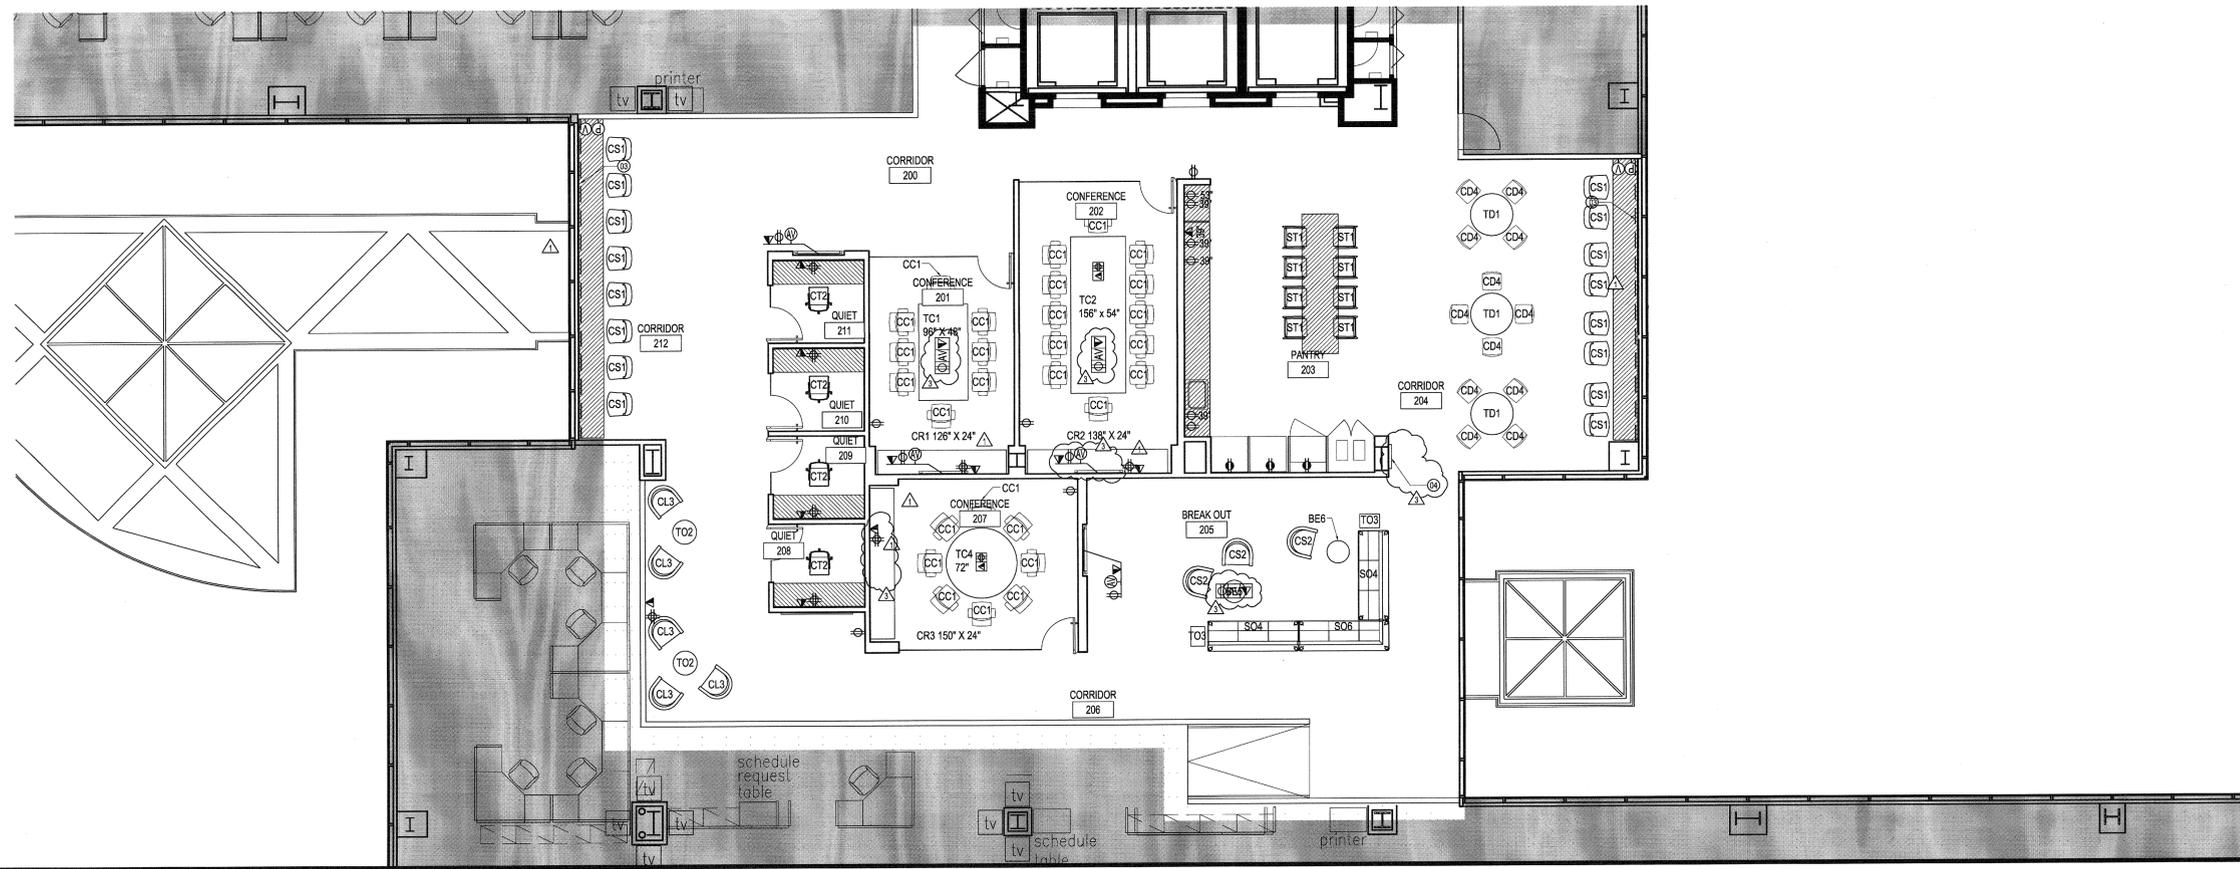

FURNITURE AND POWER PLAN

1

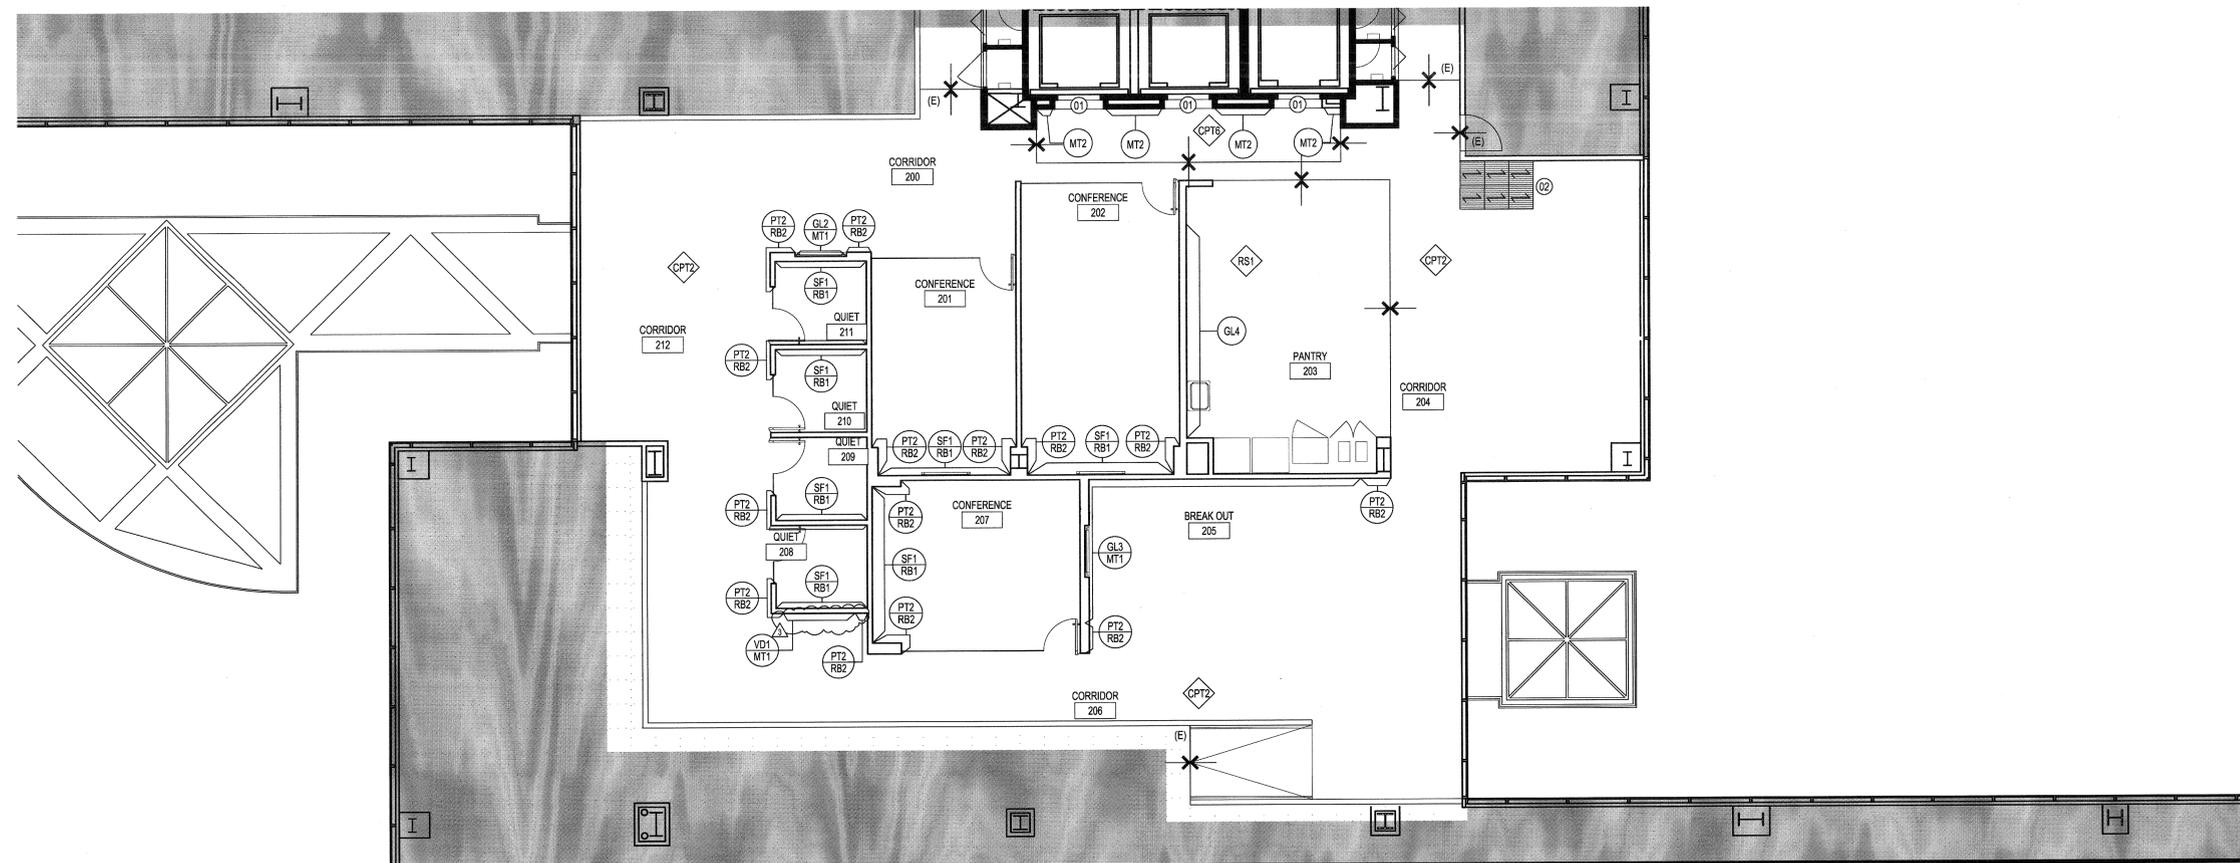

FINISH PLAN

2

SHEET NOTES

- 01 EXISTING STAINLESS STEEL ELEVATOR DOORS AND FRAMES TO REMAIN. CLEAN AND POLISH.
- 02 CARPET TO BE INSTALLED WITH MONOLITHIC LAYOUT WITH PATTERN DIRECTION AS SHOWN.
- 03 PLUGMOLD WITH POWER AND DATA OUTLETS @ 6'-0" O.C.
- 04 NEW WALL MOUNTED GLASS DISPLAY CASE BY PETER PEPPER, 24"W x 36"H, ANODIZED ALUMINUM FRAME. TACKABLE SURFACE TO BE STANDARD FORBO 2202.

1800 Solar Drive
Oxnard, CA 93030

1230 Avenue of the Americas
Suite 1500
New York, NY 10020
Telephone: 212.492.1400
Facsimile: 212.492.1472

Gensler

Syska Hennessy Group, Inc.
800 Corporate Pointe
Suite 200
Culver City, CA 90230
Telephone: 310.312.0200
Fax: 310.473.7468

Issue	Date & Issue Description	By	Check
01	06/22/12	SJ	SJ
PROGRESS SET			
02	07/31/12	ES/MC	SJ
Issued for Plan Check			
1	08/10/12	ES/MC	SJ
ISSUED FOR CONSTRUCTION			
04	09/04/12	SLR	SJ
ISSUED FOR FURN PRICING			
2	09/12/12	ES/MC	SJ
BULLETIN #1			
3	10/05/12	ES/MC	SJ
REVISED FOR PLAN CHECK COMMENTS			

GENERAL NOTES

1. ALL UNTAGGED WALLS TO RECEIVE PT1 PAINT AND RB1 BASE.
2. ALL GLASS WALLS AND DOORS TO BE GL1 WITH GF1 FILM APPLIED AS INDICATED IN ELEVATION.
3. ALL CONFERENCE TABLES TO HAVE POWER/DATA/AV BOX AT TABLE LEVEL. PROVIDE POKE THRU AT FLOOR SLAB. SEE ELECTRICAL DRAWINGS FOR FURTHER INFORMATION.
4. FURNITURE VENDOR TO PROVIDE QUANTITY OF FURNITURE NOTED/TAGGED.
5. ALL NEW FURNITURE IS PROVIDED AND INSTALLED BY FURNITURE VENDOR.
6. REFER TO AV PACKAGE FOR ALL AV EQUIPMENT INFORMATION WHERE APPLICABLE.
7. VERIFY FURNITURE DIMENSIONS FOR LAYOUT INFIELD.
8. SEE FURNITURE SPECIFICATION DOCUMENT FOR ALL NEW FURNITURE NOTED/TAGGED.

Seal/Signature

Project Name
VERIZON V.I.P.



Project Number
06.8740.000
CAD File Name

Description
ENLARGED PLANS

Scale
3/16" = 1'-0"

A08.41_SD

©2012 Gensler

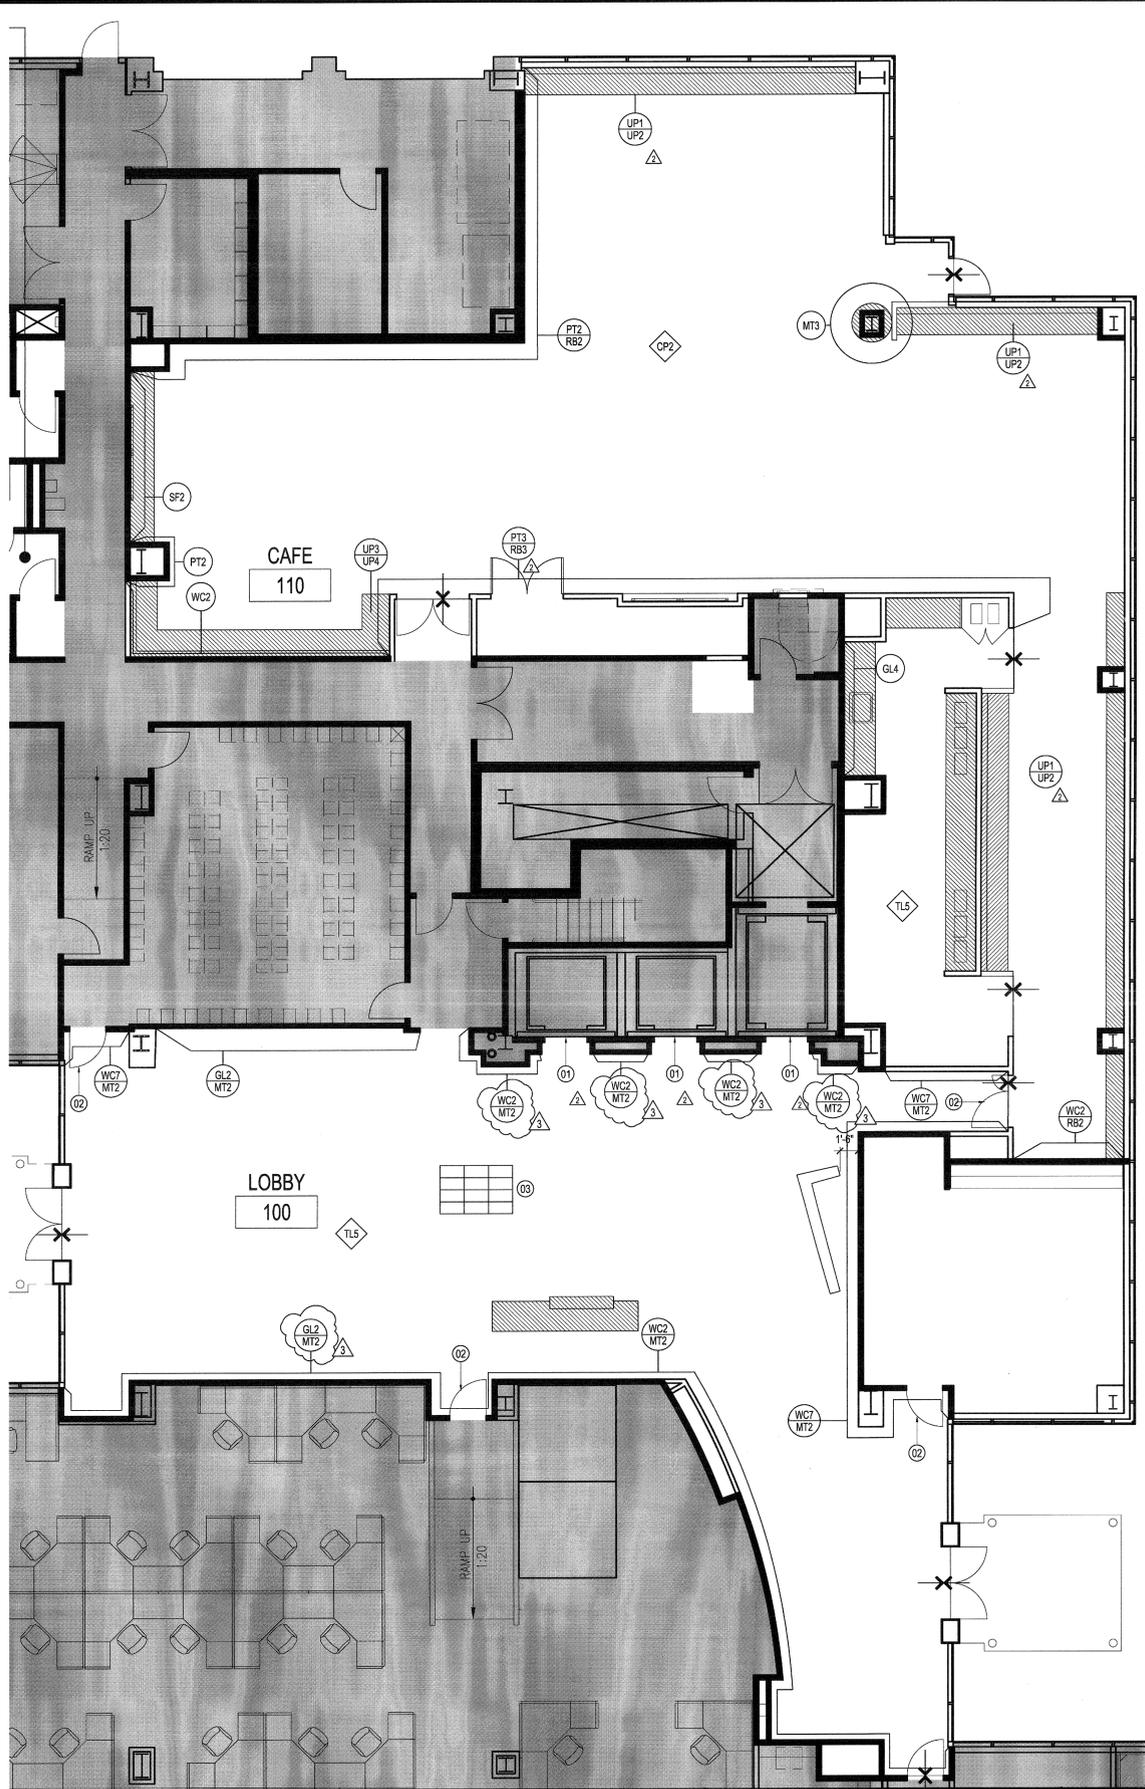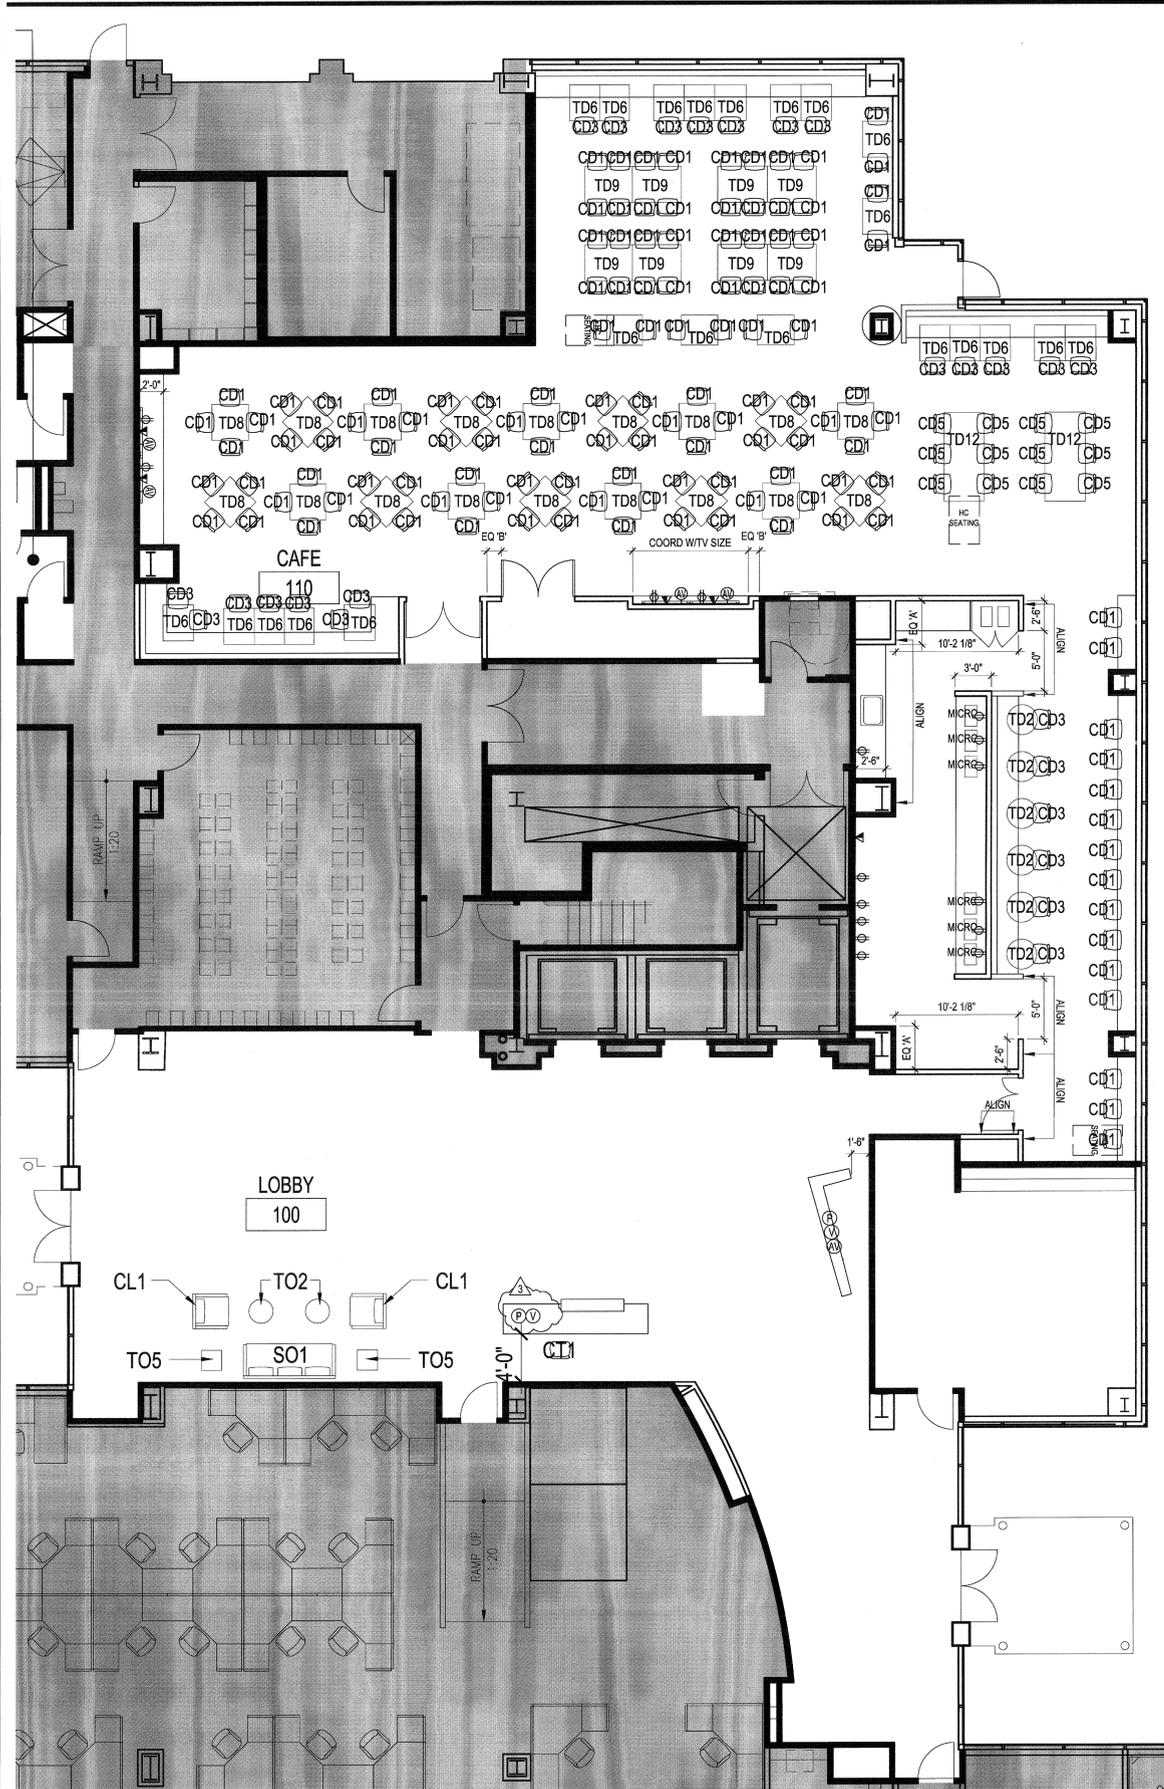

SHEET NOTES

- 01 EXISTING STAINLESS STEEL ELEVATOR DOORS AND FRAMES TO REMAIN. CLEAN AND POLISH.
- 02 PAINT DOOR PT1.
- 03 INSTALL FLOOR WITH TILE LAYOUT AS SHOWN.

GENERAL NOTES

1. FURNITURE IS SHOWN FOR REFERENCE ONLY.
2. PAINT WALLS AND CEILING GYP BOARD PT1, U.O.N.
3. FURNITURE VENDOR TO PROVIDE QUANTITY OF FURNITURE NOTED/TAGGED.
4. ALL NEW FURNITURE IS PROVIDED AND INSTALLED BY FURNITURE VENDOR.
5. REFER TO AV PACKAGE FOR ALL AV EQUIPMENT INFORMATION WHERE APPLICABLE.
6. VERIFY FURNITURE DIMENSIONS FOR LAYOUT IN FIELD.
7. SEE FURNITURE SPECIFICATION DOCUMENT FOR ALL NEW FURNITURE NOTED/TAGGED.

1800 Solar Drive
Oxnard, CA 93030

1230 Avenue of the Americas
Suite 1500
New York, NY 10020
Telephone: 212.492.1400
Facsimile: 212.492.1472

Gensler

SYSKA HENNESSY GROUP
A member company of SHI Group, Inc.

Syska Hennessy Group, Inc.
800 Corporate Pointe
Suite 200
Culver City, CA 90230
Telephone: 310.312.0200
Fax: 310.473.7468

Issue	Date & Issue Description	By	Check
01	07/31/12 ISSUED FOR PERMIT/BID	ES	SJ
1	08/10/12 ISSUED FOR CONSTRUCTION	ES/MC	SJ
03	09/04/12 ISSUED FOR FURN PRICING	SLR	SJ
2	08/12/12 BULLETIN #1	ES/MC	SJ
3	10/05/12 REVISED FOR PLAN CHECK COMMENTS	ES/MC	SJ

Seal/Signature

Project Name
VERIZON V.I.P.

Project Number
08.8740.000

CAD File Name


Description
CAFETERIA ENLARGED PLANS

Scale
3/16" = 1'-0"


A08.78_SD

©2012 Gensler


1. W/D OF P.H.U. UNITS, LAUNDRY, DISHWASHERS, ETC. TO BE PROVIDED BY OTHER TRADES. SEE SPECIFICATIONS FOR DETAILS.

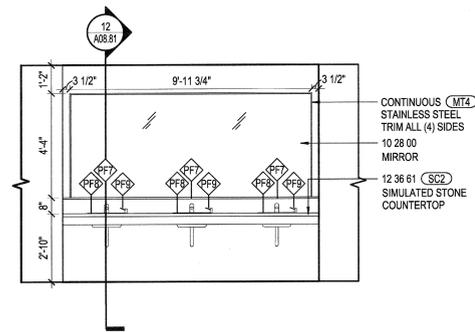


TYPICAL RESTROOM ELEVATION 9
SCALE: 3/8" = 1'-0"

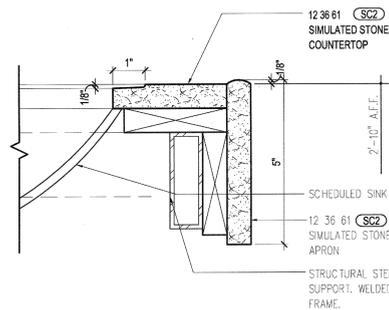


LAVATORY COUNTER EDGE DETAIL 10
SCALE: 6" = 1'-0"

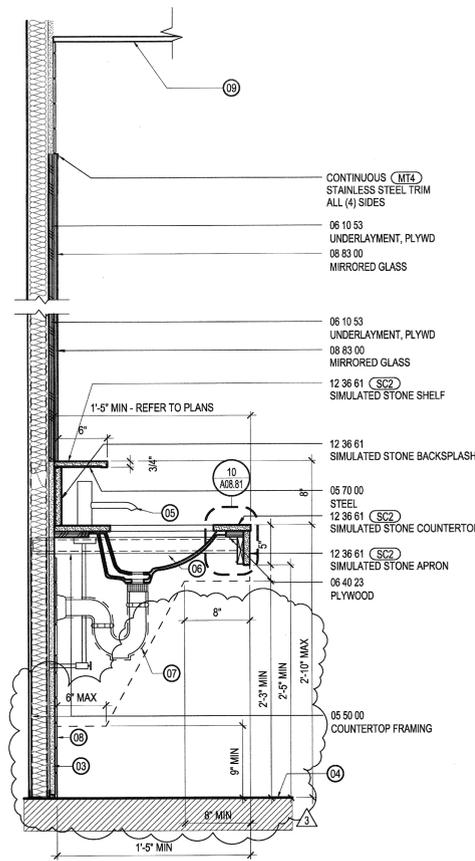

LAVATORY COUNTER/MIRROR 12
SCALE: 1 1/2" = 1'-0"

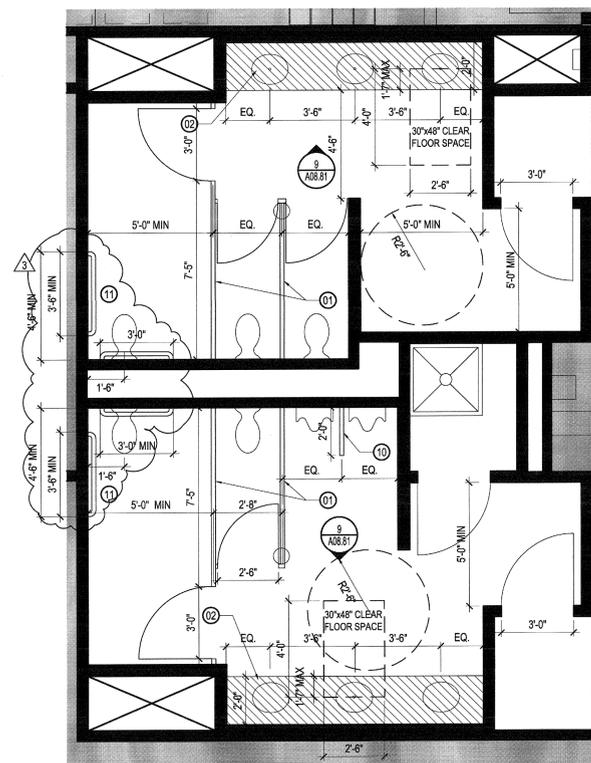

TYPICAL GROUND FLOOR RESTROOM PLAN 2
SCALE: 3/8" = 1'-0"

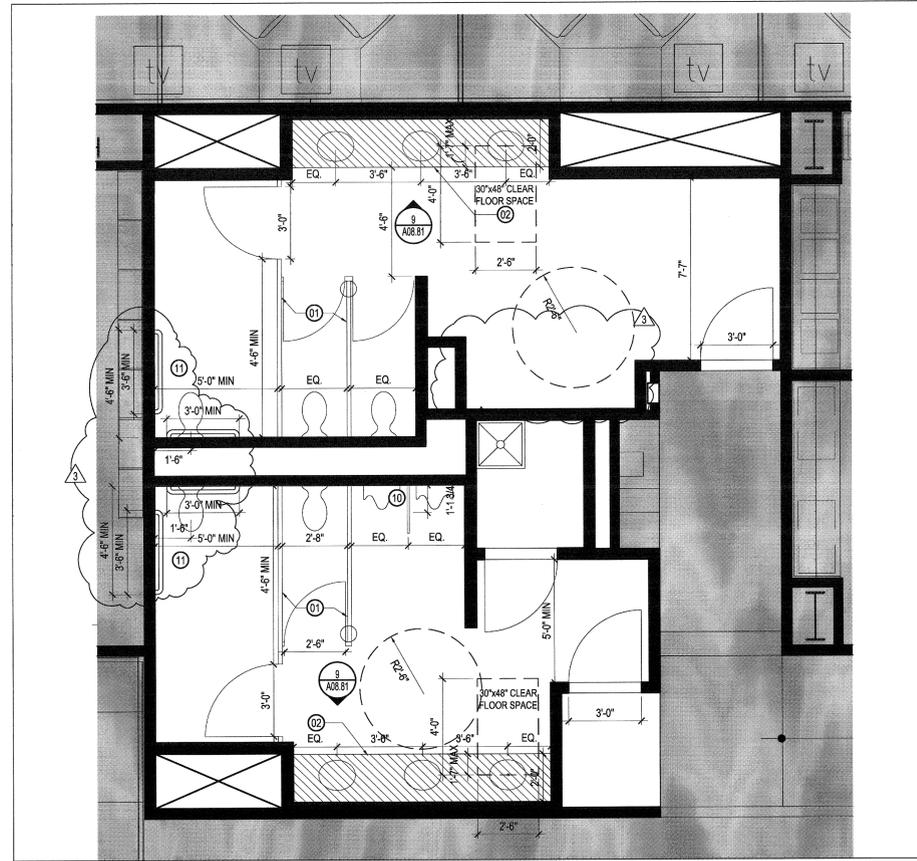

TYPICAL SECOND AND THIRD FLOOR RESTROOM PLAN 4
SCALE: 3/8" = 1'-0"

SHEET NOTES

- 01 REMOVE AND REPLACE EXISTING PARTITIONS. SEE INTERIOR SPECIALTIES SCHEDULE FOR SPECIFICATION/FINISH.
- 02 REMOVE AND REPLACE EXISTING COUNTER, SINK & FAUCET.
- 03 SCHEDULED OR EXISTING PARTITION; REFER TO CONSTRUCTION PLAN FOR ADDITIONAL INFORMATION.
- 04 SCHEDULED OR EXISTING FINISH FLOOR; REFER TO FINISH PLAN.
- 05 SCHEDULED FAUCET SET; REFER TO ELEVATIONS AND PLUMBING SCHEDULE.
- 06 SCHEDULED SINK; REFER TO ELEVATIONS AND PLUMBING SCHEDULE.
- 07 PIPE INSULATION; REFER TO ENGINEERING DRAWINGS FOR SPECIFICATION.
- 08 EXISTING CERAMIC TILE.
- 09 EXISTING SUSPENDED CEILING.
- 10 NEW 42" HIGH URINAL SCREEN.
- 11 NEW GRAB BARS 2'-9" AFF.

GENERAL NOTES

- 1. PATCH AND REPAIR WALL AND FLOOR TILE AS REQUIRED AFTER REMOVAL OF PARTITIONS AND COUNTER.
- 2. EXISTING CEILING AND LIGHT FIXTURES TO REMAIN. PATCH AS REQUIRED ANY DAMAGE DUE TO DEMOLITIONS.
- 3. EXISTING TOILET AND URINAL FIXTURES TO REMAIN.



1800 Solar Drive
Oxnard, CA 93030

Gensler

Syska Hennessy Group
A member company of SH Group, Inc.

1230 Avenue of the Americas
Suite 1500
New York, NY 10020
Telephone: 212.492.1400
Facsimile 212.492.1472

Syska Hennessy Group, Inc.
800 Corporate Pointe
Suite 200
Culver City, CA 90230
Telephone: 310.312.0200
Fax: 310.473.7468

Issue	Date & Issue Description	By	Check
01	07/31/12	ES/MC	SJ
1	08/10/12	ES/MC	SJ
3	10/05/12	ES/MC	SJ

Scale/Signature



Project Name

VERIZON V.I.P.

Project Number

06 8740.000

CAD File Name

Description


TYPICAL RESTROOM DETAILS

Scale


A08.81_SD




©2012 Gensler

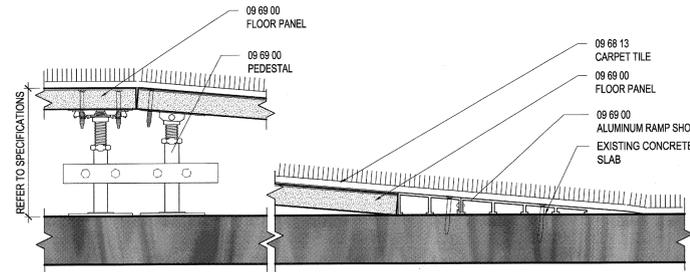


TYPICAL RAISED FLOOR RAMP SECTION
SCALE: 3" = 1'-0"

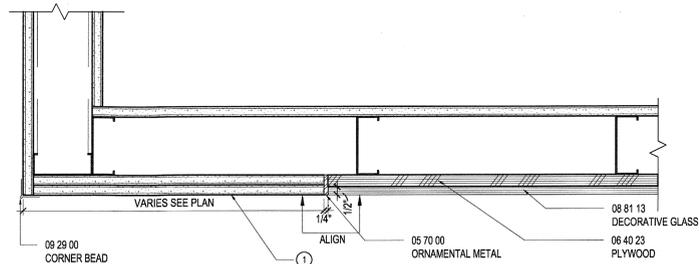


PLAN DETAIL AT GLASS GYP TRANSITION
SCALE: 3" = 1'-0"

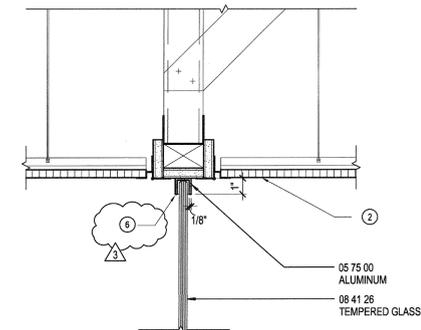


GLASS HEAD DETAIL
SCALE: 3" = 1'-0"

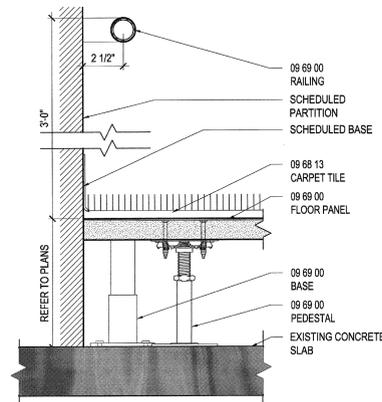


RAILING AT RAISED FLOOR RAMP
SCALE: 3" = 1'-0"
DT_RP_000829

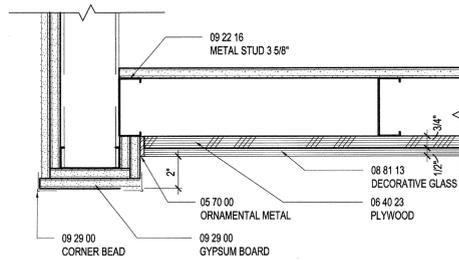


PLAN DETAIL AT CORNER
SCALE: 3" = 1'-0"

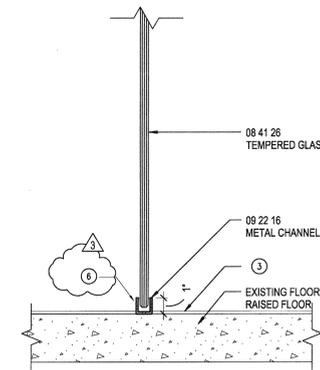

GLASS BASE DETAIL
SCALE: 3" = 1'-0"

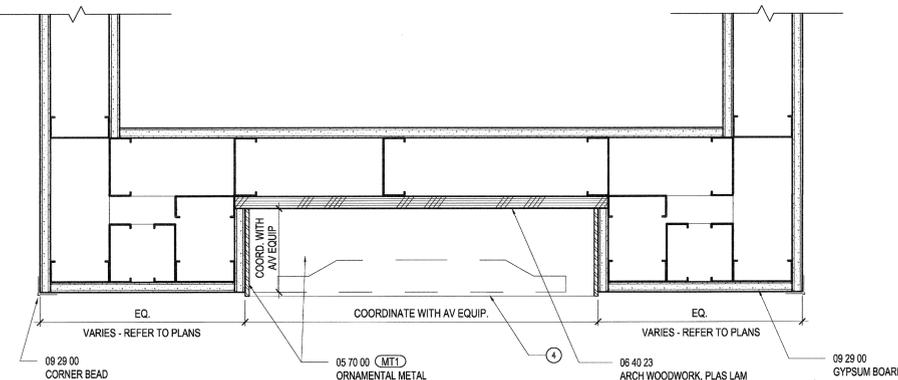


PLAN DETAIL AT INTERACTIVE KIOSK
SCALE: 3" = 1'-0"

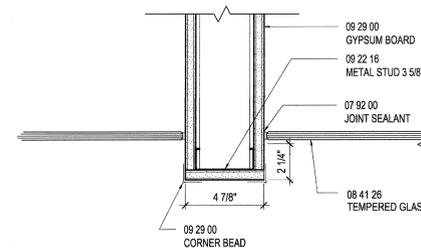


TRANSITION DETAIL GLAZING TO GYP
SCALE: 3" = 1'-0"

GENERAL NOTES

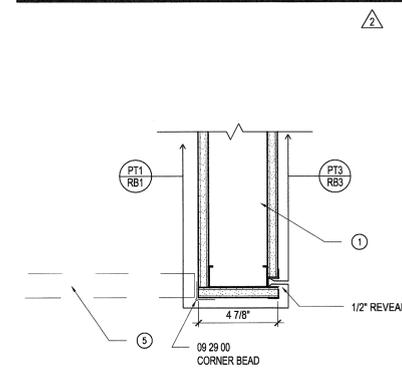

REVEAL AT PAINT TRANSITION
SCALE: 3" = 1'-0"

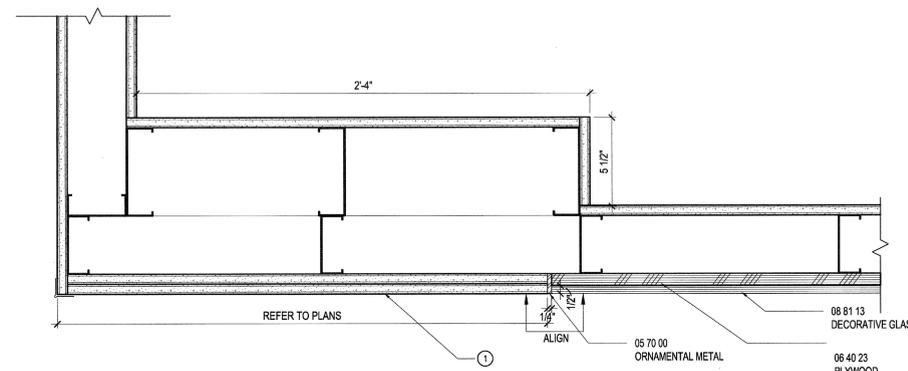

PLAN DETAIL AT CORNER
SCALE: 3" = 1'-0"

Seal/Signature

Project Name
VERIZON V.I.P.

Project Number
06.8740.000

CAD File Name
A12-00

Description
TYPICAL GLASS FRONT AND PLAN DETAILS

Scale
0 3' 6' 1'

A12.00_SD

©2012 Gensler

SHEET NOTES

- ① SCHEDULED OR EXISTING PARTITION; REFER TO CONSTRUCTION PLAN
- ② SCHEDULED OR EXISTING CEILING; REFER TO REFLECTED CEILING PLAN
- ③ SCHEDULED OR EXISTING FLOOR FINISH; REFER TO FINISH PLAN
- ④ SCHEDULED MONITOR
- ⑤ SCHEDULED DOOR
- ⑥ ATTACHMENT THROUGH STRUCTURAL SILICONE



1800 Solar Drive
Oxnard, CA 93030


Gensler

SYSKA HENNESSY GROUP
A member company of SH Group, Inc.


1230 Avenue of the Americas
Suite 1500
New York, NY 10020
Telephone: 212.492.1400
Facsimile 212.492.1472

Syska Hennessy Group, Inc.
800 Corporate Pointe
Suite 200
Calver City, CA 90230
Telephone: 310.312.0200
Fax: 310.473.7468


Issue	Date & Issue Description	By	Check
01	06/22/12	SJ	SJ
PROGRESS SET			
02	07/31/12	ESMC	SJ
Issued for Plan Check			
1	08/10/12	ESMC	SJ
ISSUED FOR CONSTRUCTION			
2	09/12/12	ESMC	SJ
BULLETIN #1			
3	10/05/12	ESMC	SJ
REVISED FOR PLAN CHECK COMMENTS			

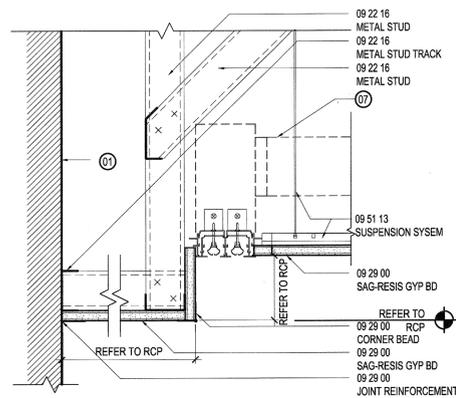


LINEAR DIFFUSER @ GWB SOFFIT 9
SCALE: 3" = 1'-0"

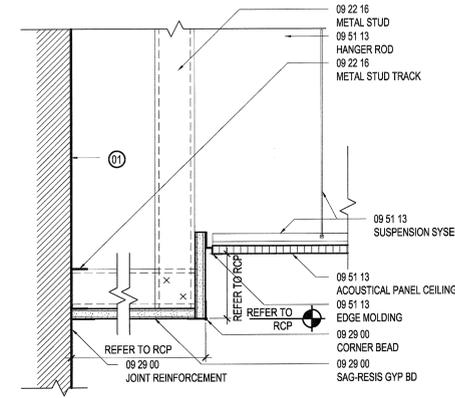


GWB SOFFIT @ ACT CEIL. 5
SCALE: 3" = 1'-0"

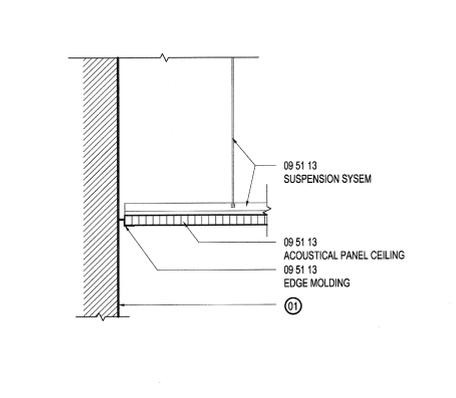


TYP. SHADOW MOLDING DETAIL 1
SCALE: 3" = 1'-0"

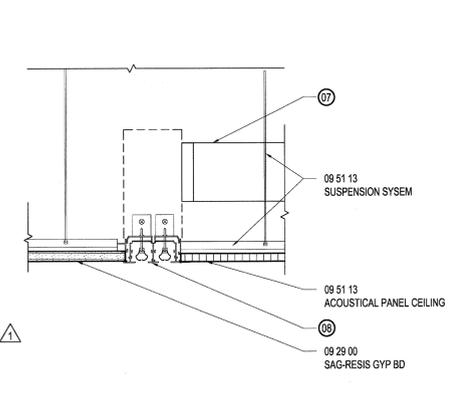


LINEAR DIFFUSER @ GWB & ACT 10
SCALE: 3" = 1'-0"

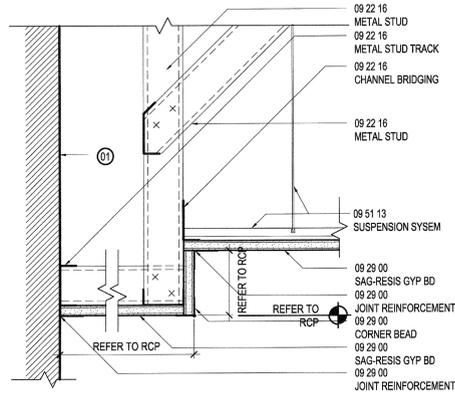


GWB SOFFIT @ GWB CEIL. 6
SCALE: 3" = 1'-0"

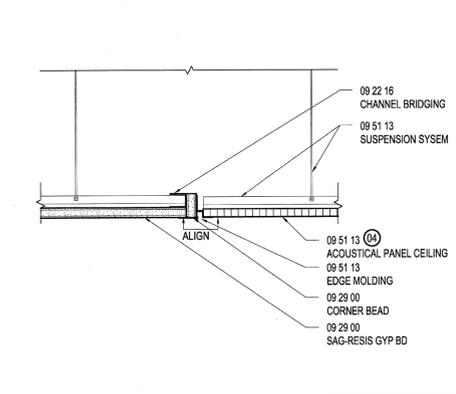


FLUSH CEILING TRANSITION 2
SCALE: 3" = 1'-0"

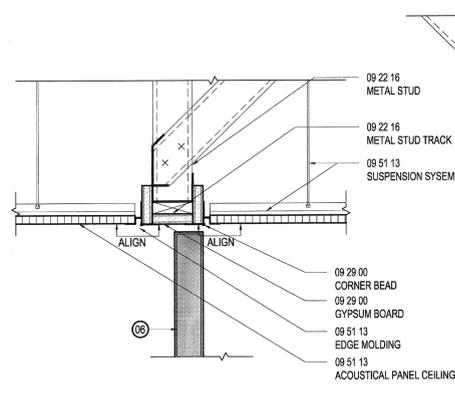

FLUSH HEADER 7
SCALE: 3" = 1'-0"

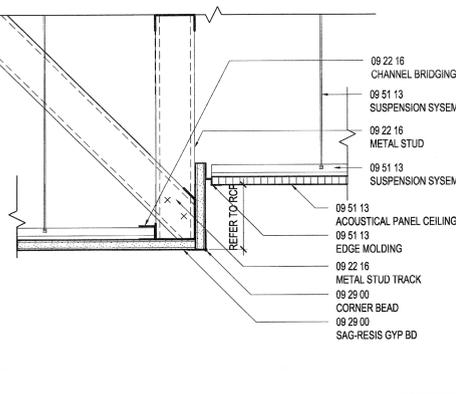

TYP. STEPPED HEADER 3
SCALE: 3" = 1'-0"

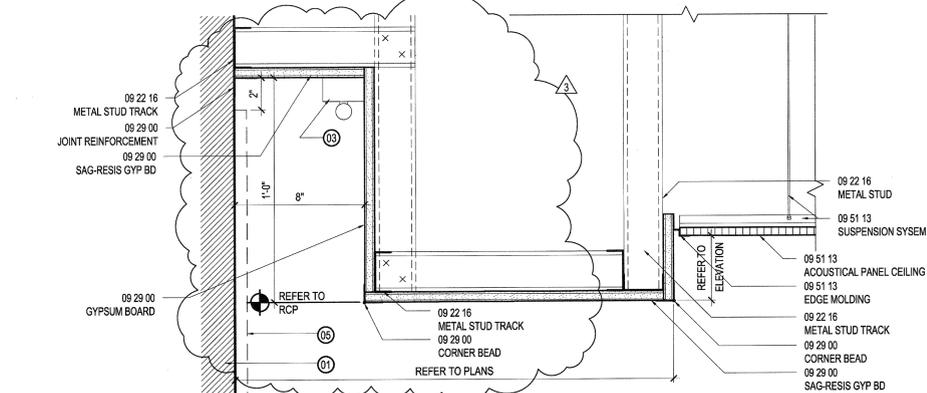

TYP. LIGHT COVE 4
SCALE: 3" = 1'-0"

SHEET NOTES

- ① SCHEDULED OR EXISTING PARTITION; REFER TO CONSTRUCTION PLAN
- ② RETURN AIR SLOT; REFER TO ENGINEERING DRAWINGS
- ③ SCHEDULED LIGHT FIXTURE; REFER TO REFLECTED CEILING PLAN
- ④ NEW OR EXISTING; REFER TO RCP.
- ⑤ SCHEDULED WALL FINISH; REFER TO FINISH PLAN. SCHEDULED FINISH TO EXTEND UP TO 2" BELOW COVE CEILING AS SHOWN.
- ⑥ SCHEDULED DOOR IF APPLICABLE.



1800 Solar Drive
Oxnard, CA 93030



1230 Avenue of the Americas
Suite 1500
New York, NY 10020
Telephone: 212.492.1400
Facsimile: 212.492.1472



Syska Hennessy Group, Inc.
800 Corporate Pointe
Suite 200
Culver City, CA 90230
Telephone: 310.312.0200
Fax: 310.473.7468

Issue	Date & Issue Description	By	Check
01	06/22/12	SJ	SJ
PROGRESS SET			
02	07/31/12	ES/MC	SJ
Issued for Plan Check			
1	03/08/10/12	ES/MC	SJ
ISSUED FOR CONSTRUCTION			
3	04/10/05/12	ES/MC	SJ
REVISED FOR PLAN CHECK COMMENTS			

GENERAL NOTES

Seal/Signature

Project Name
VERIZON V.I.P.

Project Number
06.8740.000


CAD File Name
A12-00

Description
TYPICAL CEILING DETAILS


Scale

A12.10_SD


©2012 Gensler

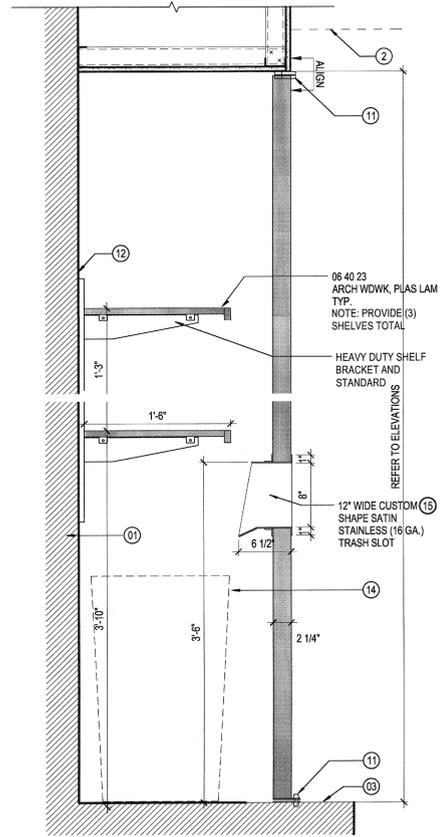


TRASH CABINET
SCALE: 1 1/2" = 1'-0"

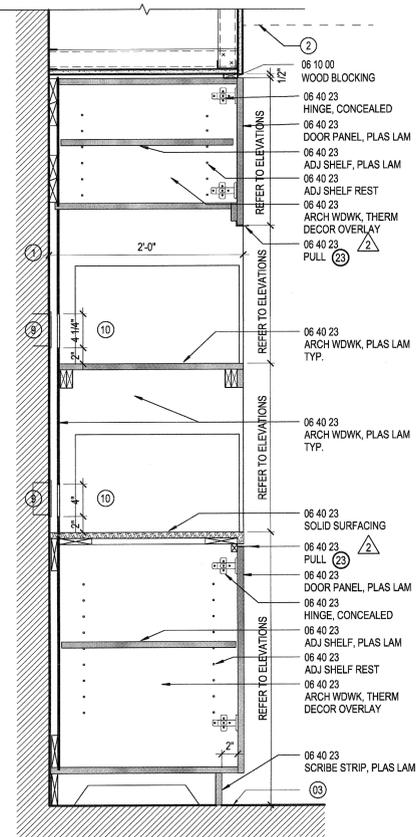


MICROWAVE TOWER
SCALE: 1 1/2" = 1'-0"

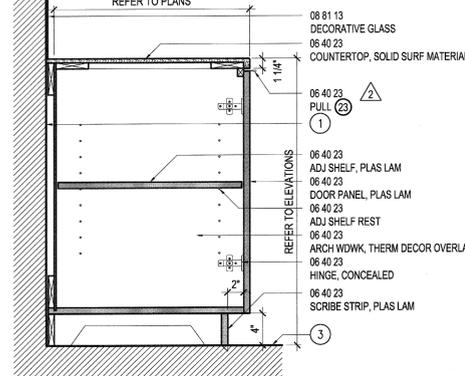


BASE CABINET
SCALE: 1 1/2" = 1'-0"

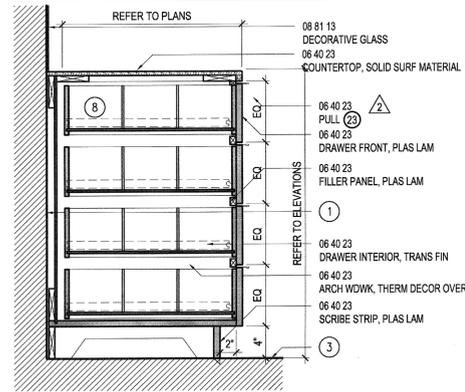


BASE CABINET WITH DRAWERS
SCALE: 1 1/2" = 1'-0"

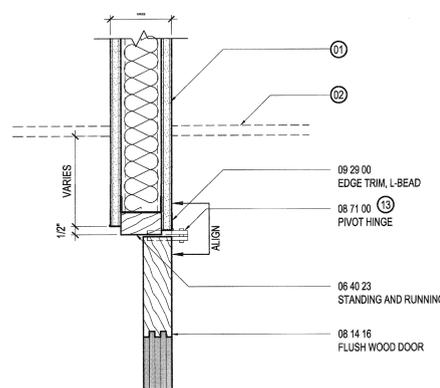


FLUSH WOOD DOOR HEAD
SCALE: 3" = 1'-0"

 


NOT USED
SCALE: 1 1/2" = 1'-0"

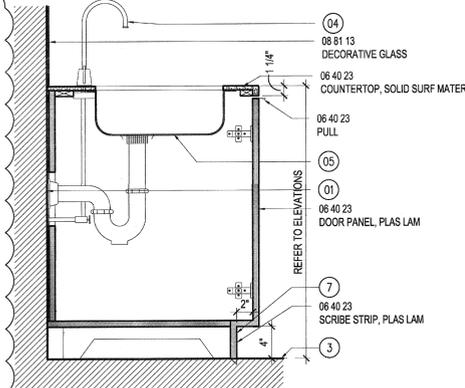


SINK CABINETS
SCALE: 1 1/2" = 1'-0"

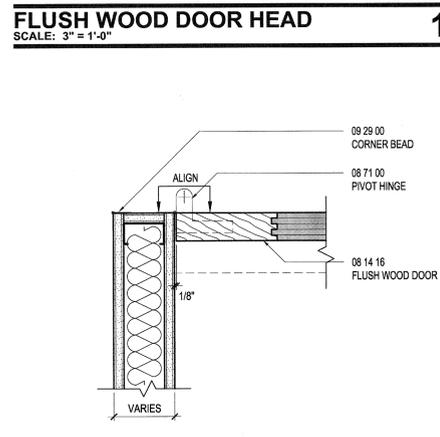

FLUSH WOOD DOOR JAMB
SCALE: 3" = 1'-0"

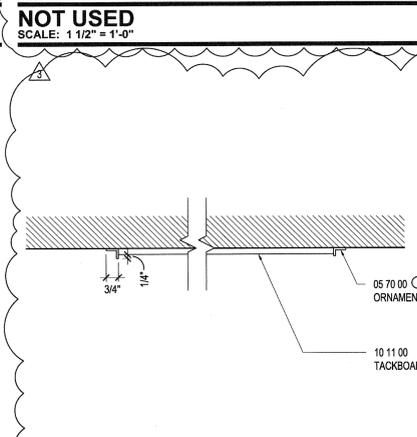

TACKBOARD EDGE PLAN DETAIL
SCALE: 3" = 1'-0"

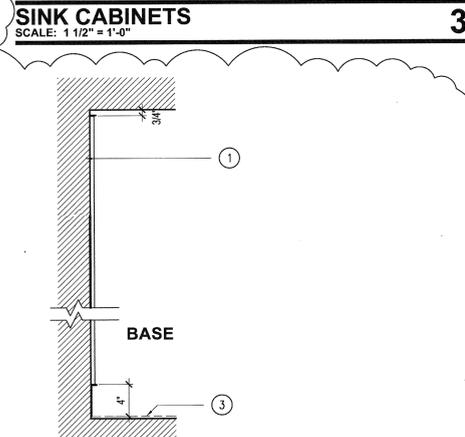

TACKBOARD SECTION DETAIL
SCALE: 1 1/2" = 1'-0"

SHEET NOTES

- (1) SCHEDULED OR EXISTING PARTITION; REFER TO CONSTRUCTION PLAN
- (2) SCHEDULED CEILING; REFER TO REFLECTED CEILING PLAN
- (3) SCHEDULED FLOOR FINISH; REFER TO FINISH PLAN
- (4) SCHEDULED FAUCET SET; REFER TO EQUIPMENT SCHEDULE
- (5) SCHEDULED SINK; REFER TO EQUIPMENT SCHEDULE
- (6) PIPE INSULATION; REFER TO ENGINEERING DRAWINGS FOR SPECIFICATION
- (7) INTEGRAL TOE KICK, NOTCH AS REQUIRED TO ALLOW DOORS TO SWING OPEN
- (8) PROVIDE REMOVEABLE DIVIDERS TO DIVIDE DRAWER INTO (6) EQUAL COMPARTMENTS
- (9) POWER OUTLET; REFER TO MEP FOR MORE INFORMATION
- (10) PROVIDE A FINISHED OPENING TO ACCESS ELECTRICAL DEVICE AND FOR EQUIPMENT VENTILATION. VERIFY OPEN DIMENSION WITH MANUFACTURERS.
- (11) OFFSET PIVOTS. REFER TO SPECIFICATIONS.
- (12) WOOD BLOCKING AS REQUIRED FOR STANDARDS AND BRACKETS
- (13) SOLID WOOD HEADER FINISHED TO MATCH ADJACENT DOOR FINISH U.O.N.
- (14) TRASH RECEPTACLE BY GC. SIZE SMALL OR LARGE. COORDINATE WITH PLANS.
- SIZE SMALL: RUBBERMAID SLIM JIM 23 GA. 30 7/8" x 20 1/2" x 11 1/2" FG354000GRAY
- SIZE LARGE: RUBBERMAID SQUARE BRUTE 40 GA. 28 3/4" x 23 1/2" x 23 1/2" FG35600GRAY
- (15) S.S. TRASH CHUTE
- (16) PAINTED PFI
- (17) SCHEDULED AV EQUIPMENT. REFER TO AV DRAWINGS FOR ADDITIONAL INFO. PROVIDE BLOCKING.
- (18) SCHEDULED VENDING MACHINE. REFER TO ELEVATIONS.
- (19) PROVIDE EXTENDED TOP PIVOT ARM ROUTED INTO DOOR FRAME TO ACCOMMODATE 5/8" GYP BOARD
- (20) LINE OF WALL BEYOND
- (21) LINE OF HEADER ABOVE
- (22) SCHEDULED LIGHT FIXTURE
- (23) PULLS TO BE VALLI & VALLI A295, 26D SATIN CHROME, SIZE B.

GENERAL NOTES

1800 Solar Drive
Oxnard, CA 93030

1230 Avenue of the Americas
Suite 1500
New York, NY 10020
Telephone: 212.492.1400
Facsimile: 212.492.1472

Gensler

Syska Hennessy Group, Inc.
800 Corporate Pointe
Suite 200
Culver City, CA 90230
Telephone: 310.312.0200
Fax: 310.473.7466

Issue	Date & Issue Description	By	Check
01	06/22/12 PROGRESS SET	SJ	SJ
02	07/31/12 ISSUED FOR PLAN CHECK	ESMC	SJ
1	08/10/12 ISSUED FOR CONSTRUCTION	ESMC	SJ
2	09/12/12 BULLETIN #1	ESMC	SJ
3	10/05/12 REVISED FOR PLAN CHECK COMMENTS	ESMC	SJ

Seal/Signature

Project Name
VERIZON V.I.P.

Project Number
06.8740.000


CAD File Name
A12-00

Description
TYPICAL MILLWORK DETAILS

Scale
0 3' 6" 1'


A12.20_SD

©2012 Gensler

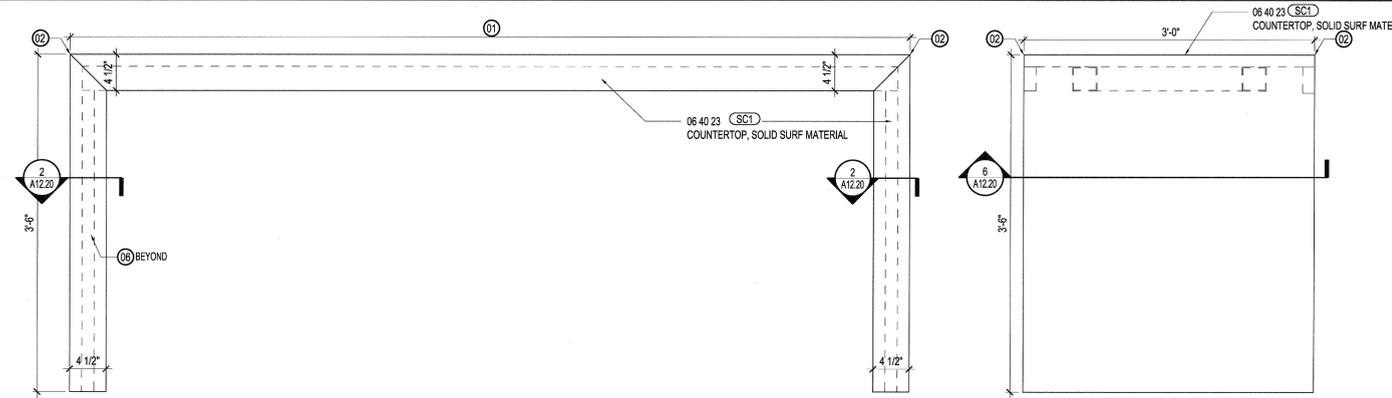


PANTRY TABLE ELEVATION
SCALE: 1 1/2" = 1'-0"

PANTRY TABLE ELEVATION
SCALE: 1 1/2" = 1'-0"

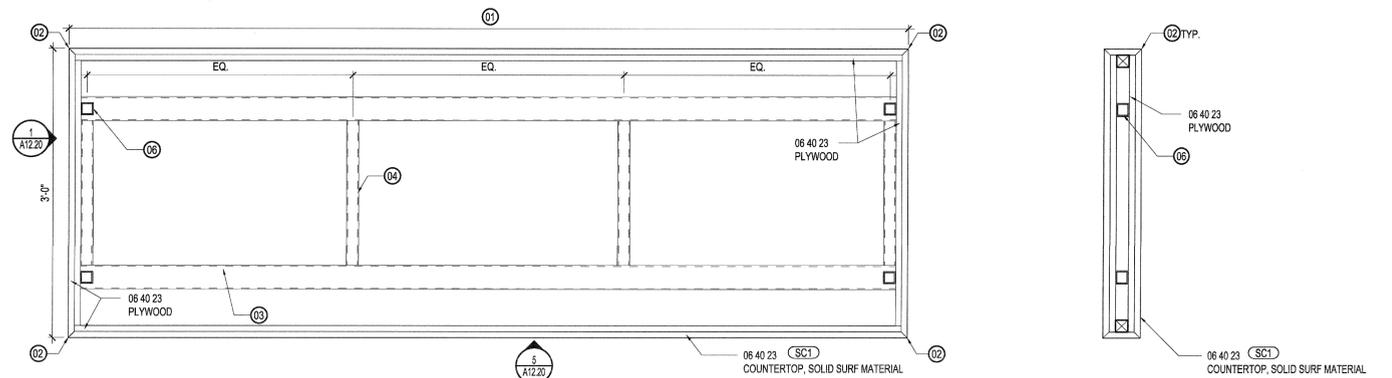


PANTRY TABLE SECTION
SCALE: 1 1/2" = 1'-0"

PANTRY TABLE SECTION
SCALE: 1 1/2" = 1'-0"

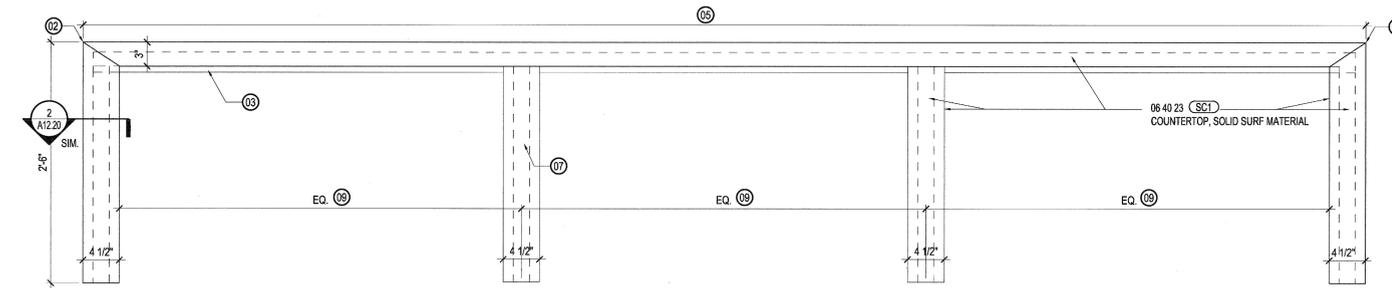


TOUCHDOWN TABLE ELEVATION
SCALE: 1 1/2" = 1'-0"

GENERAL NOTES

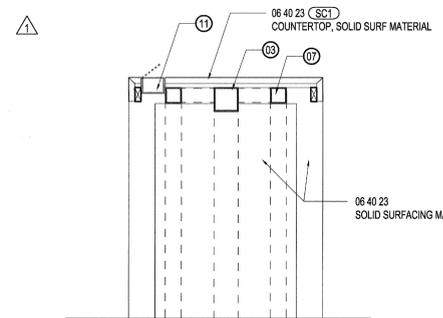

TOUCHDOWN TABLE SECTION
SCALE: 1 1/2" = 1'-0"

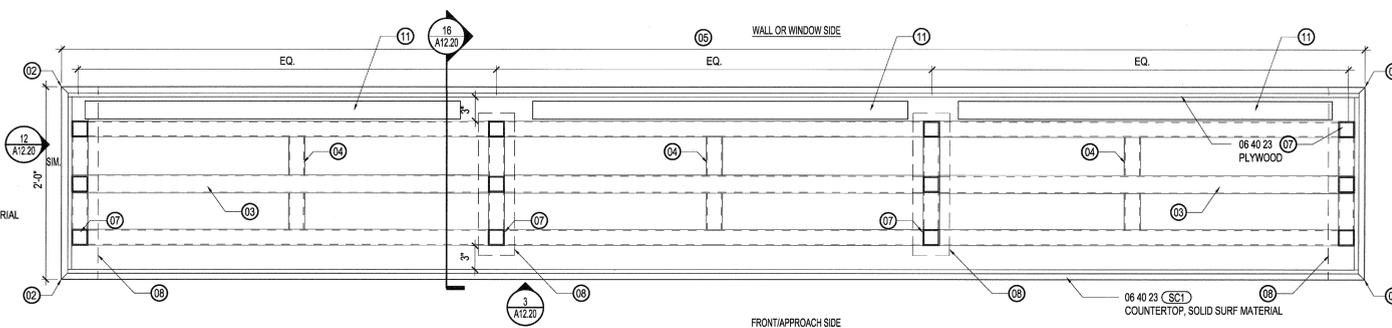

TOUCHDOWN TABLE SECTION
SCALE: 1 1/2" = 1'-0"

4

- SHEET NOTES**
- 01 REFER TO PLANS.
 - 02 1/8" QUIRK
 - 03 2 1/2" STEEL SQUARE HOLLOW SECTION. PAINT EXPOSED SURFACES PT4.
 - 04 STEEL SQUARE SECTION OUTRIGGER MAX 3'-0" O.C.
 - 05 REFER TO PLANS FOR TABLE LENGTH.
 - 06 1 1/2" SQUARE HOLLOW SECTION POST
 - 07 2" SQUARE SECTION. PAINT EXPOSED SURFACES PT4
 - 08 LINE OF LEG BELOW ENCLOSED IN SC1
 - 09 NUMBER OF VERTICAL SUPPORTS TO BE DETERMINED BY TABLE LENGTH. MAX SPAN 10'.
 - 10 STEEL HORIZONTAL SUPPORT BEYOND
 - 11 CONTINUOUS PLUGMOLD - DOUG MOCKETT FLIP DOOR TROUGH



1800 Solar Drive
Oxnard, CA 93030

1230 Avenue of the Americas
Suite 1500
New York, NY 10020
Telephone: 212.492.1400
Facsimile: 212.492.1472

Gensler

Syska Hennessy Group

Syska Hennessy Group, Inc.
800 Corporate Pointe
Suite 200
Calver City, CA 90230
Telephone: 310.312.0200
Fax: 310.473.7468

Issue	Date & Issue Description	By	Check
01	07/31/12	ESMC	SJ
1	08/10/12	ESMC	SJ
2	10/05/12	ESMC	SJ
3	10/05/12	ESMC	SJ

Seal/Signature



Project Name
VERIZON V.I.P.

Project Number
06.8740.000

CAD File Name
A12-00

Description
TYPICAL MILLWORK DETAILS



A12.21_SD

©2012 Gensler

PROJECT: VERIZON V.I.P. - MILLWORK DETAILS - 10/11/12 - 10/11/12 - 10/11/12 - 10/11/12



1800 Solar Drive
Oxnard, CA 93030

1230 Avenue of the Americas
Suite 1500
New York, NY 10020
Telephone: 212.492.1400
Facsimile: 212.492.1472

Gensler




SYSKA HENNESSY GROUP
A member company of SH Group, Inc.

Syska Hennessy Group, Inc.
800 Corporate Pointe
Suite 200
Calver City, CA 90230
Telephone: 310.312.0200
Fax: 310.473.7468



SHEET NOTES

- ① SCHEDULED OR EXISTING FINISH FLOOR; REFER TO FINISH PLAN
- ② NUMBER OF EQUAL CABINETS VARIES. REFER TO PLANS FOR COUNTER WIDTH. CABINET SIZES TO BE MAXIMIZED SUCH THAT NO CABINET DOOR EXCEEDS 1'-6"
- ③ WALL OUTLET. COORDINATE WITH A00.10 & POWER PLANS.
- ④ SCHEDULED AV EQUIPMENT. PROVIDE BLOCKING FOR MOUNTING. COORDINATE POWER REQUIREMENTS WITH ELECTRICAL AND AV DRAWINGS.
- ⑤ COORDINATE SIZE OF OPENING WITH AV EQUIPMENT SPECIFICATION.
- ⑥ EXISTING ATM MACHINE TO REMAIN

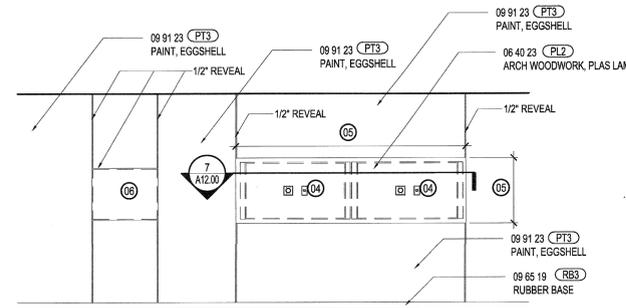


CAFETERIA MONITORS & ATM ELEVATION
SCALE: 3/8" = 1'-0"

6 BANQUETTE @ FULL WALL
SCALE: 1 1/2" = 1'-0" **2**

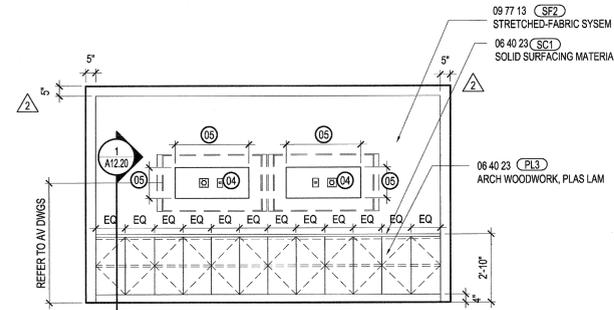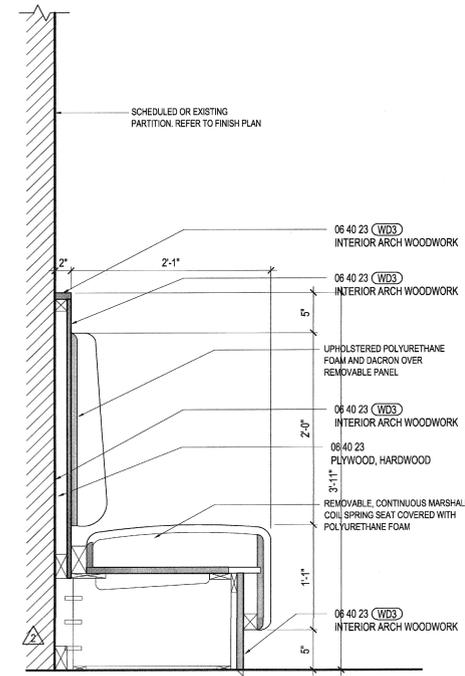


CAFETERIA MILLWORK ELEVATION
SCALE: 3/8" = 1'-0" **15**

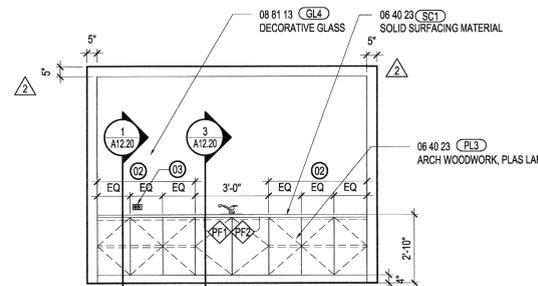


CAFETERIA MILLWORK ELEVATION
SCALE: 3/8" = 1'-0" **7**

7 NOT USED
SCALE: **3**

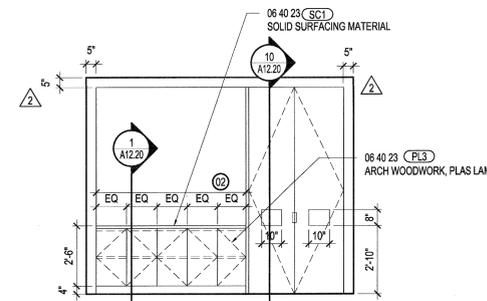

CAFETERIA MILLWORK ELEVATION
SCALE: 3/8" = 1'-0" **16**

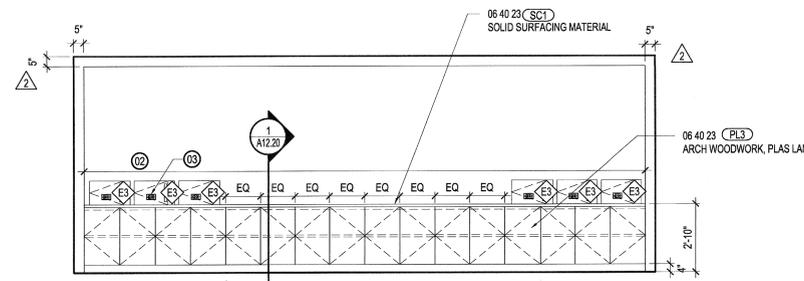

CAFETERIA MILLWORK ELEVATION
SCALE: 3/8" = 1'-0" **8**

8 NOT USED
SCALE: 3/8" = 1'-0" **4**

GENERAL NOTES

1. REMOVE EXISTING CEILING IN AREA OF WORK.
2. PATCH AND REPAIR ANY WALLS EXISTING TO REMAIN DAMAGED BY DEMOLITION.
3. ALL WALLS TO BE PT/FB/1 U.N.O.
4. NEW CEILING HEIGHT TO MATCH EXISTING.

Issue	Date & Issue Description	By	Check
01	07/31/12	ES/MC	SJ
Issued for Plan Check			
1	02 08/10/12	ES/MC	SJ
ISSUED FOR CONSTRUCTION			
2	03 08/12/12	ES/MC	SJ
BULLETIN #1			
3	04 10/05/12	ES/MC	SJ
REVISED FOR PLAN CHECK COMMENTS			

Scale/Signature



Project Name
VERIZON V.I.P.

Project Number
06.8740.000
CAD File Name

Description
CAFETERIA MILLWORK DETAILS


Scale
3/16" = 1'-0"

A12.25_SD




©2012 Gensler


P:\06\14\000\CAD\SHR\STAIRS\CAD\12\25\A12.25_SD.dwg, 04/11/12, 04/11/12, 5:08PM

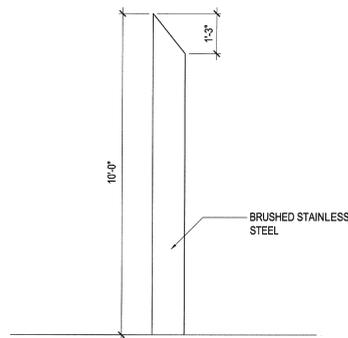


SIGNAGE MONUMENT SIDE ELEV. 5
SCALE: 1/2" = 1'-0"

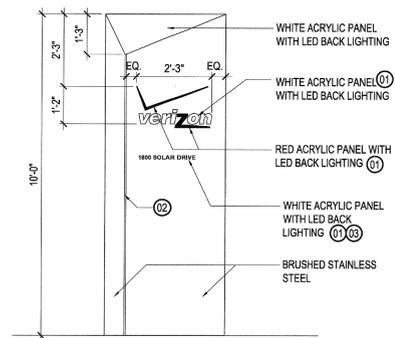

SIGNAGE MONUMENT FRONT ELEV. 1
SCALE: 1/2" = 1'-0"

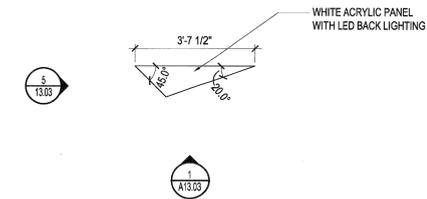

SIGNAGE MONUMENT PLAN 2
SCALE: 1/2" = 1'-0"

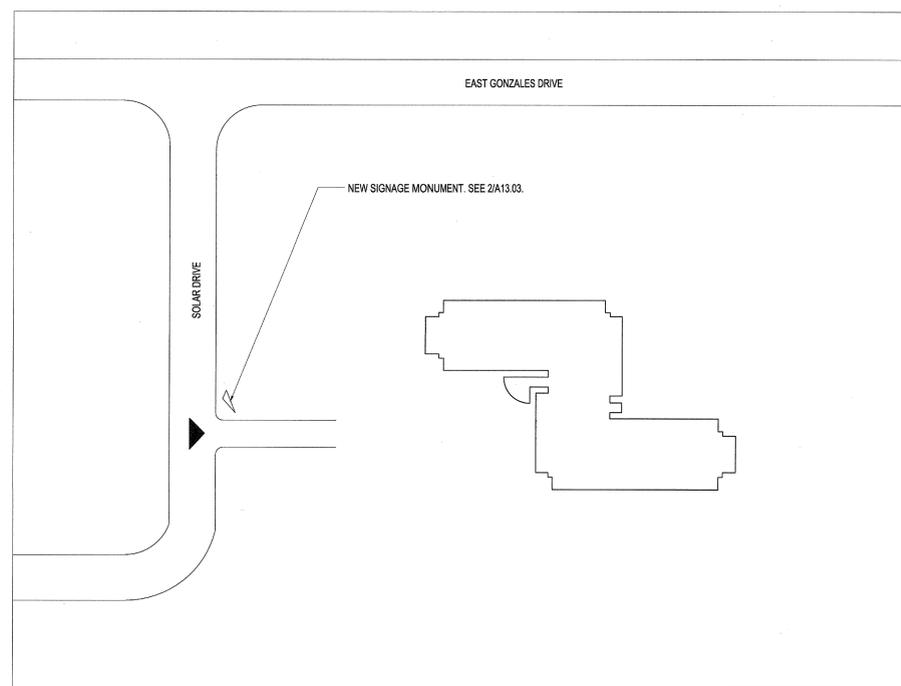

SIGNAGE MONUMENT LOCATION KEY PLAN 4
SCALE: NTS

SHEET NOTES

- ① BRUSHED STAINLESS STEEL CLADDING TO BE LAZER CUT WITH VERIZON LOGO. BACK-LIT ACRYLIC TO BE MOUNTED ADJACENT TO INTERIOR FACE OF BRUSHED STAINLESS STEEL CLADDING.
- ② PROVIDE 1/2" STAINLESS STEEL VERTICAL "U" CHANNEL REVEAL AT PANEL SEAM FOR RAINWATER COLLECTION
- ③ BUILDING ADDRESS IN THIS LOCATION. COORDINATE WITH ARCHITECT/OWNER.



1800 Solar Drive
Oxnard, CA 93030

1230 Avenue of the Americas
Suite 1500
New York, NY 10020
Telephone: 212.492.1400
Facsimile: 212.492.1472

Gensler



SYSKA HENNESSY GROUP
A member company of SH Group, Inc.

Syska Hennessy Group, Inc.
800 Corporate Pointe
Suite 200
Culver City, CA 90230
Telephone: 310.312.0200
Fax: 310.473.7468

Issue	Date & Issue Description	By	Check
01	07/31/12 Issued for Plan Check	ESMC	SJ
1	08/10/12 ISSUED FOR CONSTRUCTION	ESMC	SJ

GENERAL NOTES


1. DRAWINGS FOR DESIGN INTENT AND LOCATION ONLY. SIGNAGE VENDOR TO PREPARE FABRICATION SHOP DRAWINGS FOR REVIEW BY ARCHITECT.
2. PROVIDE APPROPRIATE DRAINAGE SLOPES FOR SHEDDING RAINWATER AND FOUNTAIN.
3. PROVIDE MOUNTING DETAILS.
4. FINAL LOCATION OF MONUMENT TO BE APPROVED BY ARCHITECT AND OWNER.

Scale/Signature



Project Name
VERIZON V.I.P.

Project Number
06.8740.000
CAD File Name
A12-00
Description
EXTERIOR SIGNAGE MONUMENT

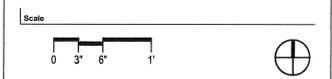

A13.03_SD

©2012 Gensler