

STRUCTURAL STEEL

1. ALL STRUCTURAL STEEL SHALL CONFORM TO THE ASTM DESIGNATION AS INDICATED BELOW (UNO):

WF SHAPES, EXCEPT MOMENT FRAME GIRDERS:	A572, GRADE 50
MOMENT FRAME GIRDERS, PLATES U.N.O., CONNECTION PLATES, AND MISC.	A-36
PIPE COLUMNS	A-53, GRADE B
TUBE SECTIONS	A-500, GRADE B
BOLTS	A-325
BOLTS IN CONCRETE/MASONRY	A-307
ANGLES, CHANNELS, WT SHAPES	A-36*

2. BOLT HOLES USED IN STEEL SHALL BE $\frac{1}{16}$ " LARGER IN DIAMETER THAN NOMINAL SIZE OF BOLT USED, EXCEPT AS NOTED.
3. ALL WELDING IS TO BE DONE BY CERTIFIED WELDERS USING E70XX ELECTRODES (UNO). ALL WELDS SHALL BE IN CONFORMITY WITH THE PROJECT SPECIFICATIONS AND THE CODE FOR WELDING IN BUILDING CONSTRUCTION (AWS D1.1 LATEST REVISION) OF THE AMERICAN WELDING SOCIETY. SEE SPECIAL INSPECTIONS SECTION FOR WELDING INSPECTION REQUIREMENTS.
4. WELD LENGTHS CALLED FOR ON PLANS ARE THE NET EFFECTIVE LENGTH REQUIRED. WHERE FILLET WELD SYMBOL IS GIVEN WITHOUT INDICATION OF SIZE, USE MINIMUM SIZE WELDS AS SPECIFIED IN AISC MANUAL OF STEEL CONSTRUCTION 9TH EDITION, SECTION 1.17.2.

GENERAL

1. THE CONTRACTOR SHALL VERIFY ALL DIMENSIONS PRIOR TO STARTING CONSTRUCTION. THE ARCHITECT SHALL BE NOTIFIED OF ANY DISCREPANCIES OR INCONSISTENCIES.
2. ALL DRAWINGS ARE CONSIDERED TO BE A PART OF THE CONTRACT DOCUMENTS. THE CONTRACTOR SHALL BE RESPONSIBLE FOR THE REVIEW AND COORDINATION OF ALL DRAWINGS AND SPECIFICATIONS PRIOR TO THE START OF CONSTRUCTION. ANY DISCREPANCIES THAT OCCUR SHALL BE BROUGHT TO THE ATTENTION OF THE ARCHITECT PRIOR TO START OF CONSTRUCTION SO THAT A CLARIFICATION CAN BE ISSUED. ANY WORK PERFORMED IN CONFLICT WITH THE CONTRACT DOCUMENTS OR ANY CODE REQUIREMENTS SHALL BE CORRECTED BY THE CONTRACTOR AT THEIR OWN EXPENSE AND AT NO EXPENSE TO THE OWNER OR ARCHITECT.
3. NOTES AND DETAILS ON DRAWINGS SHALL TAKE PRECEDENCE OVER GENERAL NOTES AND TYPICAL DETAILS. WHERE NO DETAILS ARE GIVEN, CONSTRUCTION SHALL BE AS SHOWN FOR SIMILAR WORK.
4. ALL WORK SHALL CONFORM TO THE MINIMUM STANDARDS OF THE FOLLOWING CODES:
- 2010 CALIFORNIA BUILDING CODE REFERRED TO HERE AS "THE CODE" AND ANY OTHER REGULATING AGENCIES WHICH HAVE AUTHORITY OVER ANY PORTION OF THE WORK, INCLUDING THE STATE OF CALIFORNIA DIVISION OF INDUSTRIAL SAFETY, AND THOSE CODES & STANDARDS LISTED IN THESE NOTES AND SPECIFICATIONS.
5. SEE ARCHITECTURAL DRAWINGS FOR THE FOLLOWING:
- SIZE AND LOCATION OF ALL DOOR AND WINDOW OPENINGS, EXCEPT AS NOTED
- SIZE AND LOCATION OF ALL INTERIOR AND EXTERIOR NON-BEARING PARTITIONS NOT INDICATED ON OUR DRAWINGS. IF SHOWN ON OUR DRAWING SIZES ARE TO BE VERIFIED W/ ARCHITECTURAL DRAWINGS. ANY CONFLICT IS TO BE BROUGHT TO THE ATTENTION OF THE ARCHITECT AND ENGINEER.
- FLOOR AND ROOF FINISHES
- MISCELLANEOUS DRAINAGE AND WATERPROOFING
- DIMENSIONS NOT SHOWN ON STRUCTURAL DRAWINGS
6. SEE MECHANICAL, PLUMBING AND ELECTRICAL DRAWINGS FOR THE FOLLOWING:
- ELECTRICAL CONDUIT RUNS, BOXES, OUTLETS IN WALLS AND SLABS
- SIZE AND LOCATION OF MACHINE OR EQUIPMENT BASES, ANCHOR BOLTS FOR MOTOR MOUNTS
7. THE CONTRACT STRUCTURAL DRAWINGS AND SPECIFICATIONS REPRESENT THE FINISHED STRUCTURE. THEY DO NOT INDICATE THE METHOD OF CONSTRUCTION. THE CONTRACTOR SHALL PROVIDE ALL MEASURES NECESSARY TO PROTECT THE STRUCTURE DURING CONSTRUCTION. SUCH MEASURES SHALL INCLUDE, BUT NOT BE LIMITED TO, BRACING, SHORING FOR LOADS DUE TO CONSTRUCTION EQUIPMENT, ETC. CONTRACTOR SHALL BE RESPONSIBLE FOR DESIGN, CONSTRUCTIONS, INSPECTION AND APPROVALS OF ALL SUCH SHORINGS. OBSERVATION VISITS TO THE SITE BY THE STRUCTURAL ENGINEER SHALL NOT INCLUDE INSPECTION OF THE ABOVE ITEMS.
8. THE CONTRACT STRUCTURAL DRAWINGS SHOW THE BUILDING IN ITS FINAL INTENDED POSITION. CONTRACTOR SHALL MAKE PROVISIONS IN THE LAYOUT OF THE BUILDING TO TAKE INTO ACCOUNTS SHRINKAGE, CREEP, SHORTENING, ETC.
9. ASTM SPECIFICATIONS ON THE DRAWINGS SHALL BE OF THE LATEST REVISIONS.
10. CONSTRUCTION MATERIAL SHALL BE SPREAD OUT IF PLACED ON FRAMED ROOF OR FLOOR. LOAD SHALL NOT EXCEED THE DESIGN LIVE LOAD PER SQUARE FOOT. PROVIDE ADEQUATE SHORING AND/OR BRACING WHERE STRUCTURE HAS NOT ATTAINED DESIGN STRENGTH.

SPECIAL INSPECTIONS

1. ALL SPECIAL INSPECTIONS SHALL BE PERFORMED IN ACCORDANCE WITH THE REQUIREMENTS OF SECTION 1704 OF THE CODE AND ANY ADDITIONAL REQUIREMENTS STATED IN THESE DRAWINGS AND/OR THE PROJECT SPECIFICATIONS.
2. THE FOLLOWING ELEMENTS OF CONSTRUCTION SHALL HAVE PERIODIC INSPECTION BY A BUILDING INSPECTOR APPROVED BY BUILDING DEPARTMENT.
- d) STRUCTURAL STEEL SINGLE-PASS FILLET WELDS < 5/16"

DESIGN LOADS


1. EARTHQUAKE LOADS ON PRIMARY STRUCTURE:
- EARTHQUAKE LOADS ARE IN ACCORDANCE WITH SECTION 1613 OF THE CODE.
2. EARTHQUAKE LOADS ON NONSTRUCTURAL COMPONENTS:
- EARTHQUAKE LOADS ARE IN ACCORDANCE WITH SECTION 1613 OF THE CODE.
- $I_p = 1.0$ FOR ALL NONSTRUCTURAL COMPONENTS
- EARTHQUAKE LOADS ON NONSTRUCTURAL COMPONENTS ARE DETERMINED PER ASCE 7-05, EQUATION 13.3-1.
- THE MAXIMUM AND MINIMUM VALUES FOR F_p SHALL BE DETERMINED FROM ASCE 7-05 EQUATIONS 13.3-2 AND 13.3-3, RESPECTIVELY.
- ALL EARTHQUAKE LOADS ON NONSTRUCTURAL COMPONENTS SHALL BE BASED ON THE VALUES OF q_p AND R_p FROM ASCE 7-05 TABLES 13.5-1 AND 13.6-1.
- OCCUPANCY CATEGORY: II
- MAPPED SPECTRAL RESPONSE ACCELERATIONS:
- $S_s = 2.658$
 $S_1 = 0.973$
- SITE CLASS: D
- SPECTRAL RESPONSE COEFFICIENTS:
- $S_{DS} = 1.722$
 $S_1 = 0.973$
- SEISMIC DESIGN CATEGORY: D
3. FLOOD DESIGN DATA:
- THE PROJECT IS NOT LOCATED WITHIN A FLOOD HAZARD AREA.

VERIZON OXNARD

1800 SOLAR DRIVE
OXNARD, CA 93030

11/01/13

kpff Consulting Engineers
6080 Center Drive, Suite 300
Los Angeles, California 90045
(310) 665-1536 Fax (310) 665-9070

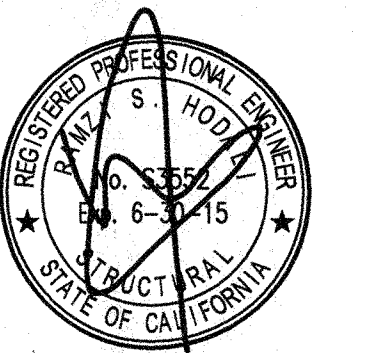

KEYPLAN

Owner

APPROVED
CITY OF OXNARD
PLANNING
11/1/13

REVISIONS		
NO.	DESCRIPTION	DATE


DRAWING TITLE
GENERAL NOTES

REVIEWED	SCALE
DRAWN	NOTED
ISSUE DATE	
JOB NO.	
DRAWING NO.	

APPROVED
BY: [Signature]
DATE: 11/1/13
CITY OF OXNARD
PLANNING

APPROVED
S. Newman
11/1/13


S-1

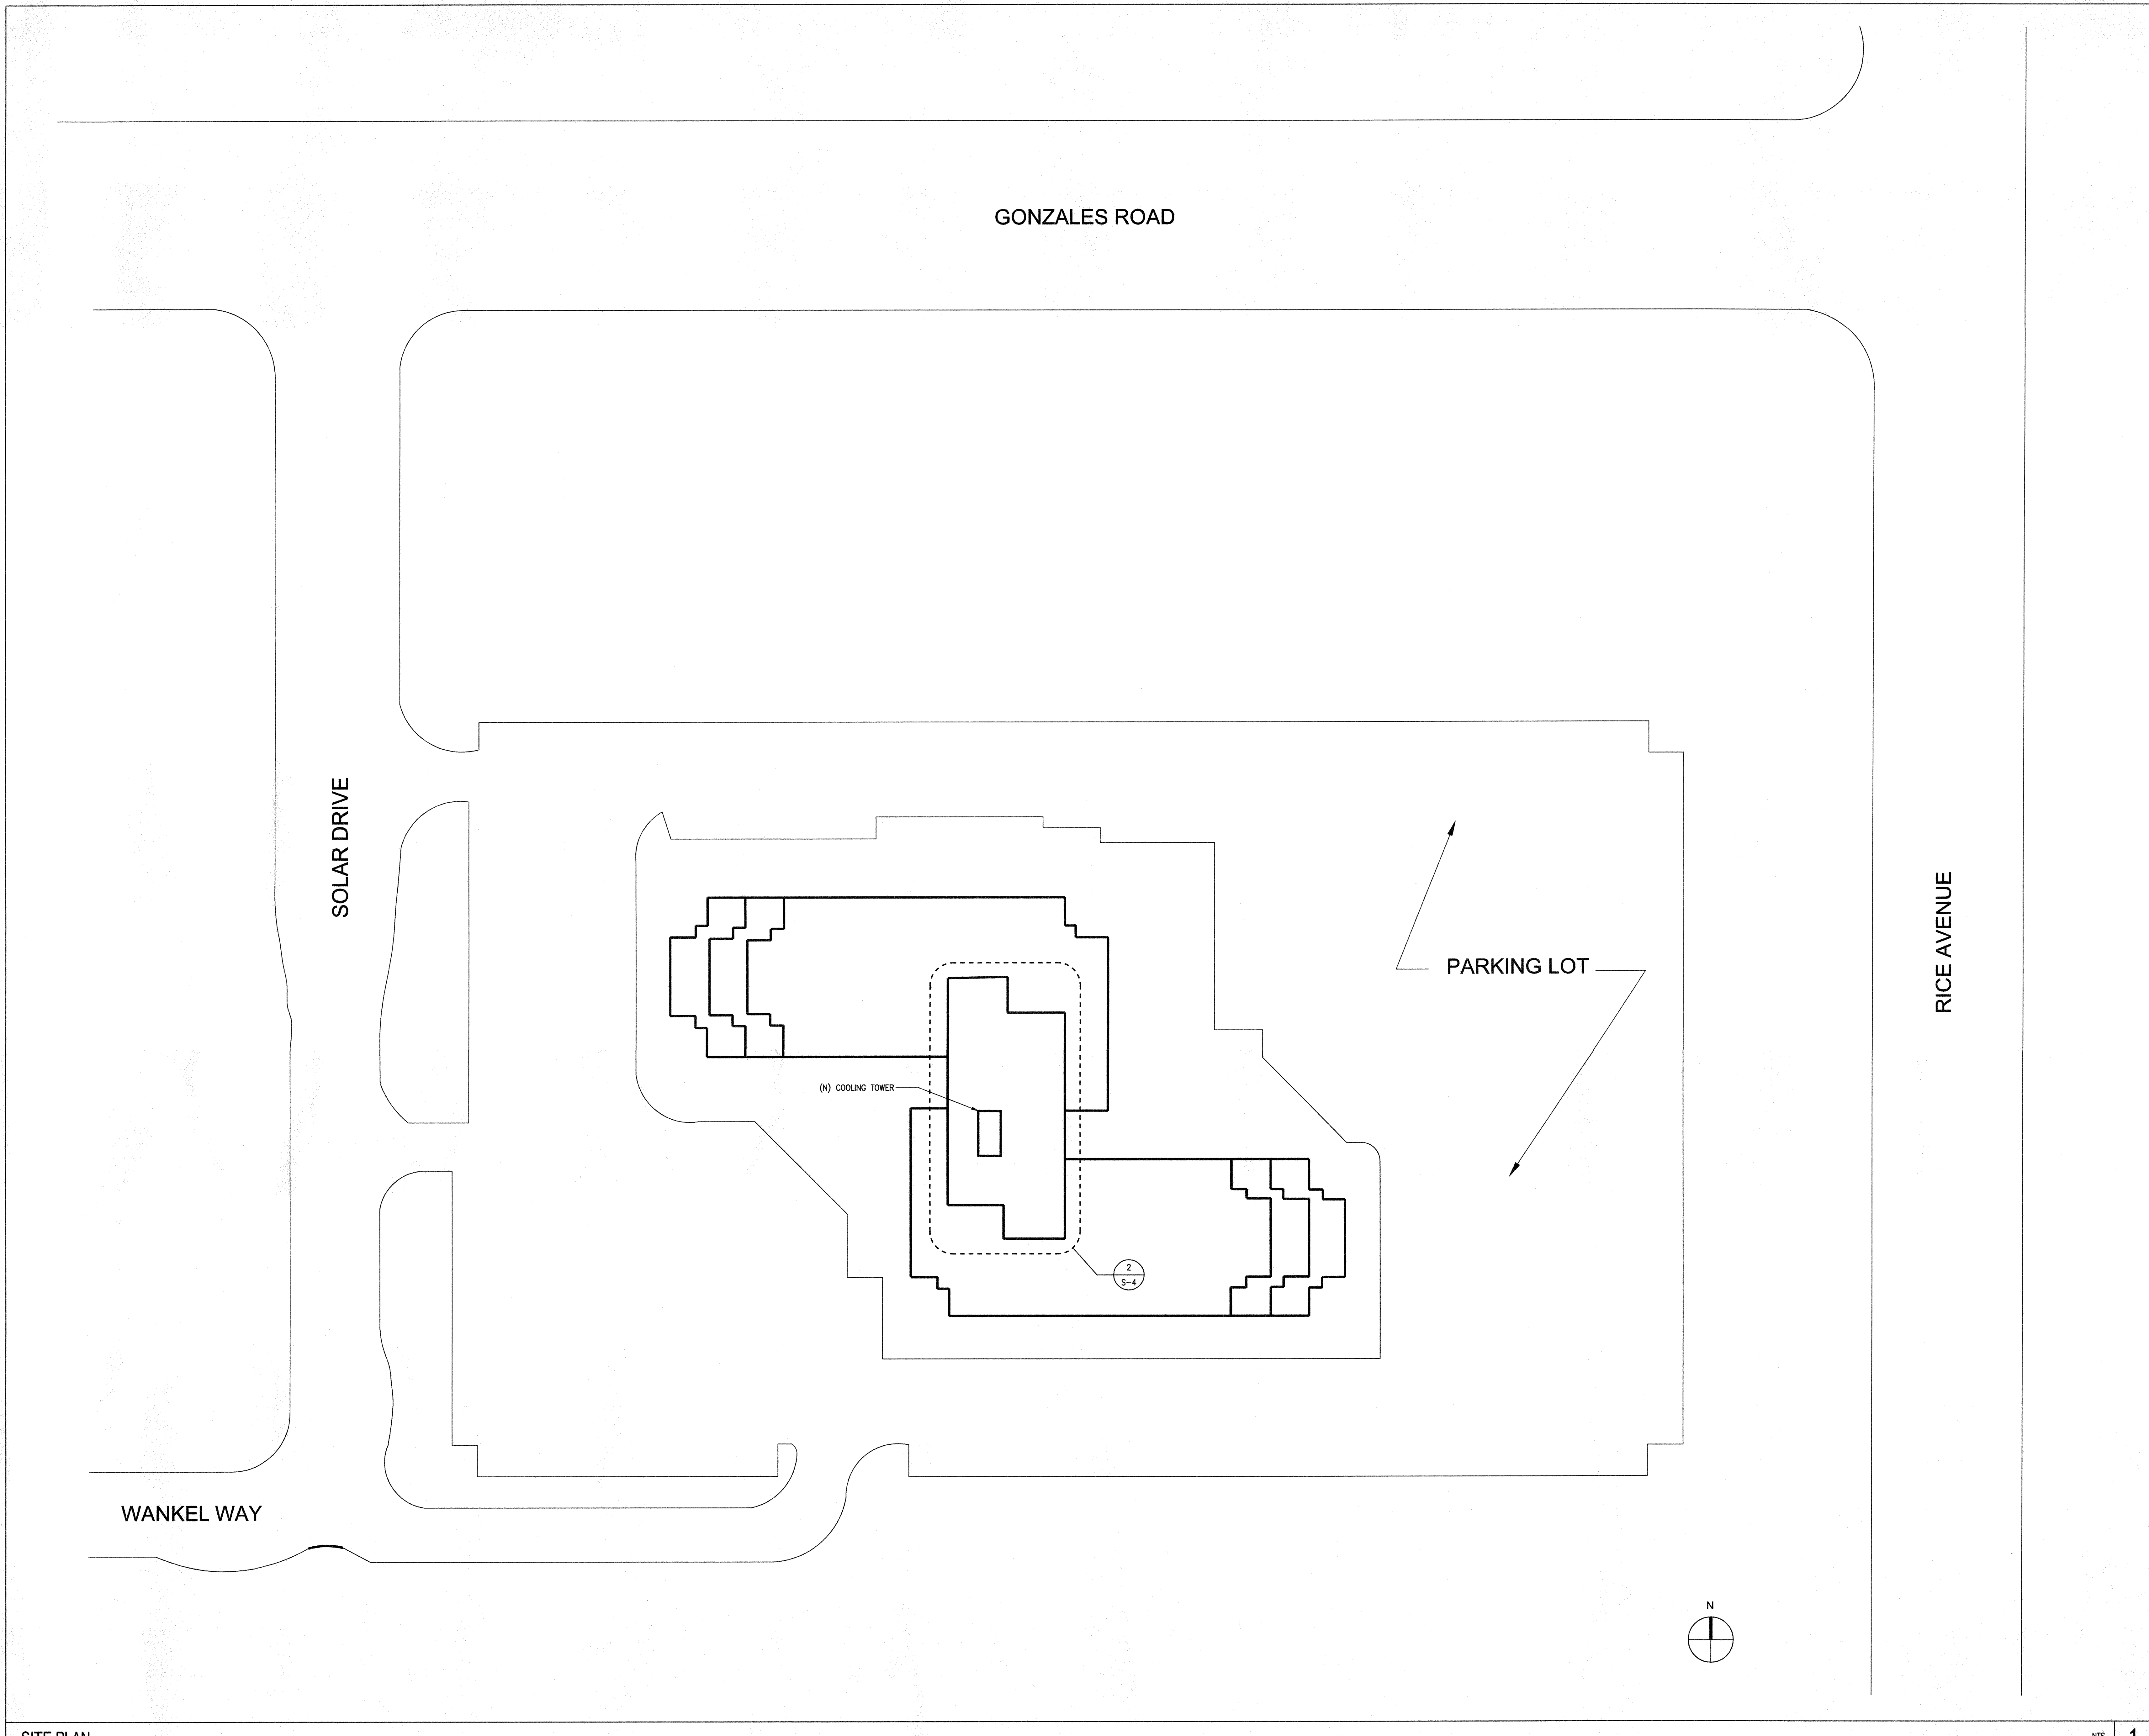

VERIZON OXNARD

1800 SOLAR DRIVE
OXNARD, CA 93030

k p f f Consulting Engineers
6080 Center Drive, Suite 300
Los Angeles, California 90045
(310) 665-1536 Fax (310) 665-9070

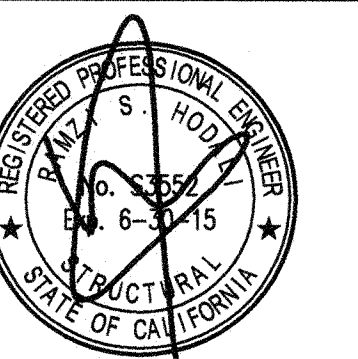

KEYPLAN


APPROVED
PERMIT CENTER
CITY OF OXNARD
THIS SET OF PLANS AND SPECIFICATIONS HAS BEEN REVIEWED FOR CONFORMANCE WITH THE CITY ORDINANCES AND THE OXNARD CITY ENGINEERING DEPARTMENT HAS ISSUED THIS PERMIT UNDER THE ASSUMPTION THAT THE APPLICANT HAS PROVIDED ALL NECESSARY INFORMATION AND THAT THE APPLICANT SHALL BE RESPONSIBLE FOR THE OBTAINMENT OF ALL NECESSARY PERMITS FROM THE LOCAL AGENCIES.

REVISIONS		
NO.	DESCRIPTION	DATE


DRAWING TITLE
SITE PLAN

REVIEWED -
DRAWN -
ISSUE DATE
JOB NO. -
SCALE: AS NOTED

DRAWING NO.
S-2

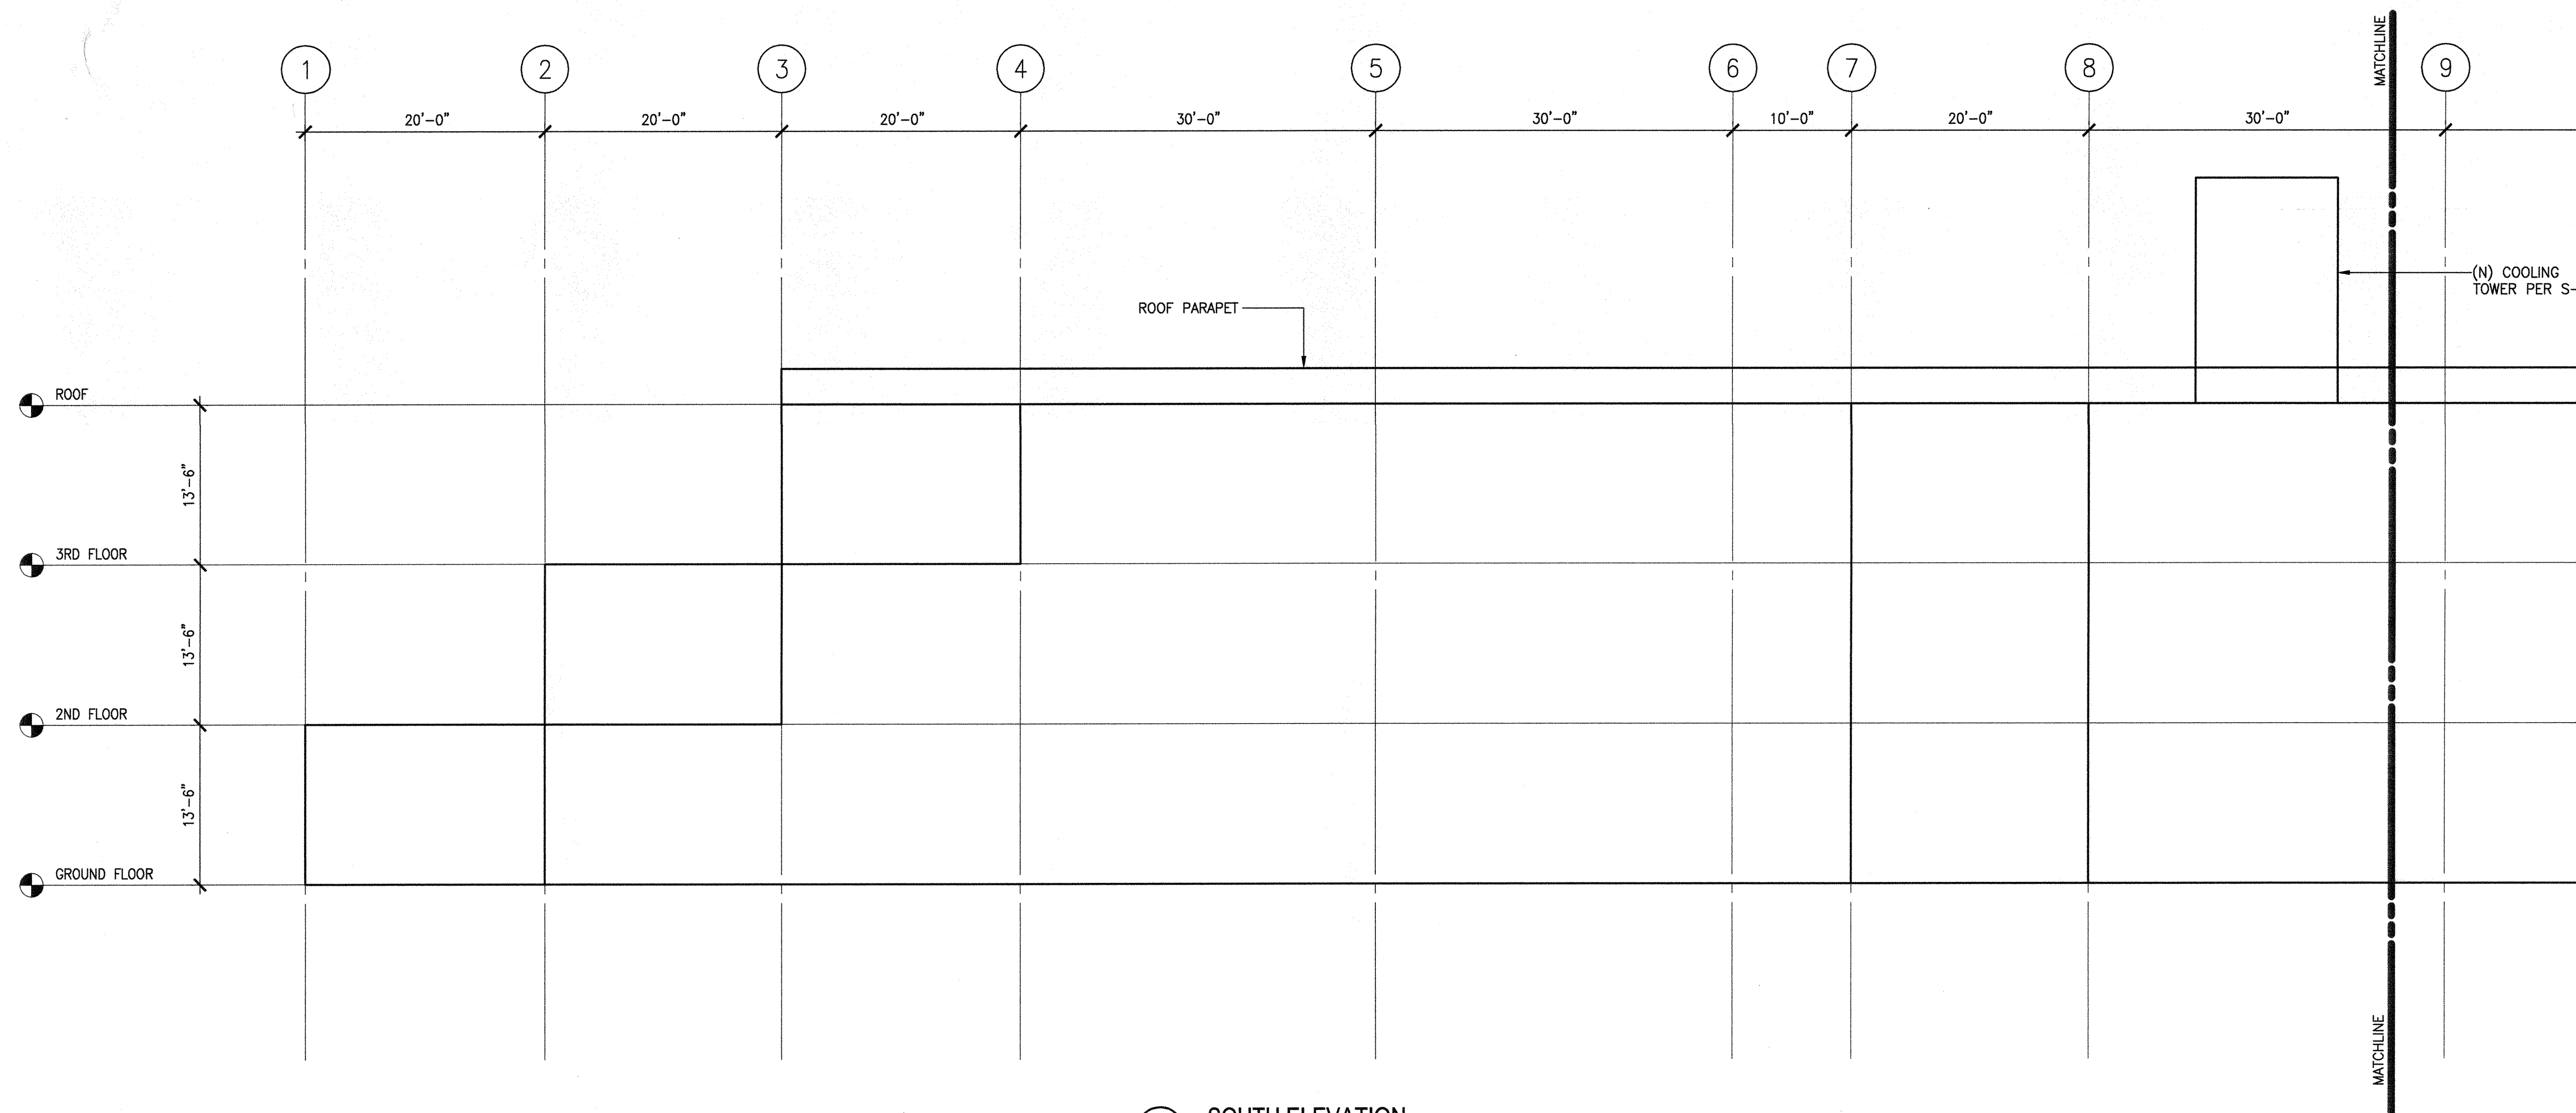


A SOUTH ELEVATION
SCALE: 1/8"=1'-0"

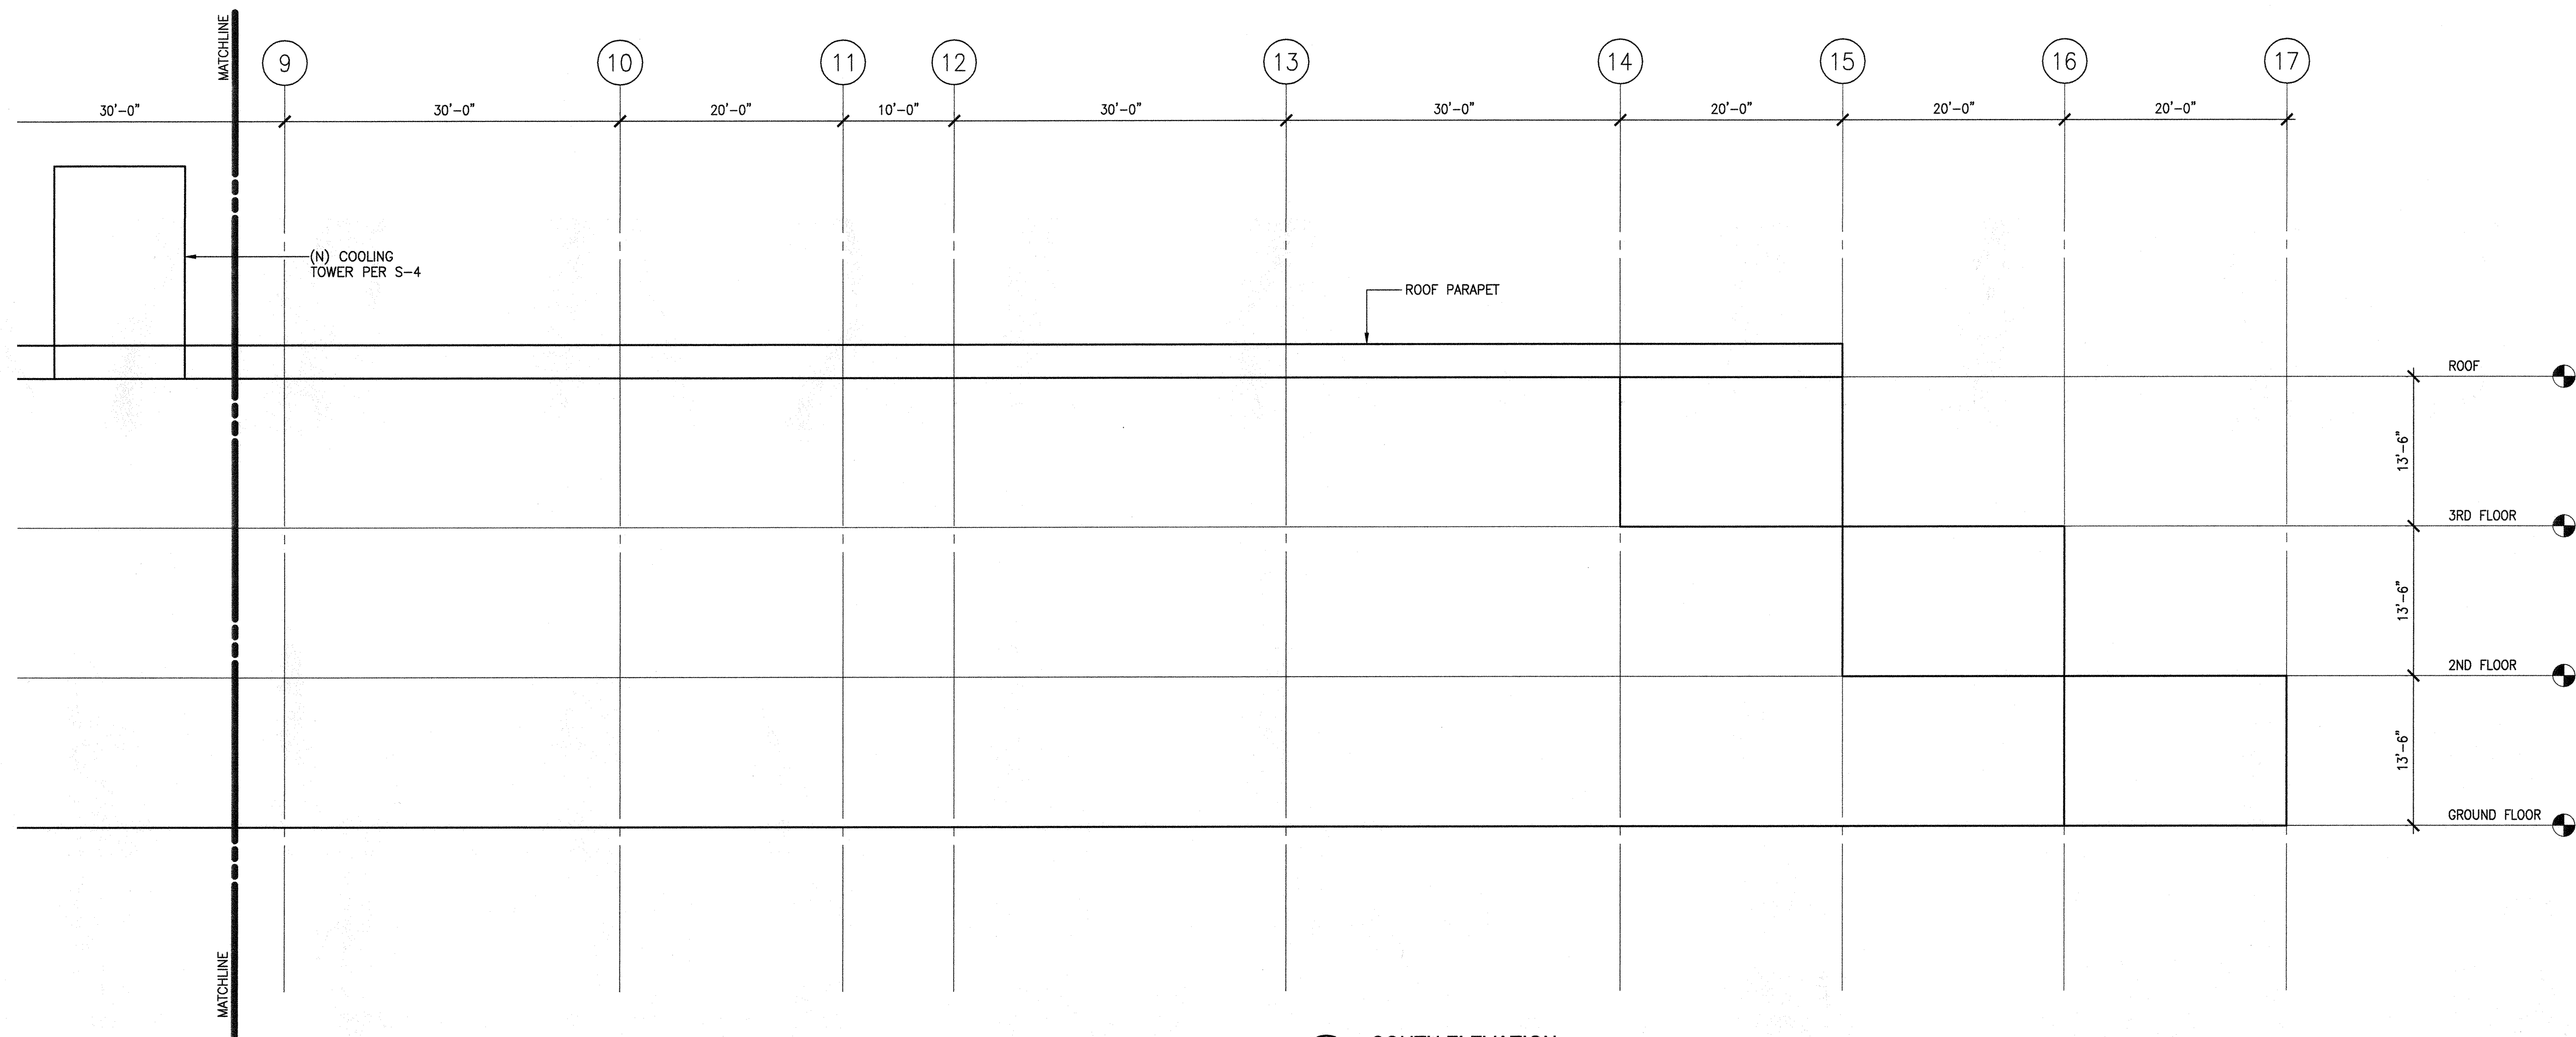

B SOUTH ELEVATION
SCALE: 1/8"=1'-0"

VERIZON OXNARD
1800 SOLAR DRIVE
OXNARD, CA 93030

k p f i Consulting Engineers
6080 Center Drive, Suite 300
Los Angeles, California 90045
(310) 665-1536 Fax (310) 665-9070

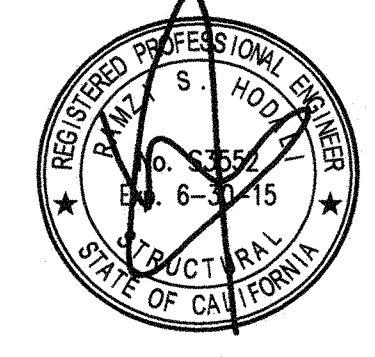


KEYPLAN

APPROVED
PERMIT CENTER
CITY OF OXNARD
THIS SET OF PLANS AND SPECIFICATIONS SHALL BE KEPT ON THE JOB SITE AT ALL TIMES AND IN FULL COMPLIANCE WITH THE CITY OF OXNARD PERMITS DEPARTMENT. THE PERMITS DEPARTMENT SHALL BE NOTIFIED IMMEDIATELY IN WRITING OF ANY CHANGES TO THE PLANS OR SPECIFICATIONS. APPROVAL OF THIS PROJECT IS NOT A GUARANTEE OF ANY KIND.


REVISIONS		
NO.	DESCRIPTION	DATE

DRAWING TITLE
ELEVATIONS

REVIEWED -
DRAWN -
ISSUE DATE
JOB NO. -
SCALE: AS NOTED
DRAWING NO.

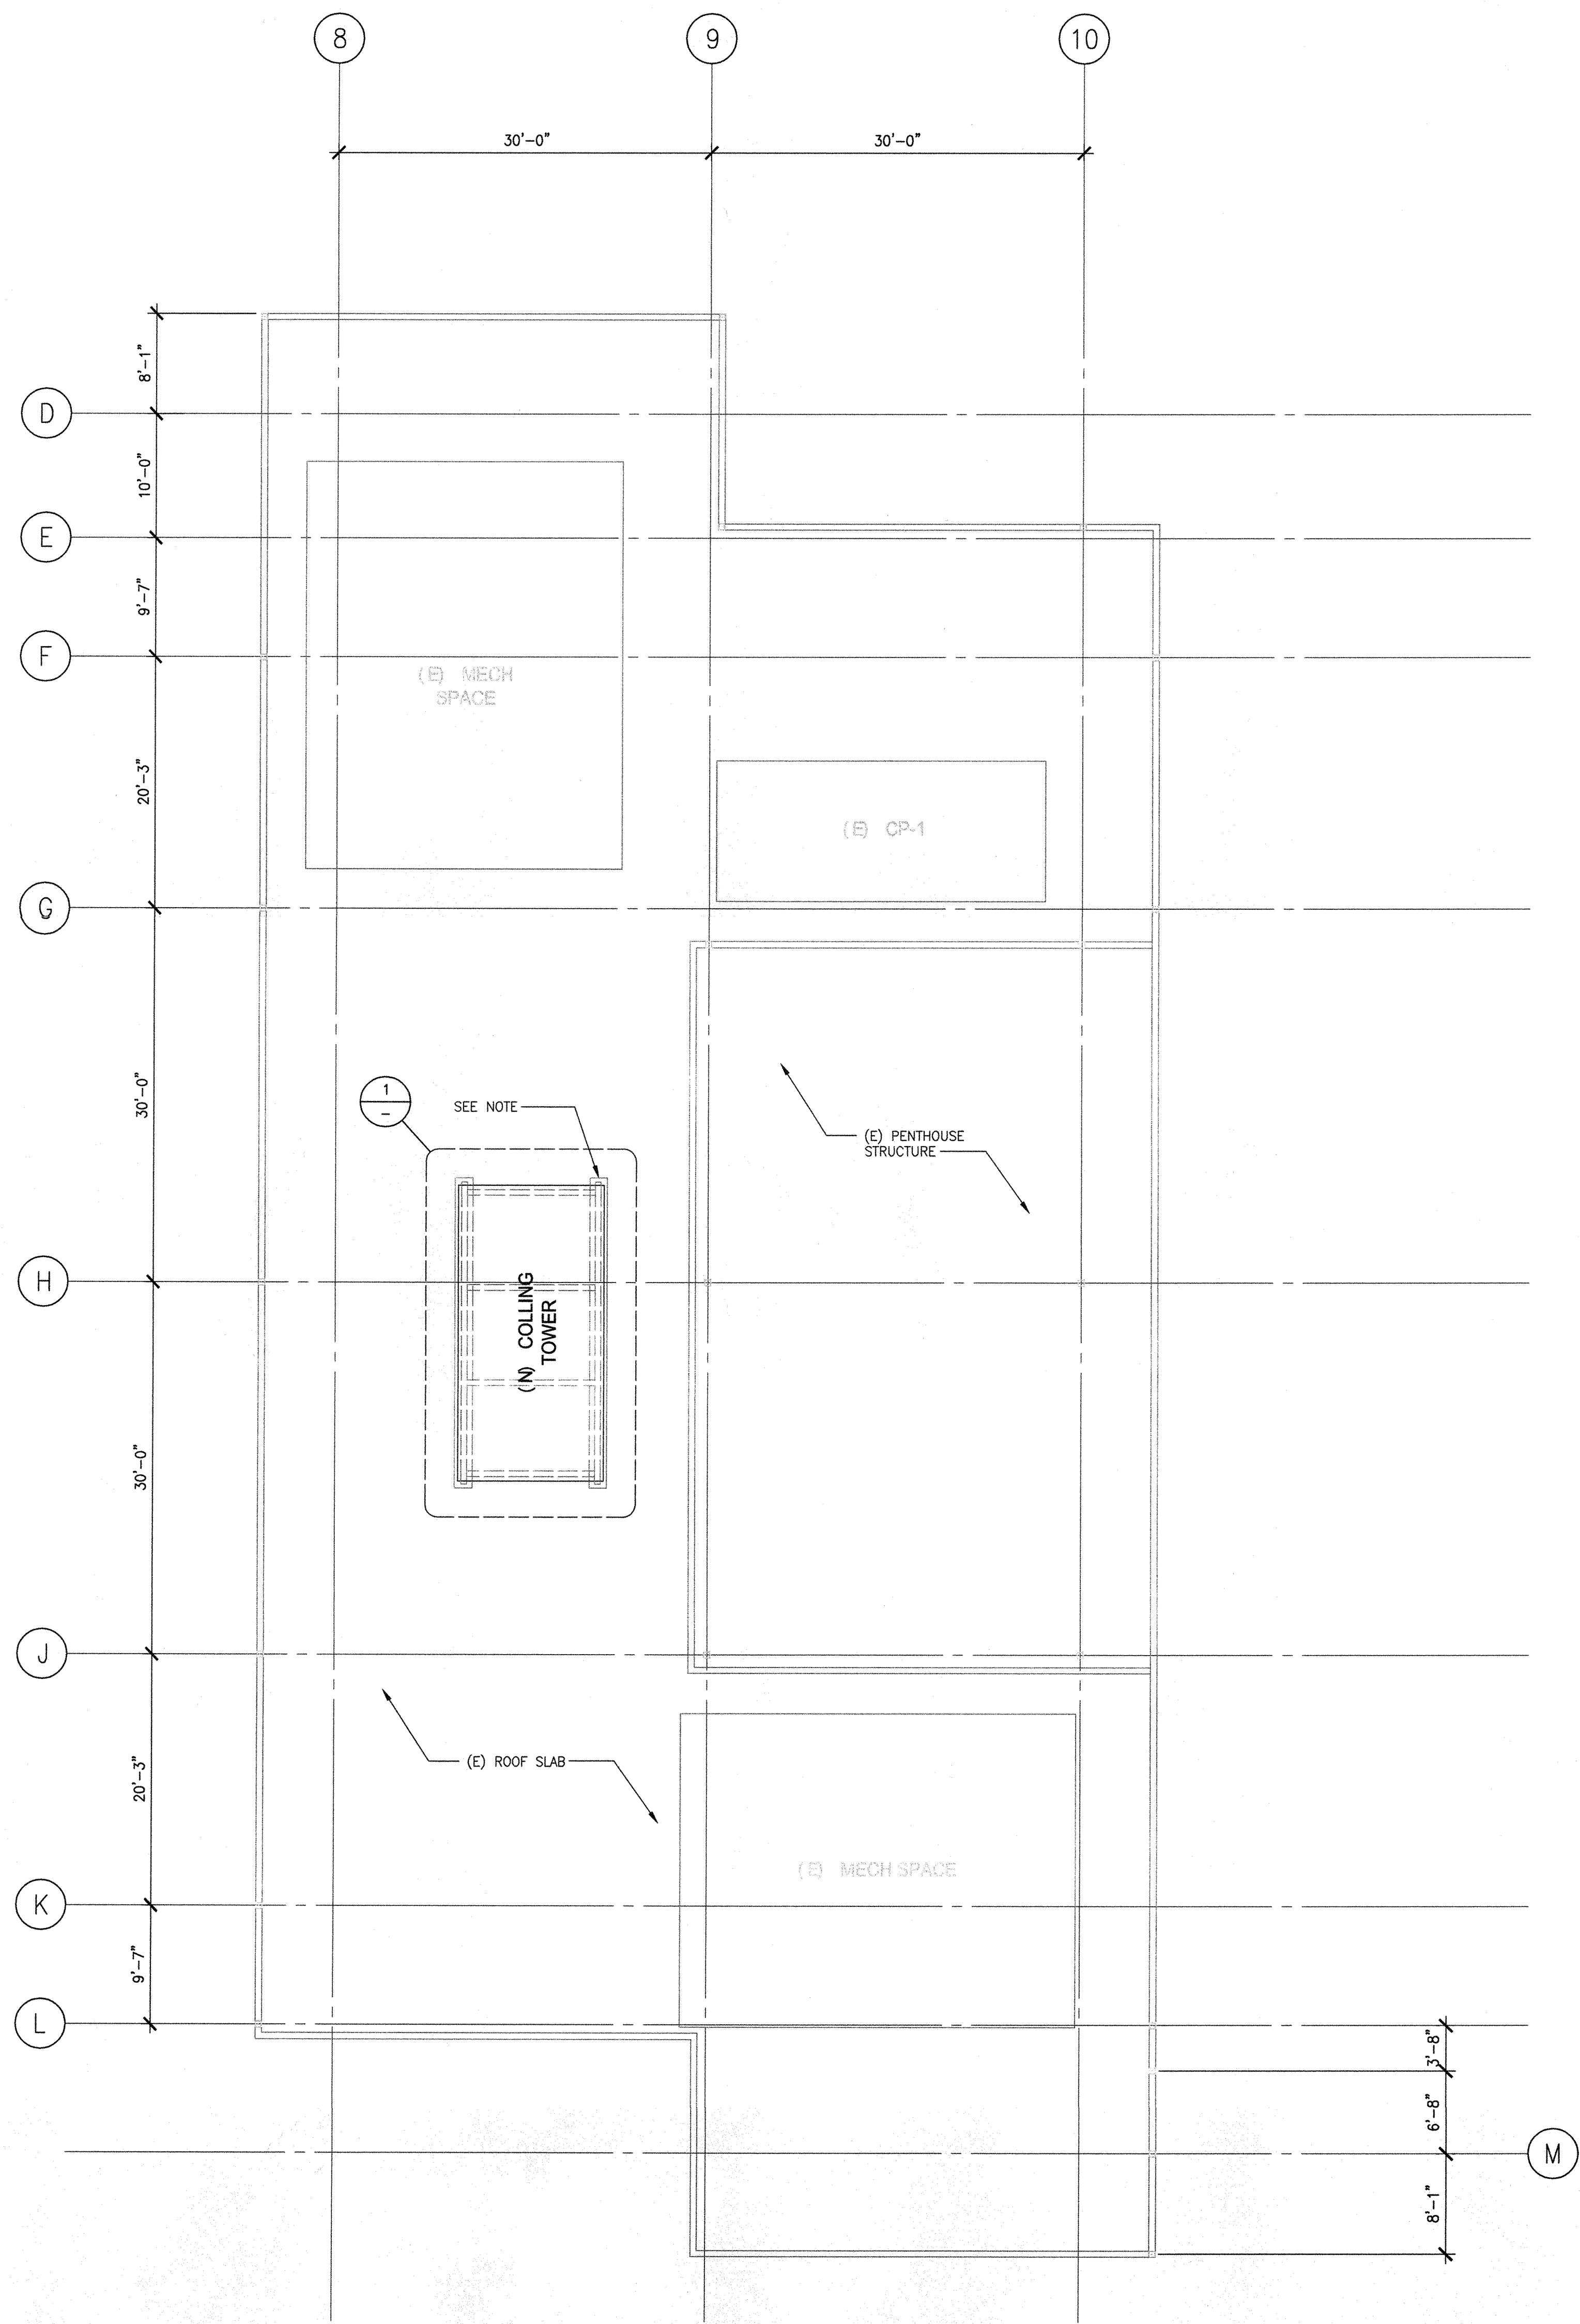


NOTE:
 (N) COOLING TOWER (WT=32,150#) LOCATED ON (E) WF BEAMS. ISOLATORS, CONC CURB THAT PREVIOUSLY SUPPORTED A 40,000# COOLING TOWER AT THE SAME LOCATION.

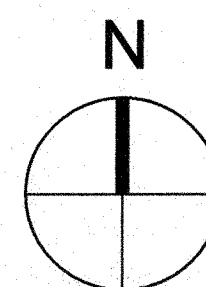

PARTIAL ROOF PLAN


1/8"=1'-0" 2

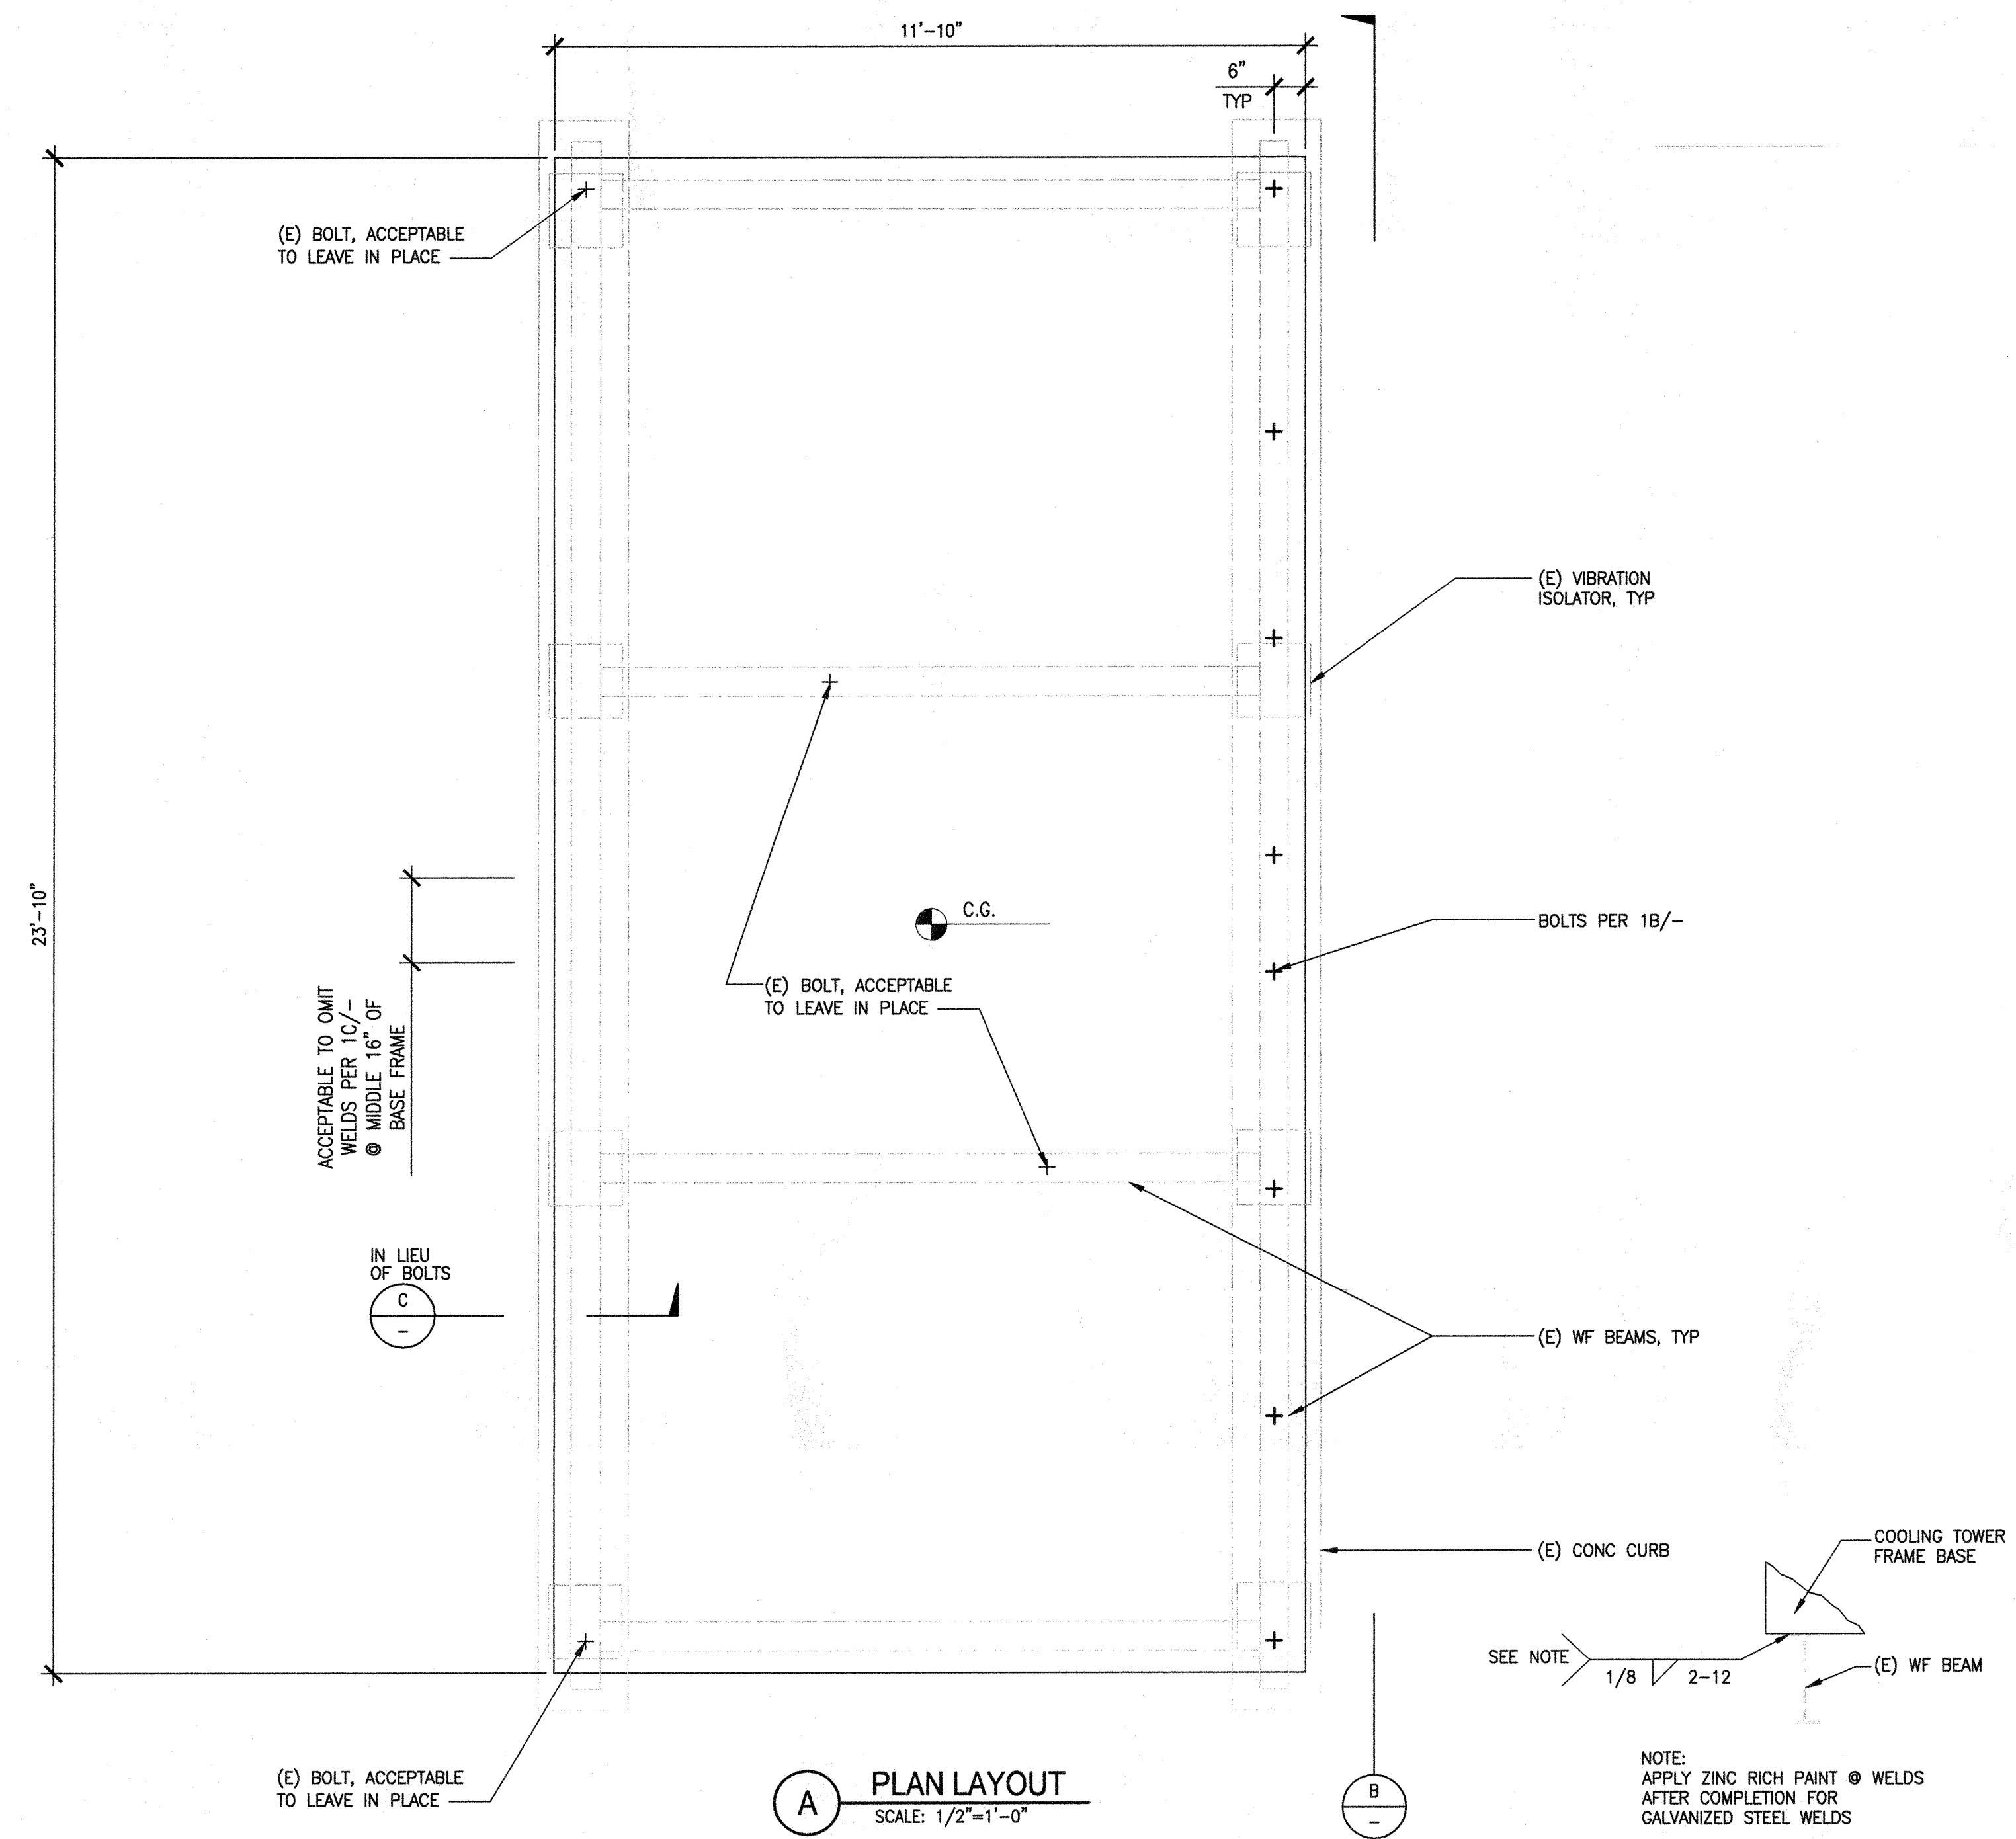

A PLAN LAYOUT
 SCALE: 1/2"=1'-0"

C WELD DETAIL
 SCALE: 1/2"=1'-0"

NOTE:
 APPLY ZINC RICH PAINT @ WELDS AFTER COMPLETION FOR GALVANIZED STEEL WELDS

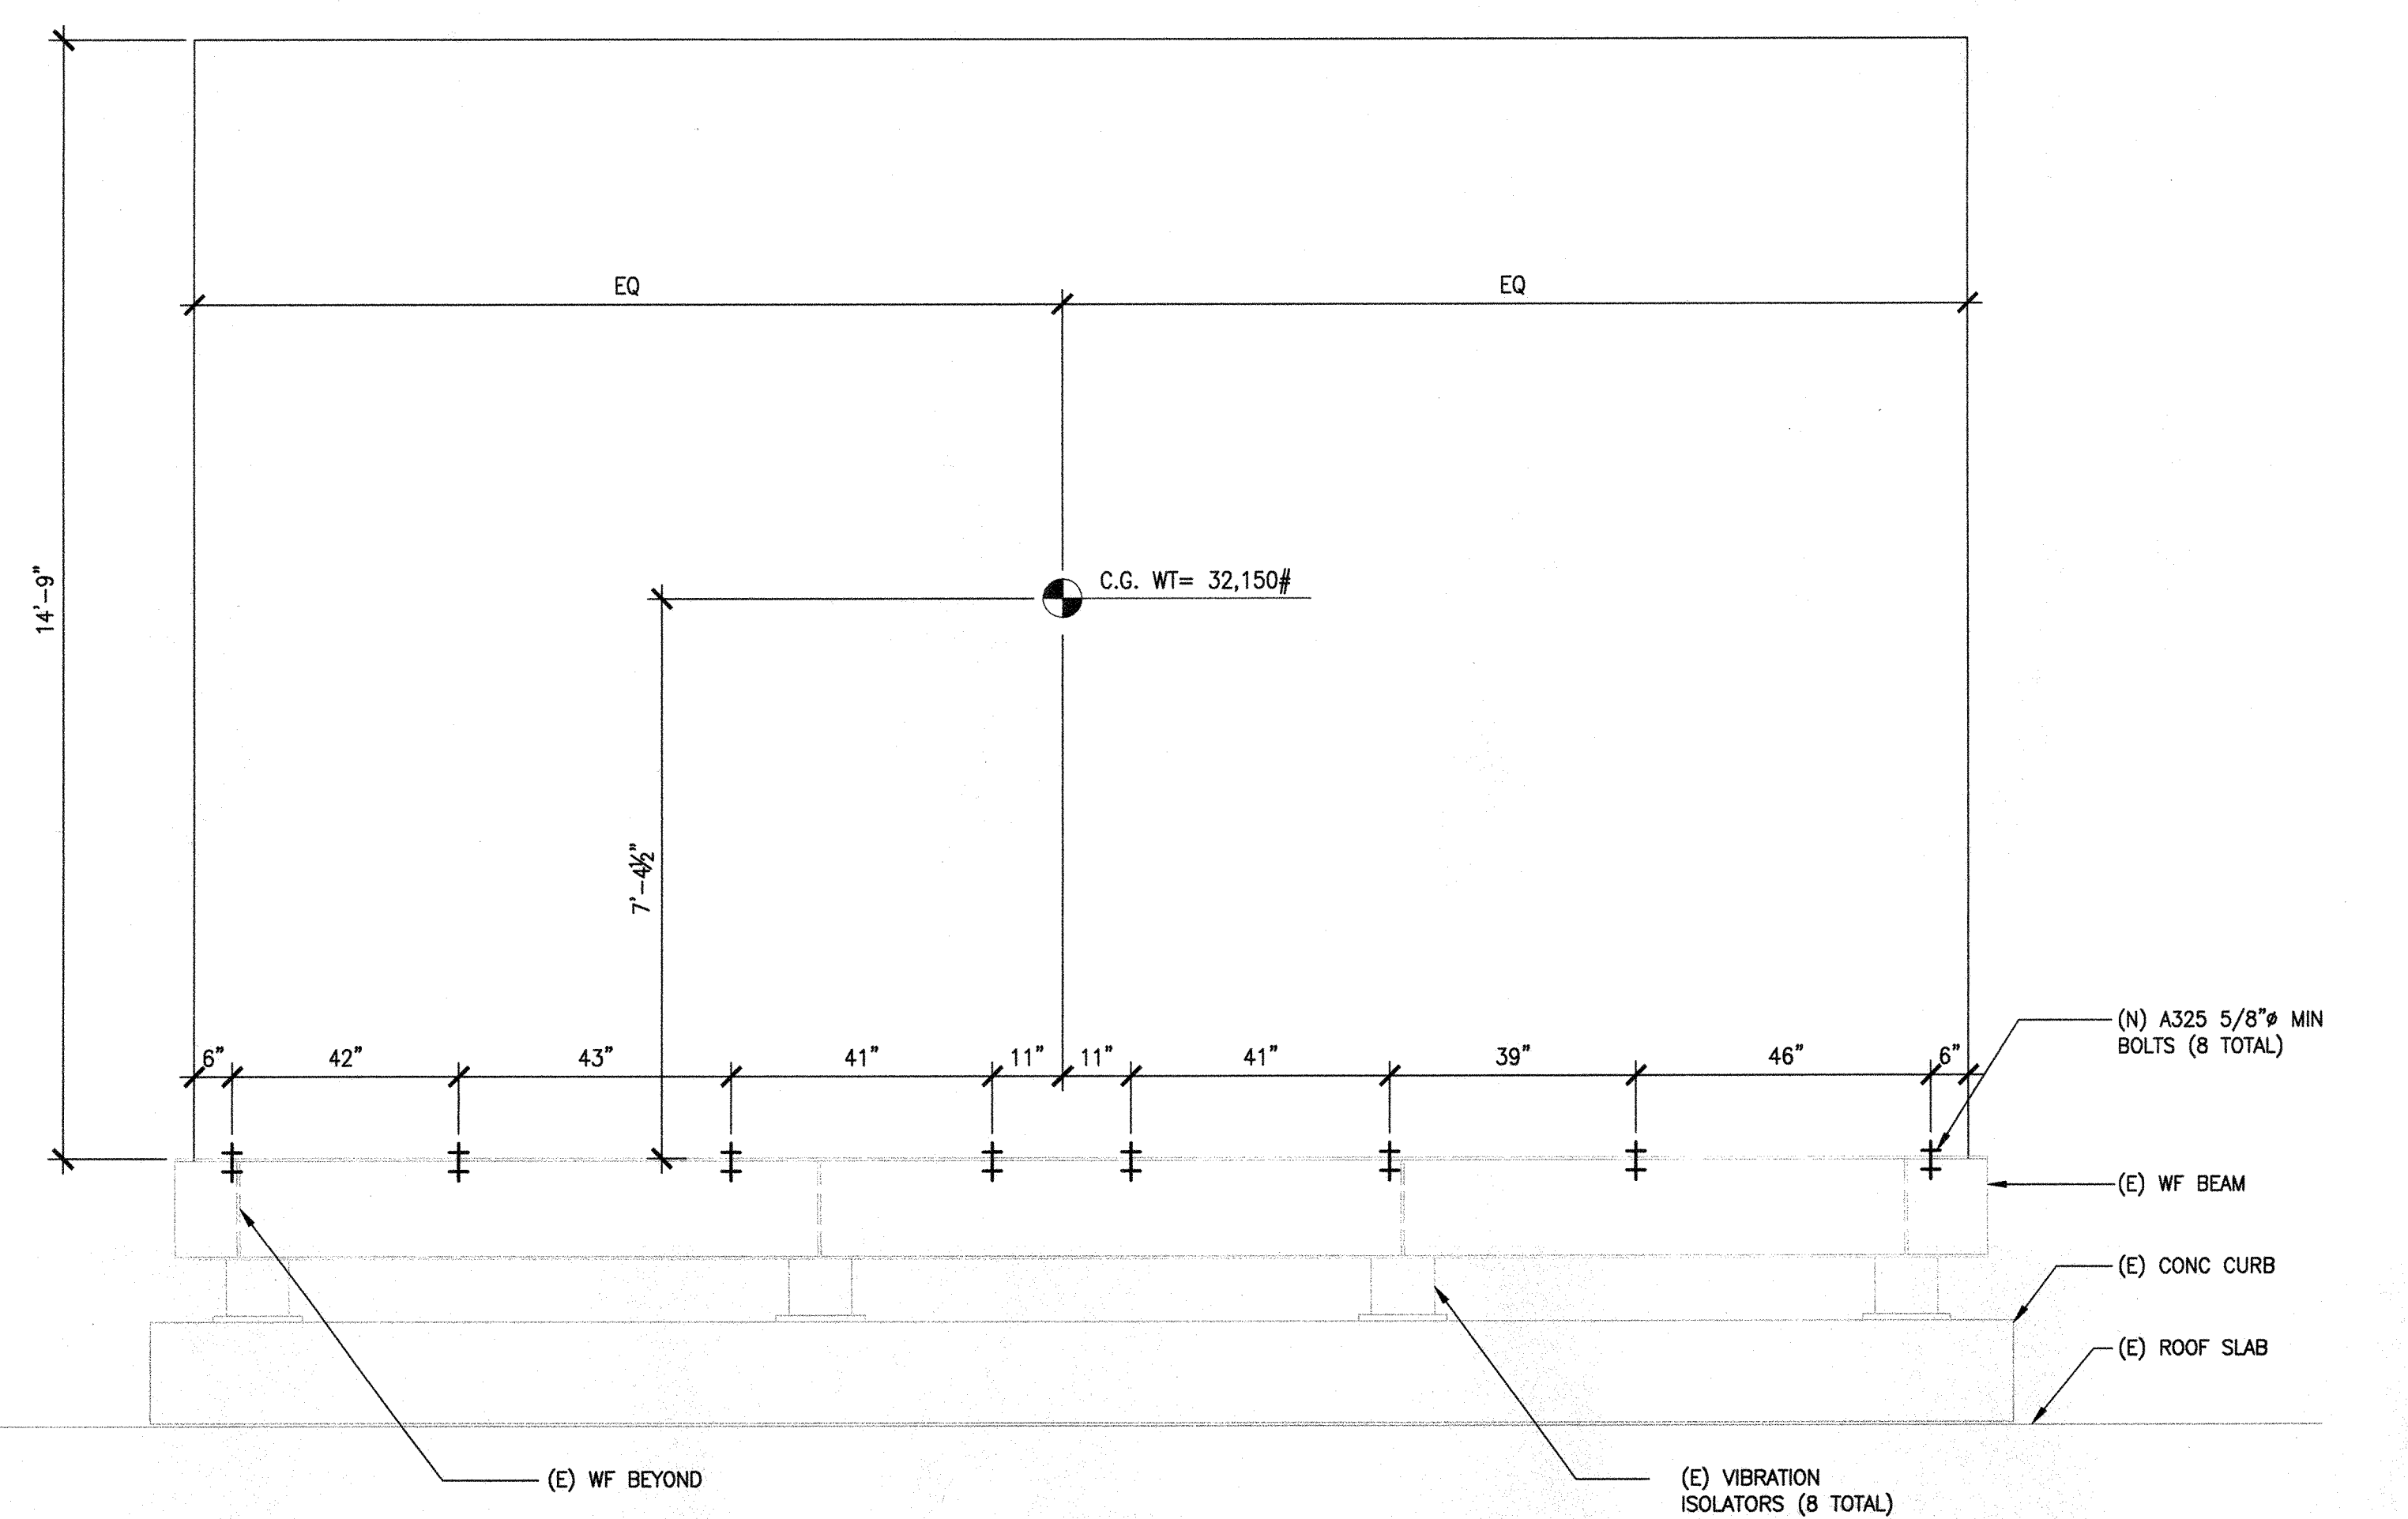


B ELEVATION
 SCALE: 1/2"=1'-0"

NOTES:
 1. ALL BOLT LAYOUT DIMENSIONS CAN BE ADJUSTED +/- 3"
 2. BOLT HOLES MAY BE SLOTTED UP TO 1/2" OR 3/4" BOLTS
 3. BOLTS TO BE GALVANIZED

VERIZON OXNARD
 1800 SOLAR DRIVE
 OXNARD, CA 93030

kpff Consulting Engineers

6080 Center Drive, Suite 300
 Los Angeles, California 90045
 (310) 665-1536 Fax (310) 665-9070

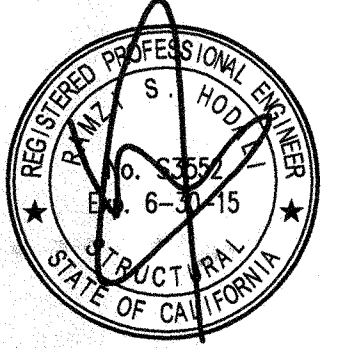

KEYPLAN

REVISIONS

NO.	DESCRIPTION	DATE

DRAWING TITLE

ROOF PLAN
 AND DETAILS

REVIEWED -

DRAWN -

ISSUE DATE

JOB NO. _____

SCALE:
 AS NOTED

DRAWING NO.

S-4

COOLING TOWER ANCHORAGE

1/2"=1'-0" 1

PERMIT

LEGACY PERMIT - COOLING TOWER

FOR INSPECTIONS CALL (805) 247-8980 - 24 HOUR ADVANCE NOTICE

Application Number 09-00002070 Date 11/21/13
 Property Address 1800 SOLAR DR
 PARCEL NUMBER 213-0-070-045
 Tenant nbr, name AC UNIT REPLACEMENT
 Application description MECH WORK ONLY, COM, IND, MULTI-RES

Owner Contractor

 GENERAL TELEPHONE CO LESSEE SWINTERTON BUILDERS
 FLAG PROPERTIES LESSOR 865 S FIGUEROA ST #3000
 ONE GTE PL RC 3521 LOS ANGELES CA 90017
 THOUSAND OAKS CA 91362 (213) 896-3400

Permit BUILDING PERMIT
 Additional desc
 Phone Access Code 1538966
 Permit Fee 46.50 Plan Check Fee 114.00
 Issue Date 11/21/13 Valuation 1000
 Expiration Date 5/20/14

Qty	Unit Charge	Per	Extension
		BASE FEE	31.75
5.00	2.9500 HND	B-\$2.95/1C (>\$750-\$3K)	14.75

Permit MECHANICAL PERMIT
 Additional desc REPLACE SAME UNIT
 Phone Access Code 1473941
 Permit Fee 46.50 Plan Check Fee 57.00
 Issue Date 11/21/13 Valuation 0
 Expiration Date 5/20/14

Qty	Unit Charge	Per	Extension
		BASE FEE	46.50

Special Notes and Comments
 REPLACE (E) COOLING TOWER UNIT W/(N) @
 SAME LOCATION USING SAME (E)
 CONNECTIONS.

Other Fees DS ADDL PLAN REVIEW CHGS 18.85
 DS STATE GREEN BLDG FEE 1.00
 DS ISSUANCE FEE 40.30
 DS IMAGING DOCUMENTS 25.50
 PL GENERAL PL MAINT. FEE 2.40
 PERMIT CTR SURCHARGE PC 14.49
 PERMIT CTR SURCHARGE 7.96
 DS SMIP/SEISMIC FEE .50
 PL PC FEE BASE FEE 100.00

Fee summary	Charged	Paid	Credited	Due
Permit Fee Total	93.00	93.00	.00	.00
Plan Check Total	171.00	171.00	.00	.00
Other Fee Total	211.00	211.00	.00	.00
Grand Total	475.00	475.00	.00	.00

NOTICE (Please check appropriate box in each paragraph)

- 1(a) I certify that I am licensed under the State Contractor's License Law and my contractor's license is in full force and effect; or
- 1(b) I certify that I am exempt from Business and Professions Code #7031.5 under: #7044 - Owner/builder, #7048 - Price of labor and materials less than \$300.
 AND
- 2(a) I certify that I have workers' compensation insurance.
 Insurer _____ Policy # _____, or a Certificate of Consent
 to self-insure by the Director of Industrial Relations; or
- 2(b) I certify that I am exempt under Labor Code #3800 because: the permit is for work of \$100 or less, or that in the performance of the work for which the permit is issued, I shall not employ any person in any manner so as to become subject to the workers' compensation laws of California.
 AND
- 3 Lender's Name _____ Address _____

I certify that I have read this application and declare under penalty of perjury that the information contained herein is true, correct and complete. I agree to comply with all city and county ordinances and state laws relating to building construction, and hereby authorize representatives of this city to enter upon the above mentioned property for inspection purposes. I am the owner of the structure listed on this permit or I represent the owner and am acting with the owner's full knowledge and consent.

Executed at City of Oxnard _____ Date _____ Owner/Contractor Authorized Signature _____

PROJECT COMPLETED DATE: *12-05-13* INSPECTOR: *Bull*

THIS PERMIT BECOMES NULL AND VOID if work or construction authorized is not commenced within 180 days from date of issuance, or work is suspended or abandoned for a period of 180 days any time after work is commenced.

INSPECTION RECORD

- FOR INSPECTIONS CALL (805) 247-8980 -
24 Hours Advance Notice Is Required For All Inspections
POST THIS CARD IN A CONSPICUOUS PLACE

Notes

IVR
CODE
NO. INSPECTION DATE INSPECTOR

DO NOT COVER UNTIL ALL APPLICABLE SPACES HAVE BEEN SIGNED

305	PLUMBING GROUNDWORK (SOIL)		
335	SEWER		
340	WATER SERVICE		
	SAMPLE WELL/GREASE INTERCEPTOR		

DO NOT PLACE CONCRETE UNTIL ALL APPLICABLE SPACES HAVE BEEN SIGNED

101	SETBACK INSPECTION: FRONT <input type="checkbox"/> SIDE <input type="checkbox"/> REAR <input type="checkbox"/>		
102	FOUNDATION		
210	UFER GROUND		

DO NOT PLACE CONCRETE UNTIL ALL APPLICABLE SPACES HAVE BEEN SIGNED

315	WATER PIPING		
215	UNDER SLAB ELECTRICAL CONDUIT		
110	SLAB: REINFORCEMENT <input type="checkbox"/> MEMBRANE <input type="checkbox"/>		
113	POUR STRIP		

DO NOT COVER UNTIL ALL APPLICABLE SPACES HAVE BEEN SIGNED

121	FLOOR NAIL		
125	ROOF NAIL		
126	ROOF TEAR OFF		
127	PRE-ROOFING		
130	PRE-WRAP EXTERIOR SHEAR PANEL NAILING		
131	SHEAR PANEL NAILING		

DO NOT COVER UNTIL ALL APPLICABLE SPACES HAVE BEEN SIGNED

	ROUGH FIRE SPRINKLER SYSTEM		
325	PLUMBING TOP OUT WATER TEST		

DO NOT COVER UNTIL ALL APPLICABLE SPACES HAVE BEEN SIGNED

140	ROUGH FRAMING <input type="checkbox"/> STEEL FRAMING <input type="checkbox"/>		
230	ROUGH ELECTRICAL		
430	ROUGH MECHANICAL		
330	ROUGH PLUMBING		

DO NOT COVER UNTIL ALL APPLICABLE SPACES HAVE BEEN SIGNED

145	INSULATION: CEILING <input type="checkbox"/> WALLS <input type="checkbox"/> ROOF <input type="checkbox"/>		
-----	---	--	--

DO NOT PLASTER UNTIL INTERIOR AND/OR EXTERIOR HAVE BEEN SIGNED

152	INTERIOR: DRYWALL <input type="checkbox"/> LATH <input type="checkbox"/>		
153	EXTERIOR: LATH <input type="checkbox"/> SIDING <input type="checkbox"/>		
345	GAS TEST: PIPING <input type="checkbox"/> SERVICE <input type="checkbox"/>		

SWIMMING POOL/SPA

510	PRE-GUNITE WITH REINFORCEMENT		
530	POOL DECK/BONDING		
515	ELECTRICAL CONDUIT		
520	GAS PIPING/TEST		
535	ENCLOSURE/ALARM (BEFORE PLASTER IS APPLIED)		
525	POOL PLUMBING SYSTEM		

MISCELLANEOUS INSPECTIONS

114	MASONRY REINFORCEMENT (BOND BEAM)		
225	T-BAR LIGHT FIXTURES/ROUGH ELECTRICAL CEILING		
156	T-BAR SUPPORT		
192	WINDOW REPLACEMENT		
	FINAL CUPA		
	FIRE SPRINKLERS FINAL		
	FIRE ALARM FINAL		
	FIRE FINAL (OTHER)		

FINAL INSPECTIONS

	FIRE FINAL (LIFE SAFETY)		
	FINAL PLANNING		
	FINAL PUBLIC WORKS		
	FINAL PARKS		
	FINAL SOURCE CONTROL		
	CITY BUSINESS LICENSES		
	BACKFLOW PREVENTION		

BUILDING CONSTRUCTION FINALS

295	FINAL ELECTRICAL (WITH POWER ON)		
395	FINAL PLUMBING		
495	FINAL MECHANICAL		
195	FINAL BUILDING		

UTILITIES CLEARANCES

265	ELECTRICAL CLEARANCE APPROVED		
385	GAS CLEARANCE APPROVED		
	PROJECT COMPLETE		


12-5-13 BVM
12-5-13 BVM

Notes section with horizontal lines for writing.

kpff Consulting Engineers

6080 Center Drive, Suite 300
Los Angeles, California 90045
310.665.1536p 310.665.9070f

STRUCTURAL CALCULATIONS
FOR
VERIZON BUILDING COOLING TOWER ANCHORAGE
1800 SOLAR DRIVE
OXNARD, CA

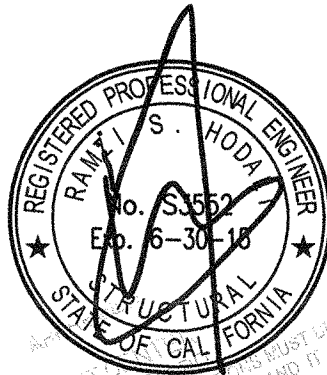

PERMIT TO EXERCISE PROFESSIONAL ENGINEERING MUST BE
CITY OF OXNARD SPECIFICATIONS AND IT IS
THIS SET OF PLANS AND SPECIFICATIONS MUST BE
KEPT ON THE JOB SITE AT ALL TIMES AND IT IS
UNLAWFUL TO MAKE ANY CHANGES OR
ALTERATIONS TO THESE PLANS WITHOUT WRITTEN
PERMISSION FROM THE PROJECT CENTER. THE
COMPLIANCE WITH THESE SPECIFICATIONS
SHALL NOT BE HELD TO PERMIT OR TO BE AN
APPROVAL OF THE VALIDATION OF ANY PROVISIONS
AND/OR CONDITIONS OF STATE LAW.

KPFF JOB # 113335

October 18, 2013

project	VERIZON WIRELESS - OXNARD	by	DLT	sheet no.	1
location	OXNARD, CA	date	9/30/13		
client	GENSLER	job no.	113335		

SEISMIC PARAMETERS

REFER TO FOLLOWING PAGE:

$$\left. \begin{aligned} S_{DS} &= 1.722g \\ S_{D1} &= 0.9739g \end{aligned} \right\} \text{PER USGS}$$

$$F_p = \frac{0.4 a_p S_{DS} W_p}{(R_p / I_p)} \left(1 + 2 \frac{z}{h} \right)$$

$$\left. \begin{aligned} a_p &= 2.5 \\ R_p &= 3.0 \\ S_{DS} &= 1.722 \\ I_p &= 1.0 \\ z/h &= 1.0 \end{aligned} \right\}$$

$$F_p = 1.722 W_p \leftarrow \text{GOVERNS}$$

$$F_{p_{MAX}} = 1.6 S_{DS} I W_p = 2.76 W_p$$

$$F_{p_{MIN}} = 0.3 S_{DS} I W_p = 0.52 W_p$$

$$F_{pv} = \pm 0.2 S_{DS} W_p = \pm 0.344 W_p$$

$$W_p = 32,150 \# \therefore$$

$$F_p = (1.722) W_p = 55,362 \#$$

$$F_{pv} = \pm 11,073 \#$$



Design Maps Summary Report

User-Specified Input


Report Title Verizon Oxnard
 Mon September 30, 2013 21:49:01 UTC

Building Code Reference Document ASCE 7-10 Standard
 (which utilizes USGS hazard data available in 2008)

Site Coordinates 34.2176°N, 119.14368°W

Site Soil Classification Site Class D - "Stiff Soil"

Risk Category I/II/III

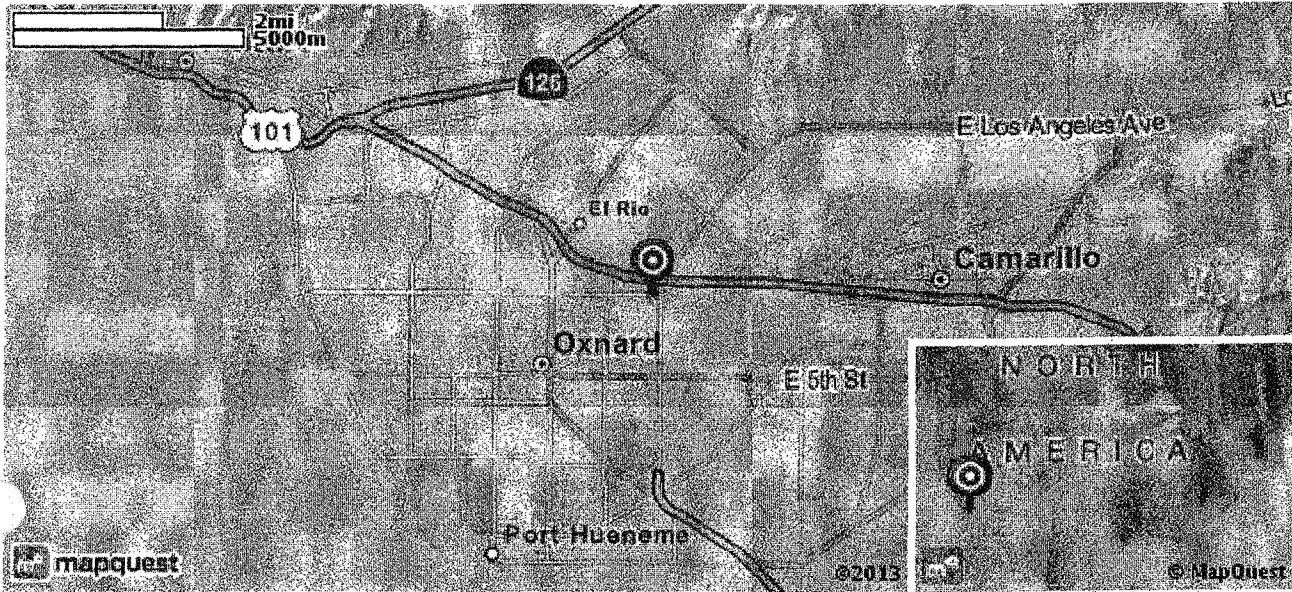


USGS-Provided Output


$S_s = 2.658 \text{ g}$	$S_{MS} = 2.658 \text{ g}$	$S_{DS} = 1.772 \text{ g}$
$S_1 = 0.973 \text{ g}$	$S_{M1} = 1.459 \text{ g}$	$S_{D1} = 0.973 \text{ g}$

For information on how the S_s and S_1 values above have been calculated from probabilistic (risk-targeted) and deterministic ground motions in the direction of maximum horizontal response, please return to the application and select the "2009 NEHRP" building code reference document.


MCE_R Response Spectrum

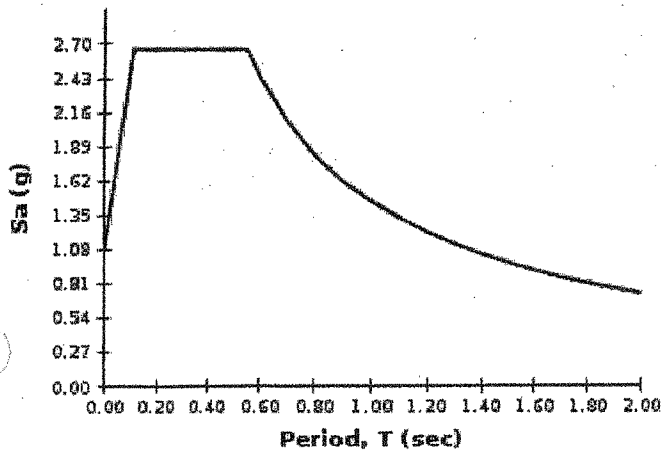

Design Response Spectrum

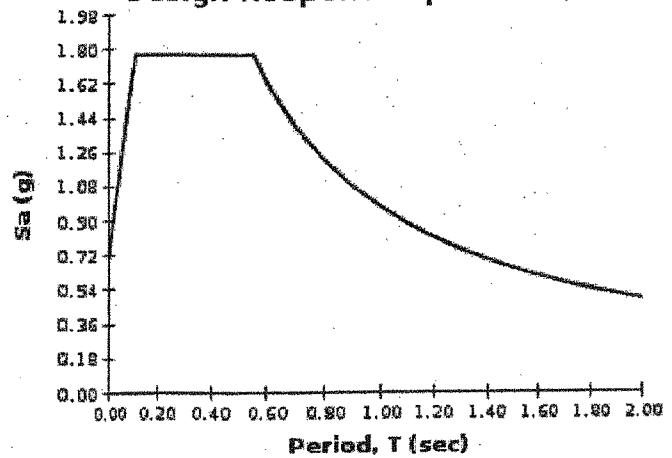

CHECK COOLING TOWER ANCHORAGE

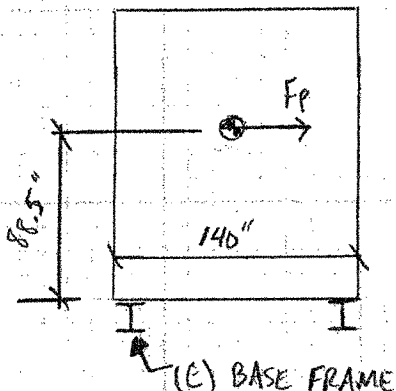

WT = 32,150 #

$F_p = 55,362 \#$

$F_v = 11,073 \#$

SHORT DIRECTION:

$M_{OUT} = (55,362) 88.5 = 4900 \text{ k}\cdot\text{IN}$

$M_{RES} = (0.9(32,150) - 11,073) \frac{140}{2} = 1250 \text{ k}\cdot\text{IN}$

TOTAL $M = 4900 - 1250 = 3650 \text{ k}\cdot\text{IN}$

\therefore T/C @ BOLTS/WELDS = $\frac{3650 \text{ k}\cdot\text{IN}}{140} = 26.1 \text{ KIPS PER SIDE}$

LONG DIRECTION: $M_{OUT} = 4900 \text{ k}\cdot\text{IN}$

$M_{RES} = (0.9(32,150) - 11,073) \frac{286}{2} = 2555 \text{ k}\cdot\text{IN}$

TOTAL $M = 4900 - 2555 = 2345 \text{ k}\cdot\text{IN}$

\therefore T/C @ QUARTER POINTS = $\frac{2345 \text{ k}\cdot\text{IN}}{(286/2)} = 16.4 \text{ KIPS PER } \frac{1}{2} \text{ SIDE}$

SHEAR: $\frac{55,362 \#}{2} = 27.7 \text{ KIPS PER SIDE}$

* TOTAL: 100+30 EFFECTS:


BOLTS: TENSION: $(\frac{26.1}{8}) 0.3 + (\frac{16.4}{4}) = 5.08 \text{ k/BOLT}$

SHEAR: $(\frac{27.7}{8}) 1.3 = 4.5 \text{ k/BOLTS}$

project	by	sheet no. 4
location	date	
client	job no.	

WELDS: LOOK @ 1/2 OF SIDE LENGTH OF WELDS:

(100+30 EFFECTS)

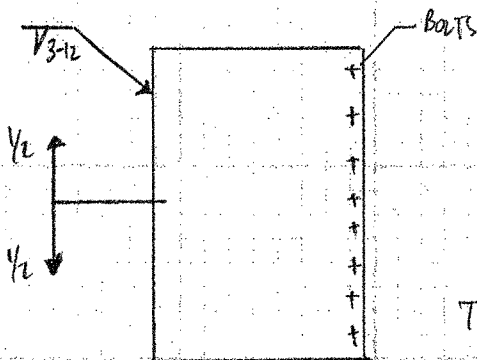

TENSION: $\left(\frac{26.1}{2}\right) 0.3 + 16.4 = 20.3 \text{ k} / \frac{1}{2} \text{ SIDE}$

SHEAR $\left(\frac{27.7}{2}\right) 1.3 = 18 \text{ k} / \frac{1}{2} \text{ SIDE}$

TOTAL LOAD @ WELD: $R = \sqrt{16.4^2 + 18^2} = \boxed{24.4 \text{ k}}$

PLAN VIEW

CHECK WELDS: $R \frac{1}{2} \text{ SIDE} = \frac{(23'-10) - 16''}{2} = 135''$

$l_{\text{WELD}} = \left(\frac{135''}{12}\right) 2 = 22''$ OF WELD.

WELD STRENGTH: 1.392 KIPS PER 1/16" THK WELD PER INCH LENGTH

TOTAL = $(22'') (1.392) 2 = 61.2 \text{ k} = \text{STRENGTH } \frac{1}{2} \text{ SIDE}$

DCR = $\frac{24.4}{61.2} = 0.40$ OK

CHECK BOLTS

COMBINED TENSION & SHEAR: PER EQ J3-2 - AISC

$\phi R_n = \phi F_{nt} A_b$

$\phi R_n = 0.75 (87.6 \text{ ksi}) (0.307 \text{ in}^2)$

$\phi R_n = 20.2 \text{ kIPS}$

$F_{nt} = 1.3 F_{nt} - \frac{F_{nt} f_c}{\phi F_{nv}}$

$= 1.3 (90 \text{ ksi}) - \frac{90}{(0.75) 60} (14.7)$

$F_{nt} = 87.6 \text{ ksi}$

$f_v = \frac{4.5 \text{ k}}{0.307 \text{ in}^2} = 14.7 \text{ ksi}$

DCR = $\frac{5.08}{20.2} = 0.25$ OK